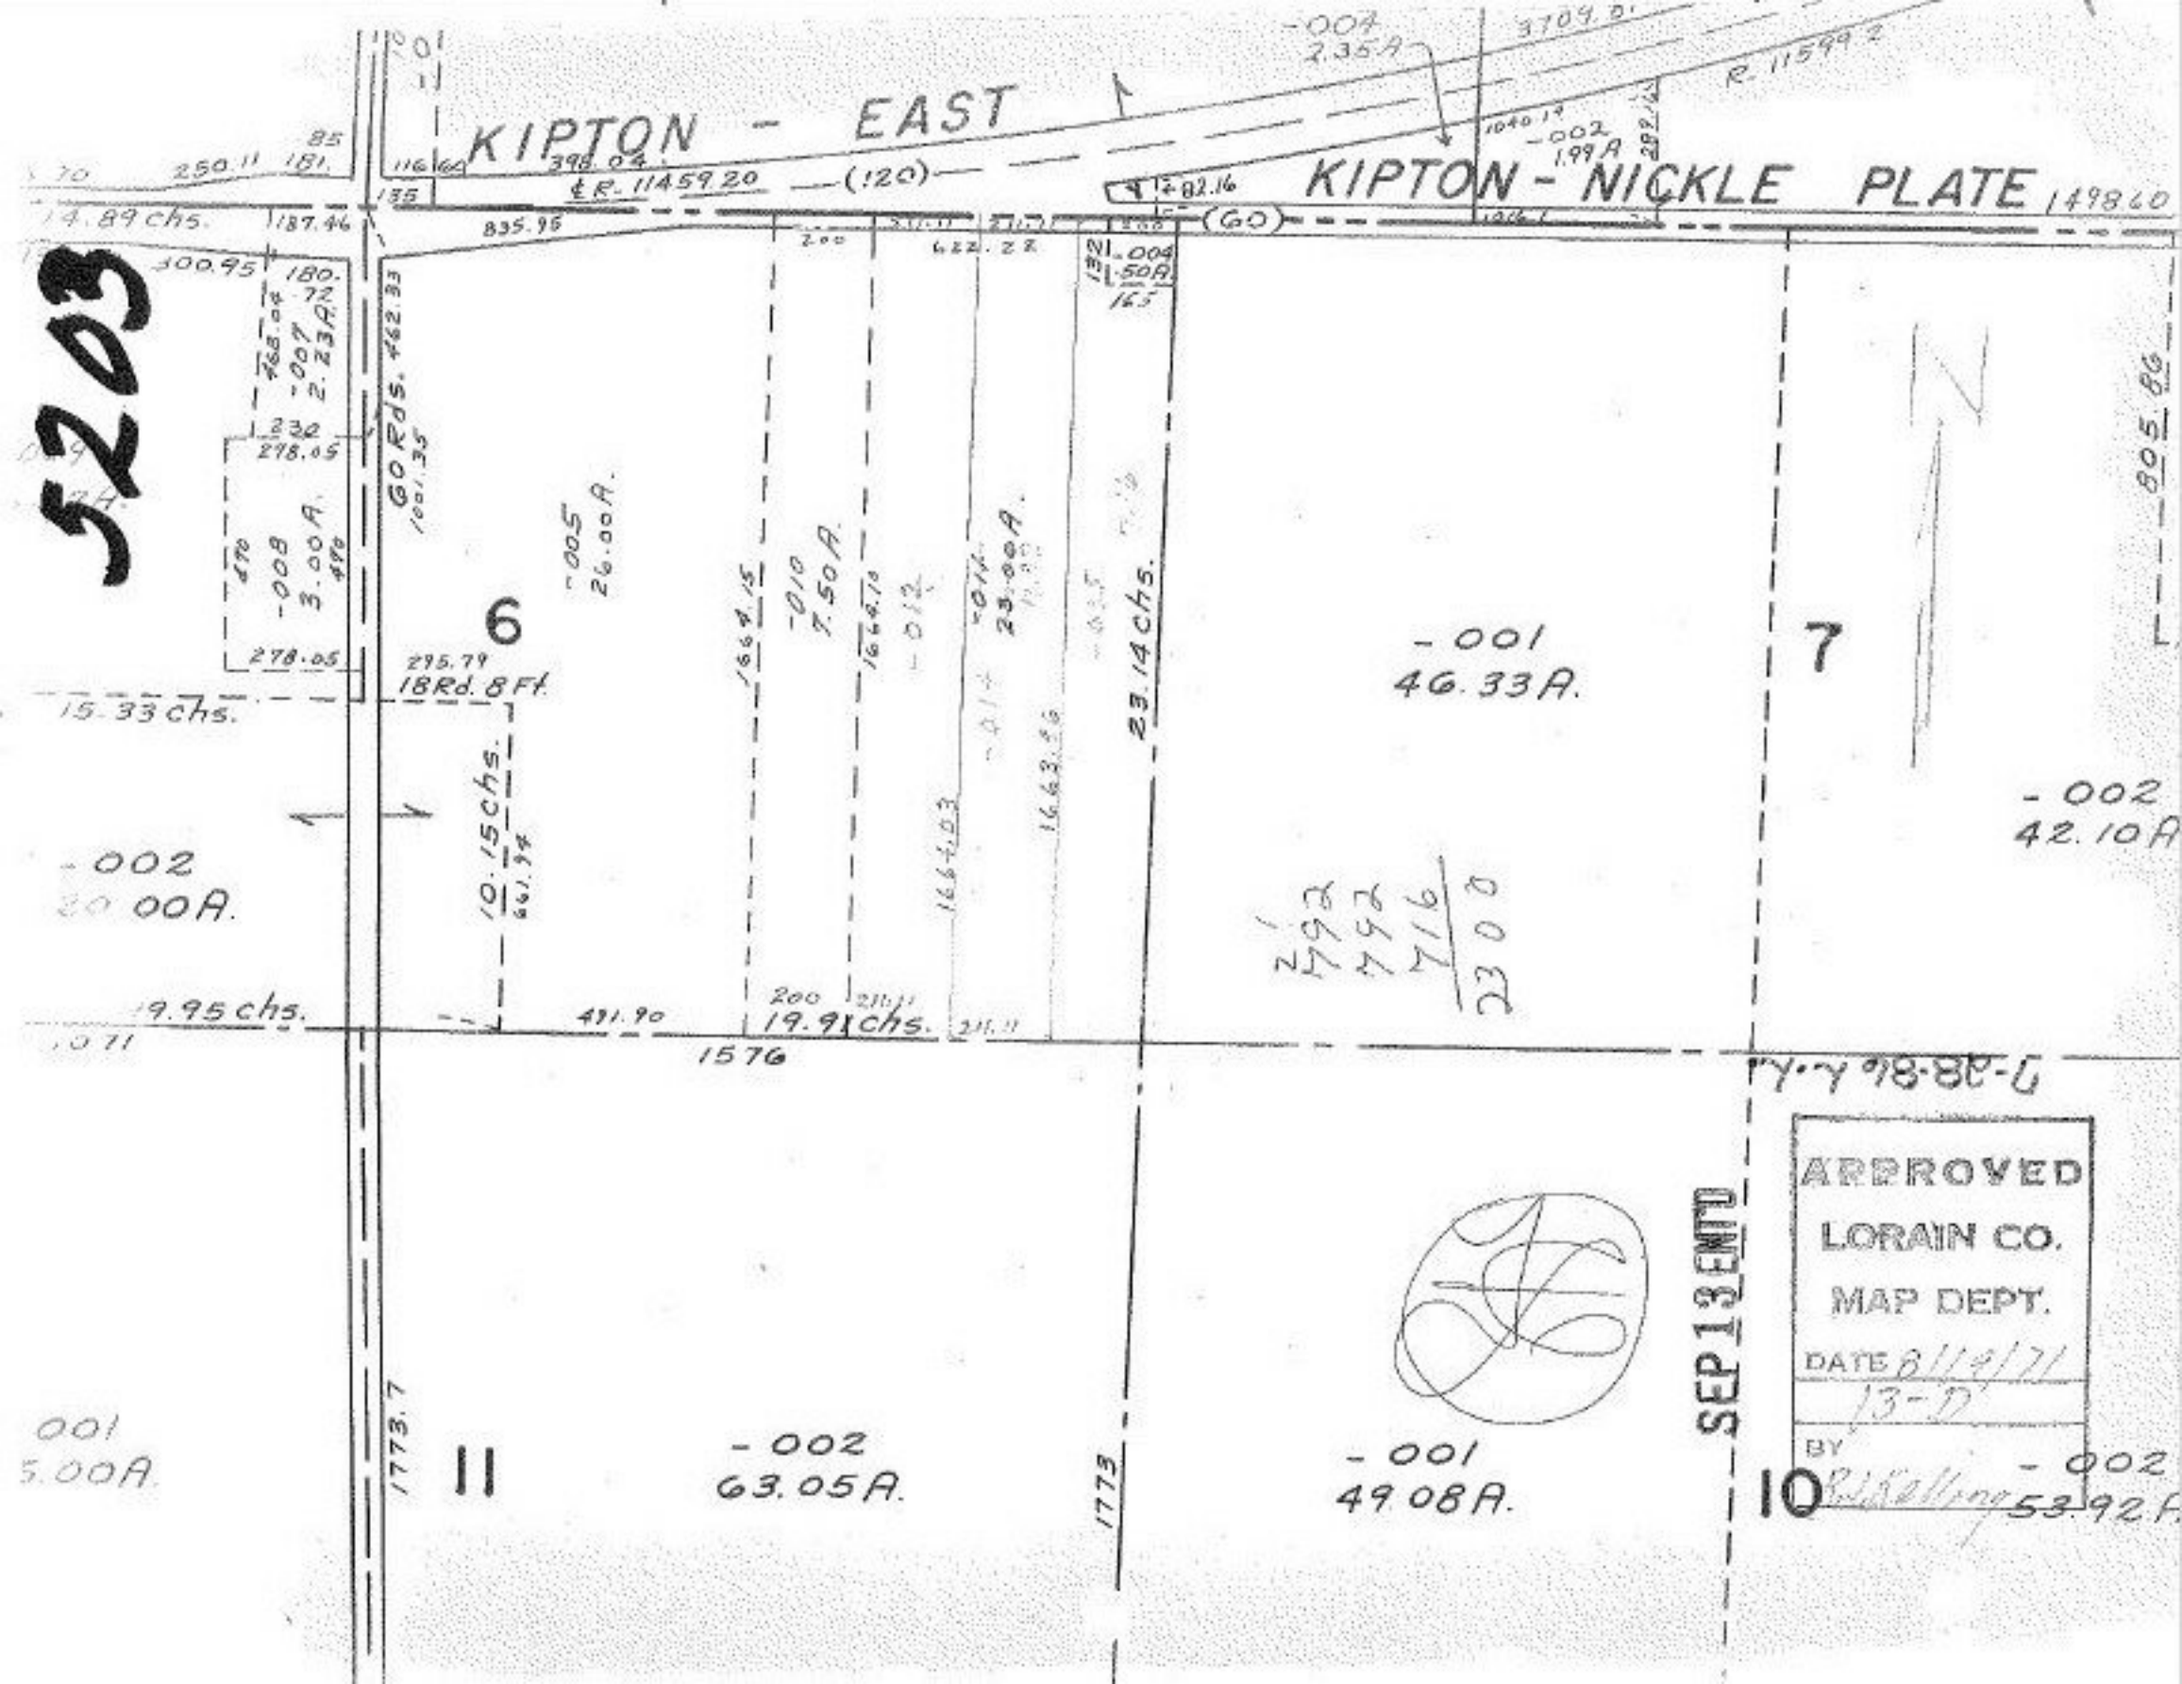
5203
KIPTON - EAST
KIPTON - NICKLE PLATE
398.04
℄ R. 11459.20
(120)
(60)
835.95
60 Rds. 462.33
100'.35'
18 Rd. 8 Ft.
295.79
15.33 chs.
19.95 chs.
19.91 chs.
23.14 chs.
10.15 chs.
431.90
1576
1773.7
1773
-001
46.33A.
-002
42.10A
-002
20.00A.
-002
63.05A.
-001
49.08A.
-002
53.92A.
-001
5.00A.
-005
26.00A.
-010
7.50A.
-012
-014
23.00A.
-007
2.23A
-004
2.35A
-002
1.99A
-004
1.50A
6
7
10
11
SEP 13 ENTD
APPROVED
LORAIN CO.
MAP DEPT.
DATE 8/19/71
13-D
BY