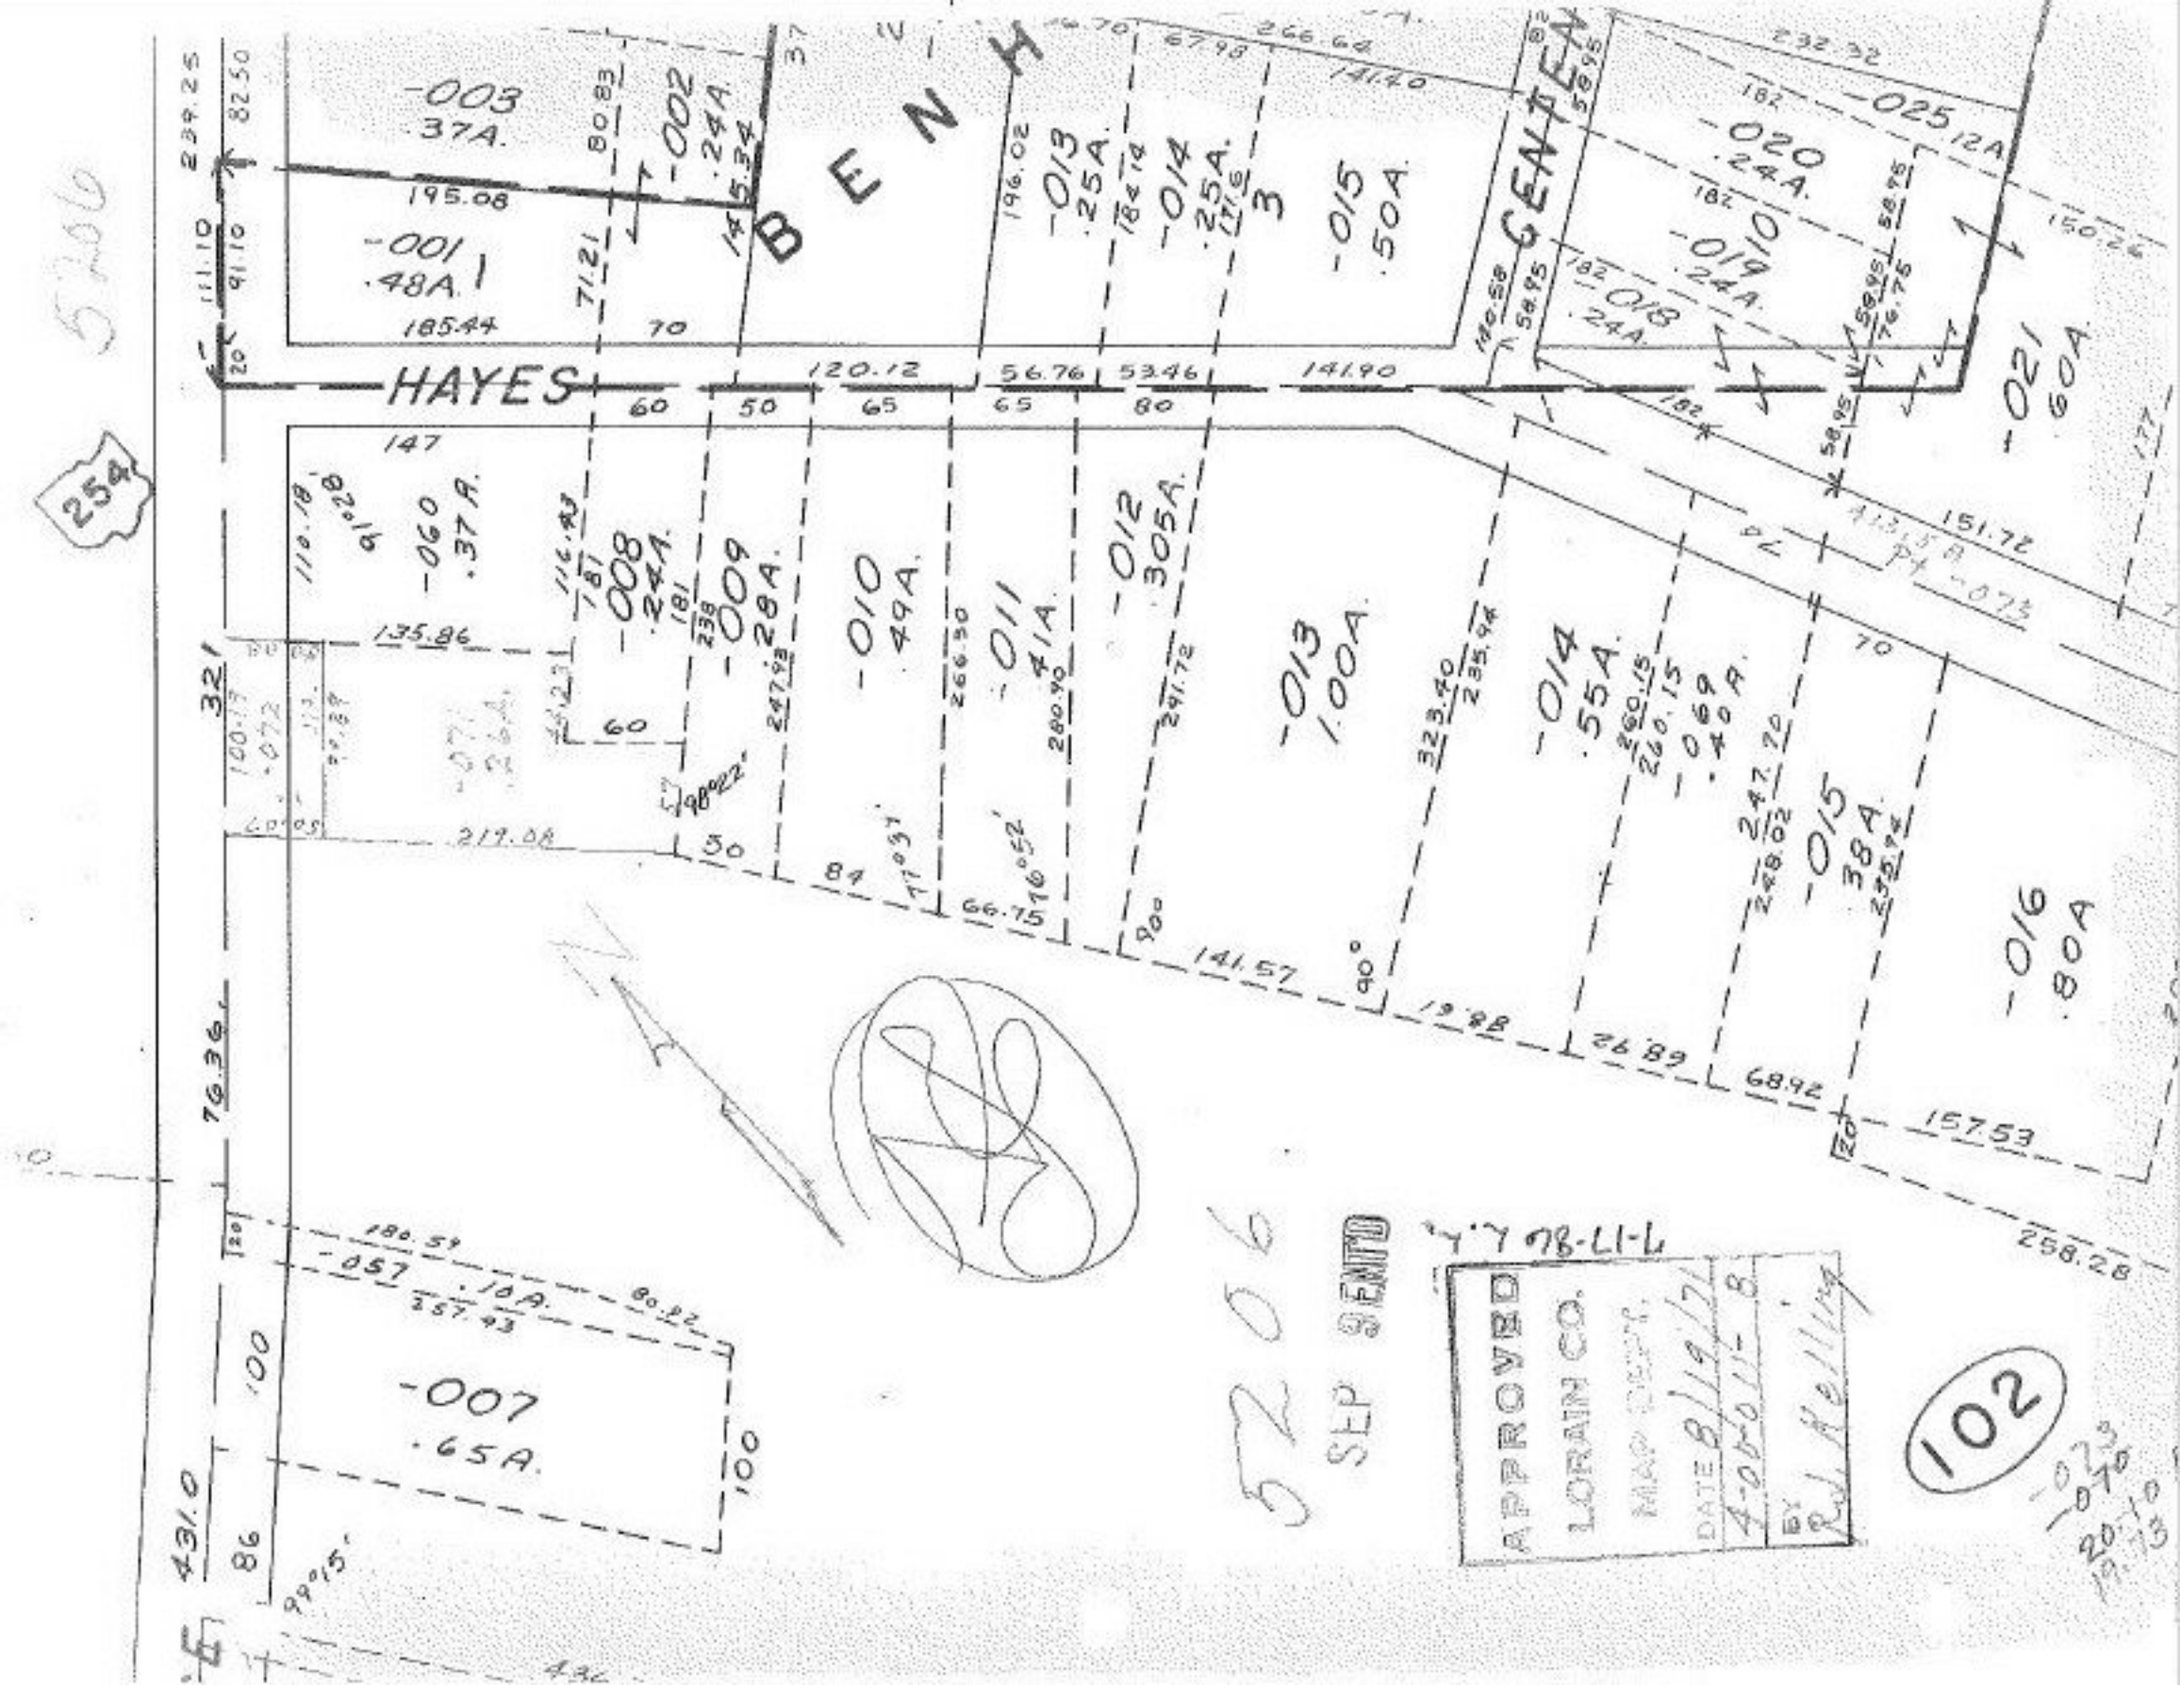

HAYES
BENH
CENTER
-003 .37A.
-002 .24A.
-001 .48A.
-013 .25A.
-014 .25A.
-015 .50A.
-020 .24A.
-019 .24A.
-018 .24A.
-025 .12A.
-021 .60A.
-060 .37A.
-008 .24A.
-009 .28A.
-010 .49A.
-011 .41A.
-012 .305A.
-013 1.00A.
-014 .55A.
-069 .40A.
-015 .38A.
-016 .80A.
-007 .65A.
254
5206
SEP 9 ENTD
APPROVED
LORAIN CO.
MAP DEPT.
DATE 8/19/71
4-06-011-8
BY
102