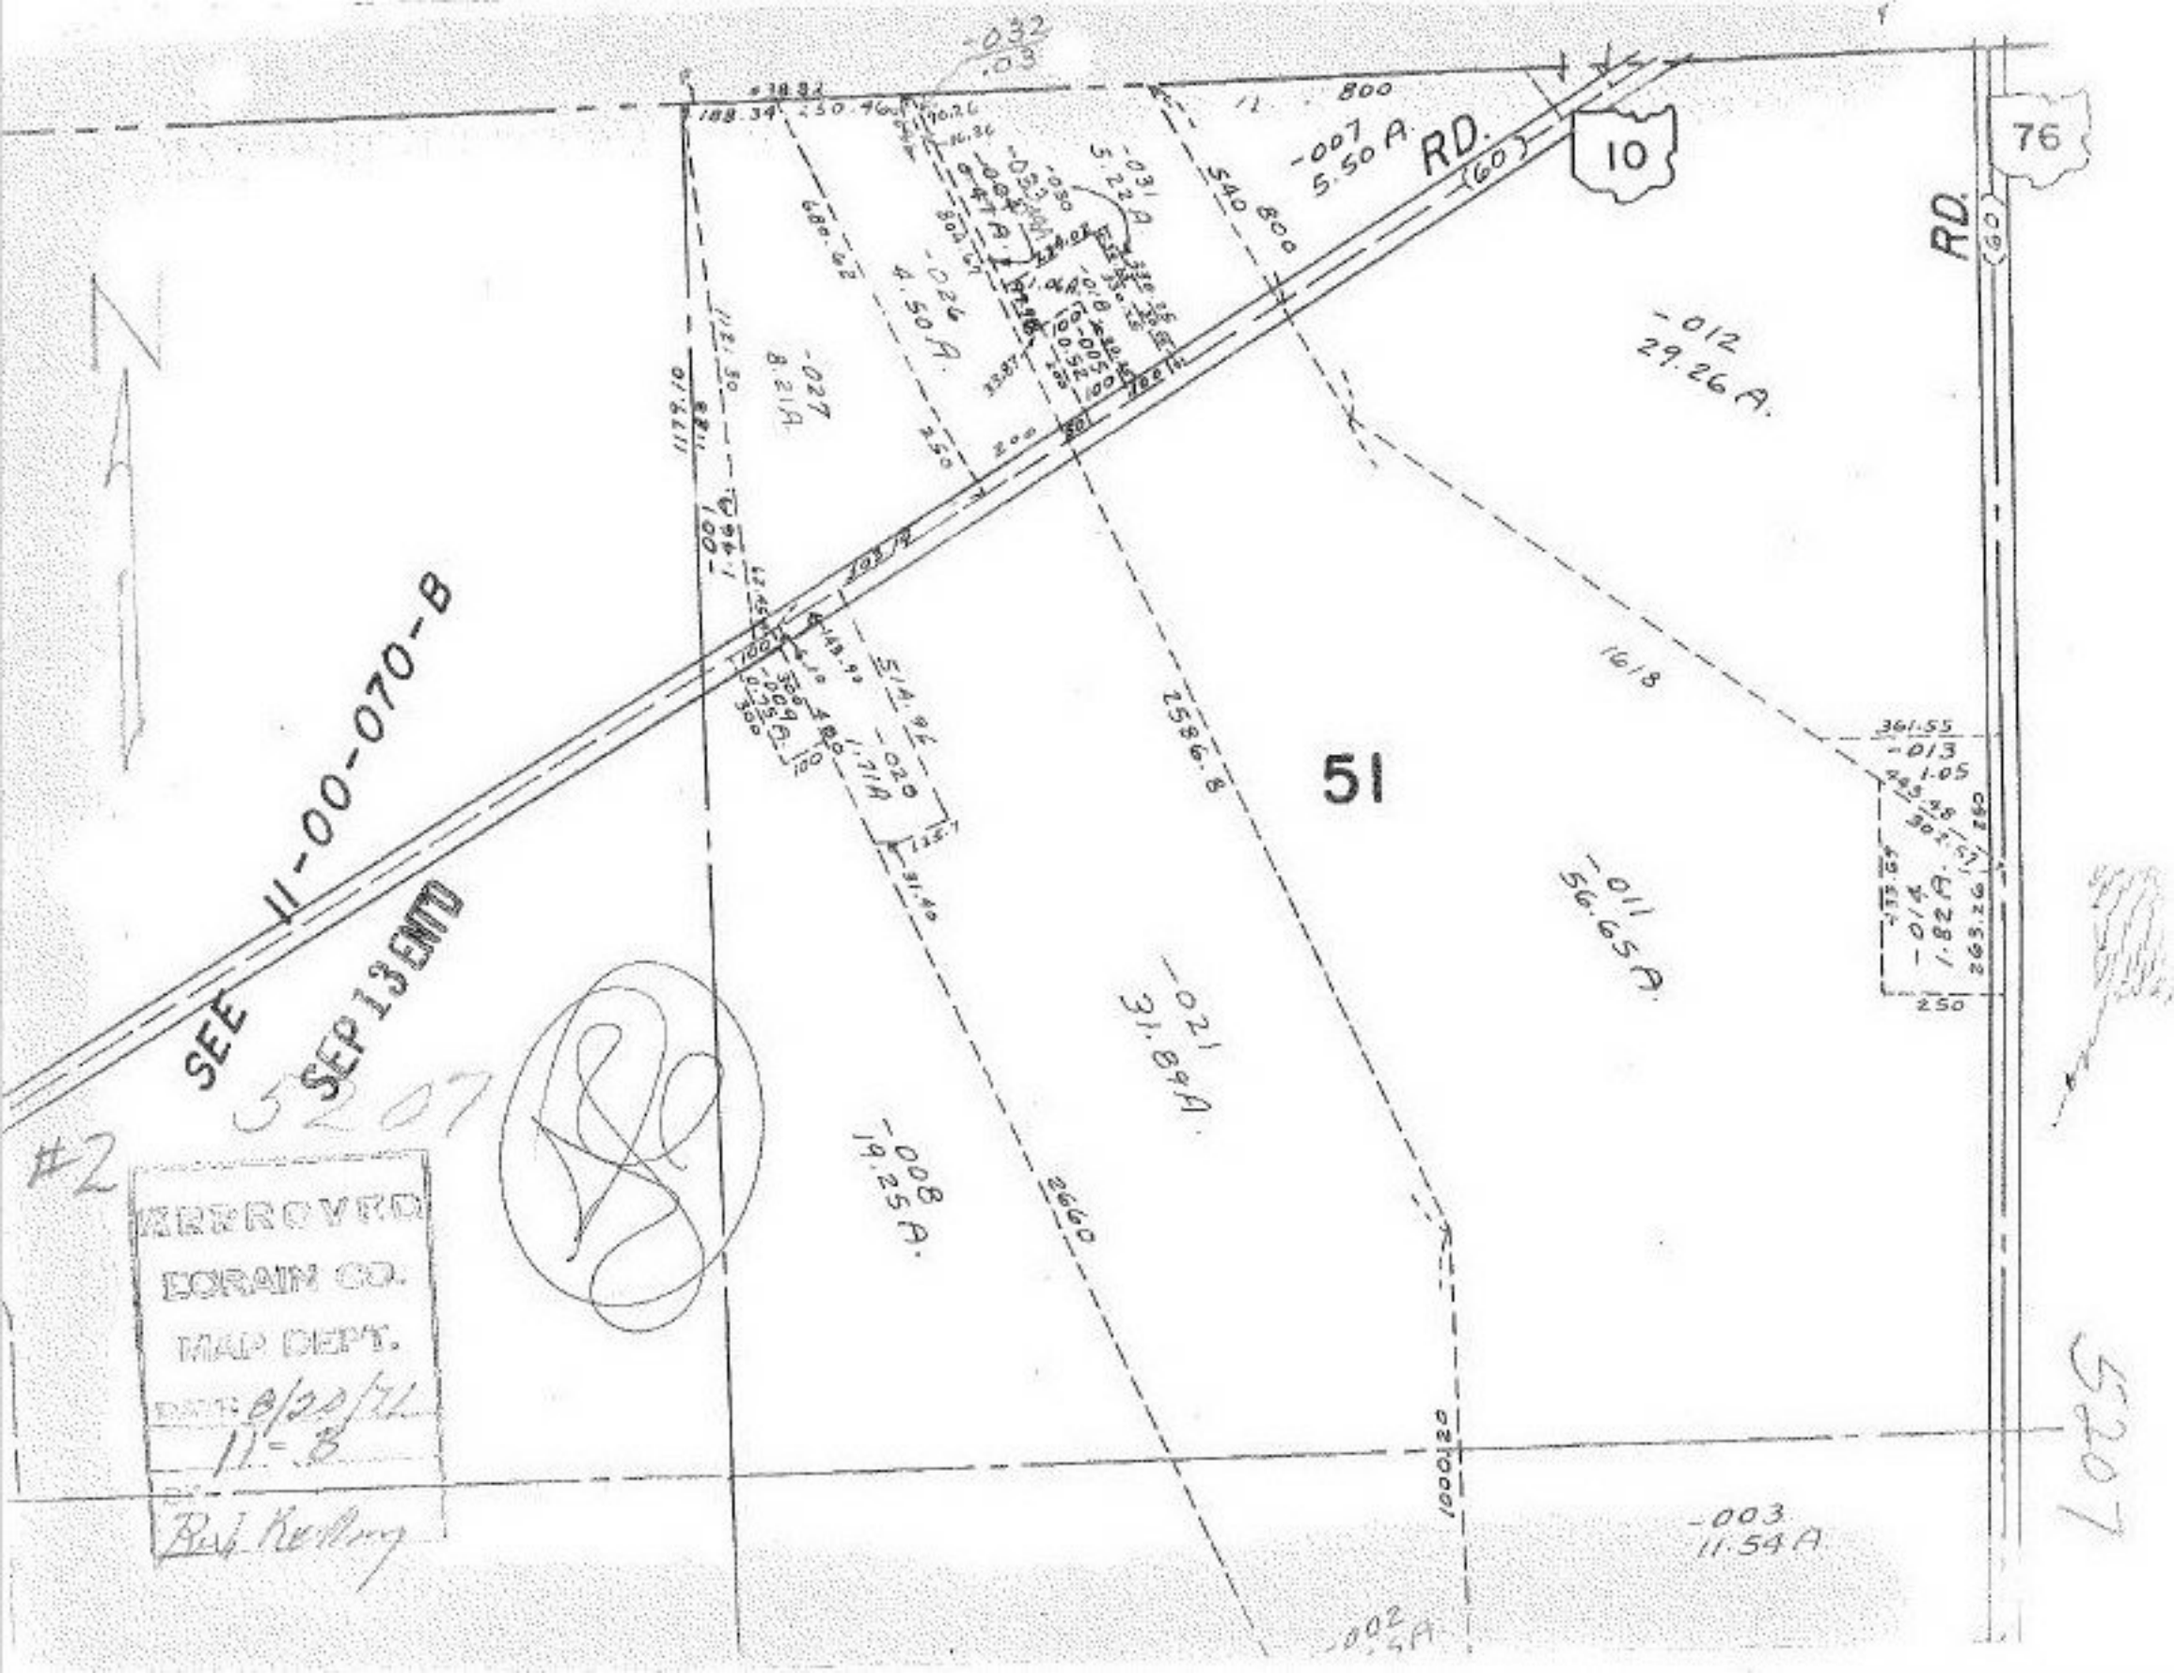
RD.
10
76
RD.
-007
5.50 A.
-031
5.22 A.
-026
4.50 A.
-027
8.21A.
-012
29.26 A.
-001
-020
1.71A
-021
31.89A.
-008
19.25 A.
-011
56.65A.
-013
1.82A.
-010
4.4
-003
11.54 A.
-002
5A
SEE 11-00-070-B
SEP 13 ENTD
51
2586.8
2660
540
800
1618
APPROVED
LORAIN CO.
MAP DEPT.
DATE 8/25/72
1" = 3'
Rud Kerling