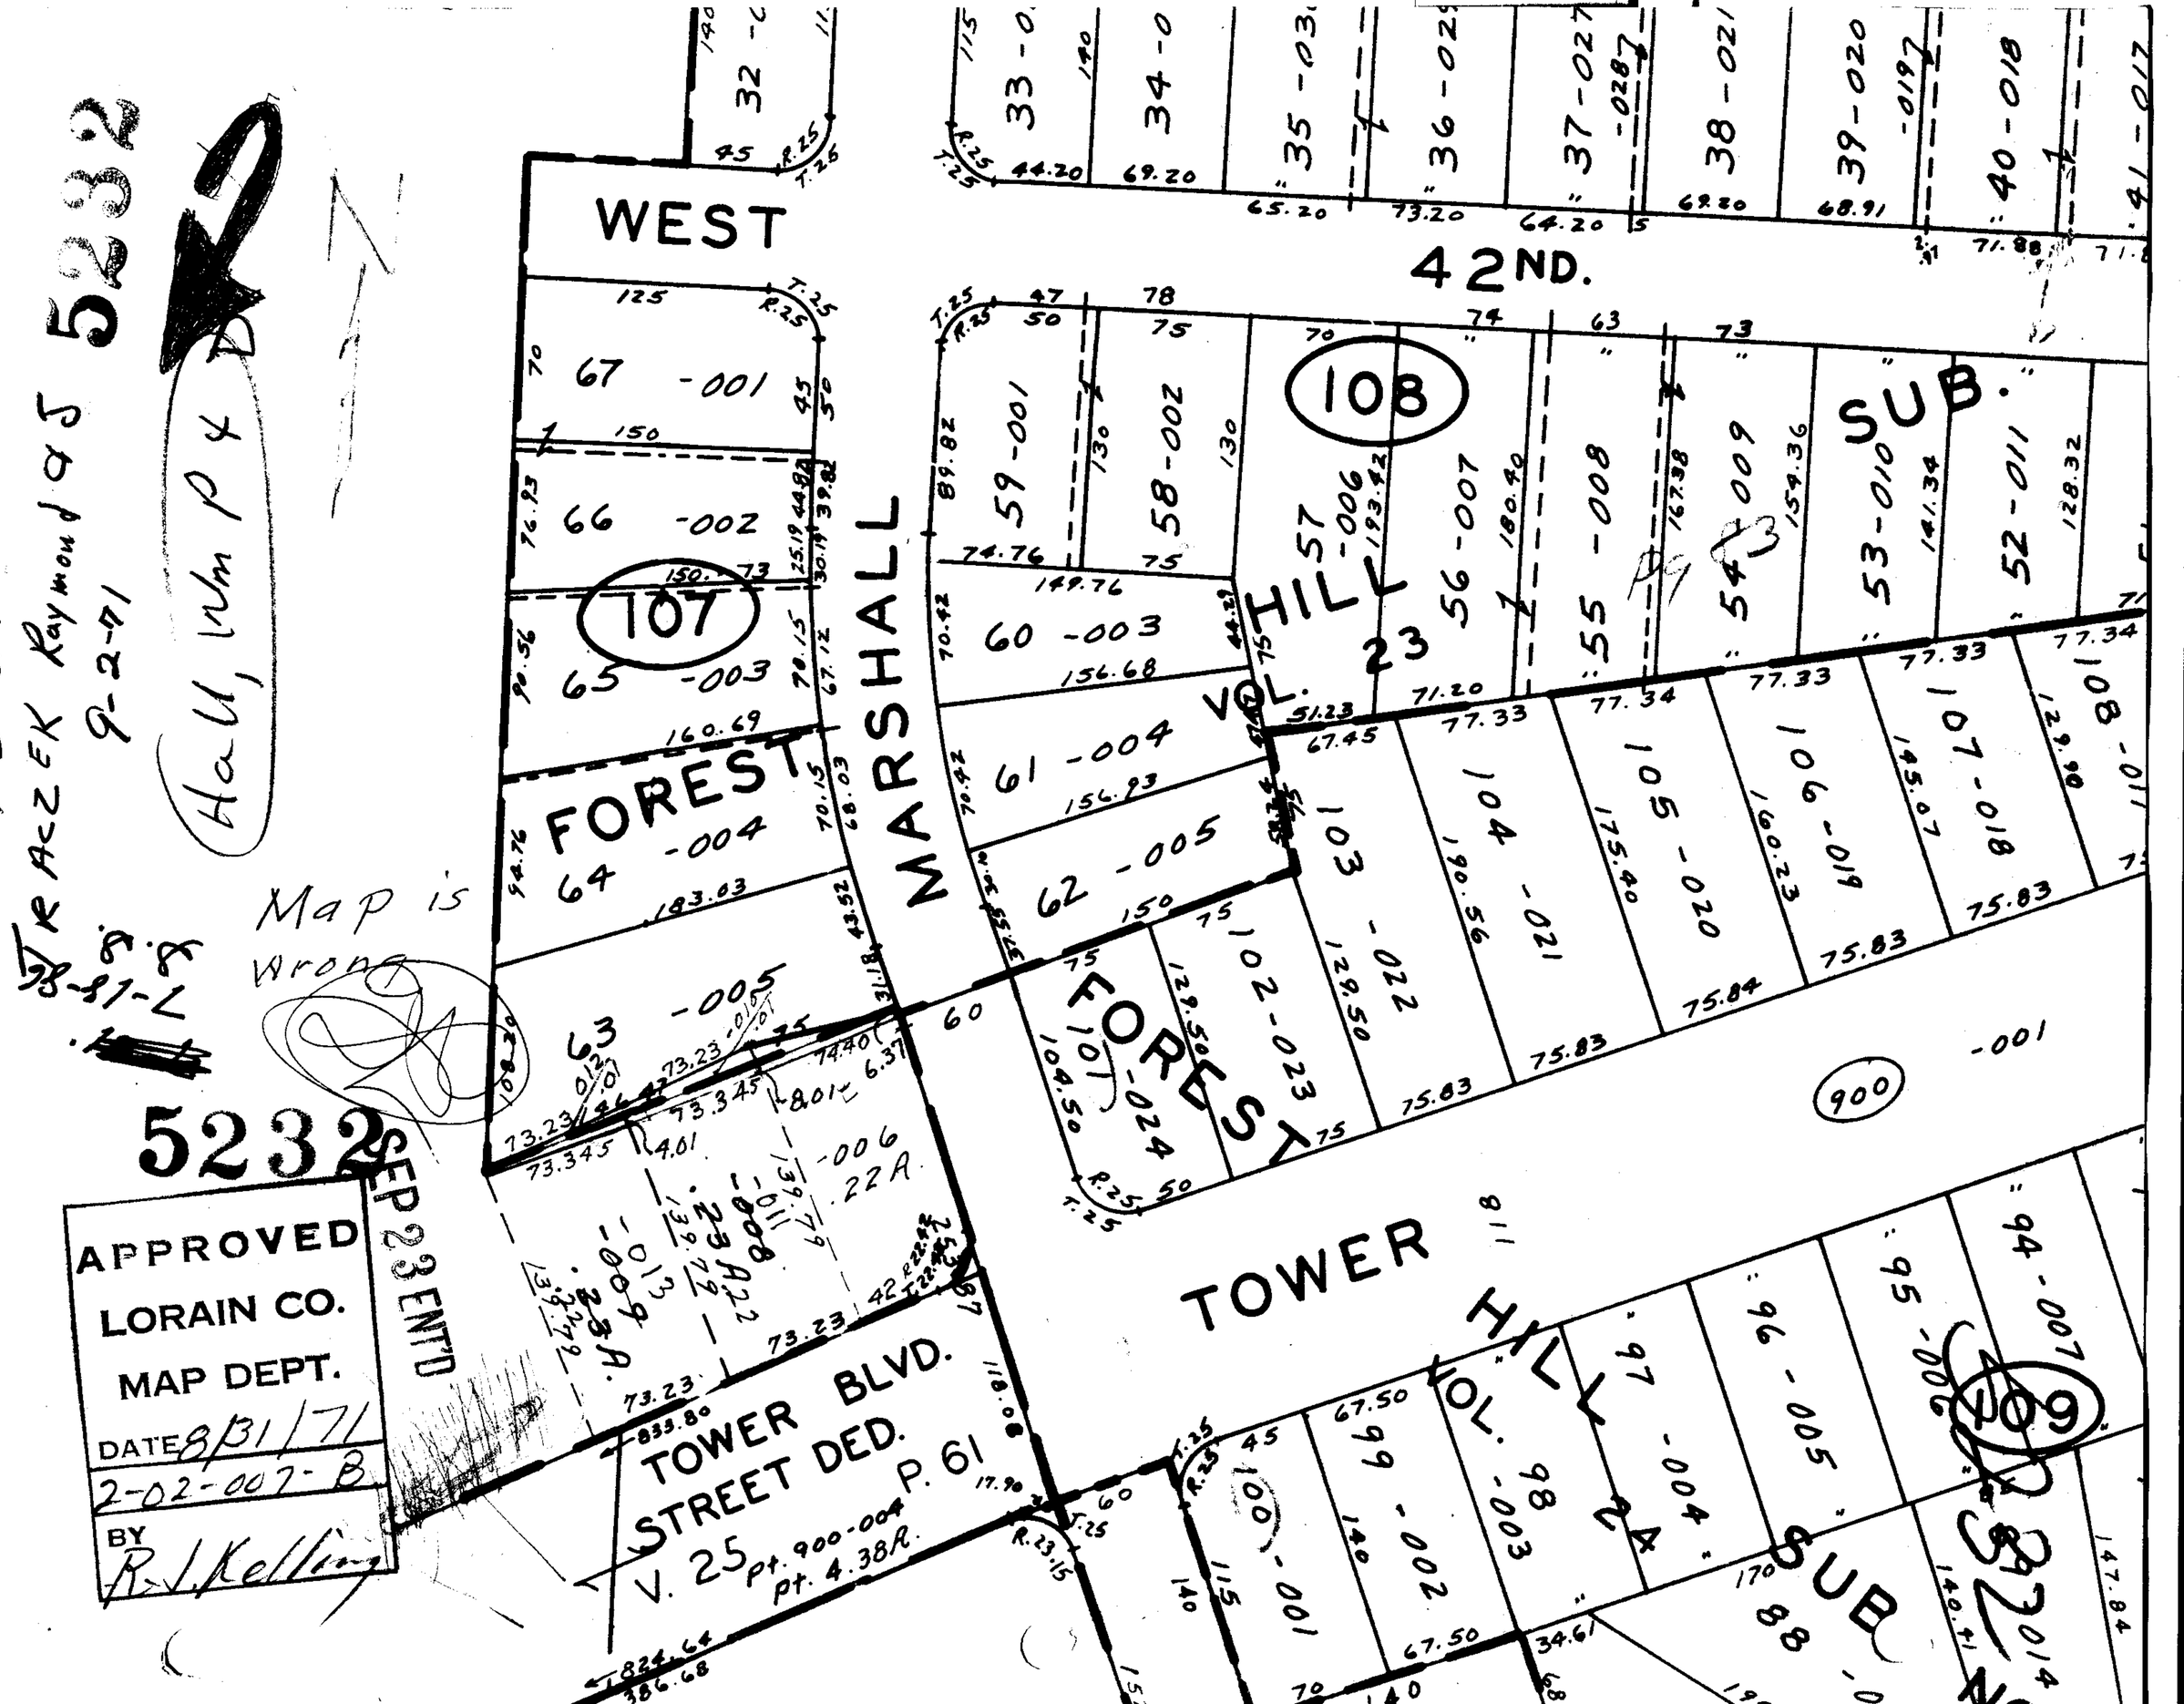

WEST
42ND.
MARSHALL
FOREST
HILL
VOL. 23
SUB.
TOWER
HILL
VOL. 24
SUB
TOWER BLVD.
STREET DED.
V. 25 P. 61
Pt. 900-004
Pt. 4.38A.
107
108
109
900
5232
APPROVED
LORAIN CO.
MAP DEPT.
DATE 8/31/71
2-02-007-B
BY R. J. Kelling
SEP 23 ENT'D
Map is Wrong
Hall, Wm P & D
1031-817
Jr Aczek Raymond & J
9-2-71