


Pt. - 004  
Pt. 5.58A.

198° 51'  
27.35  
52333

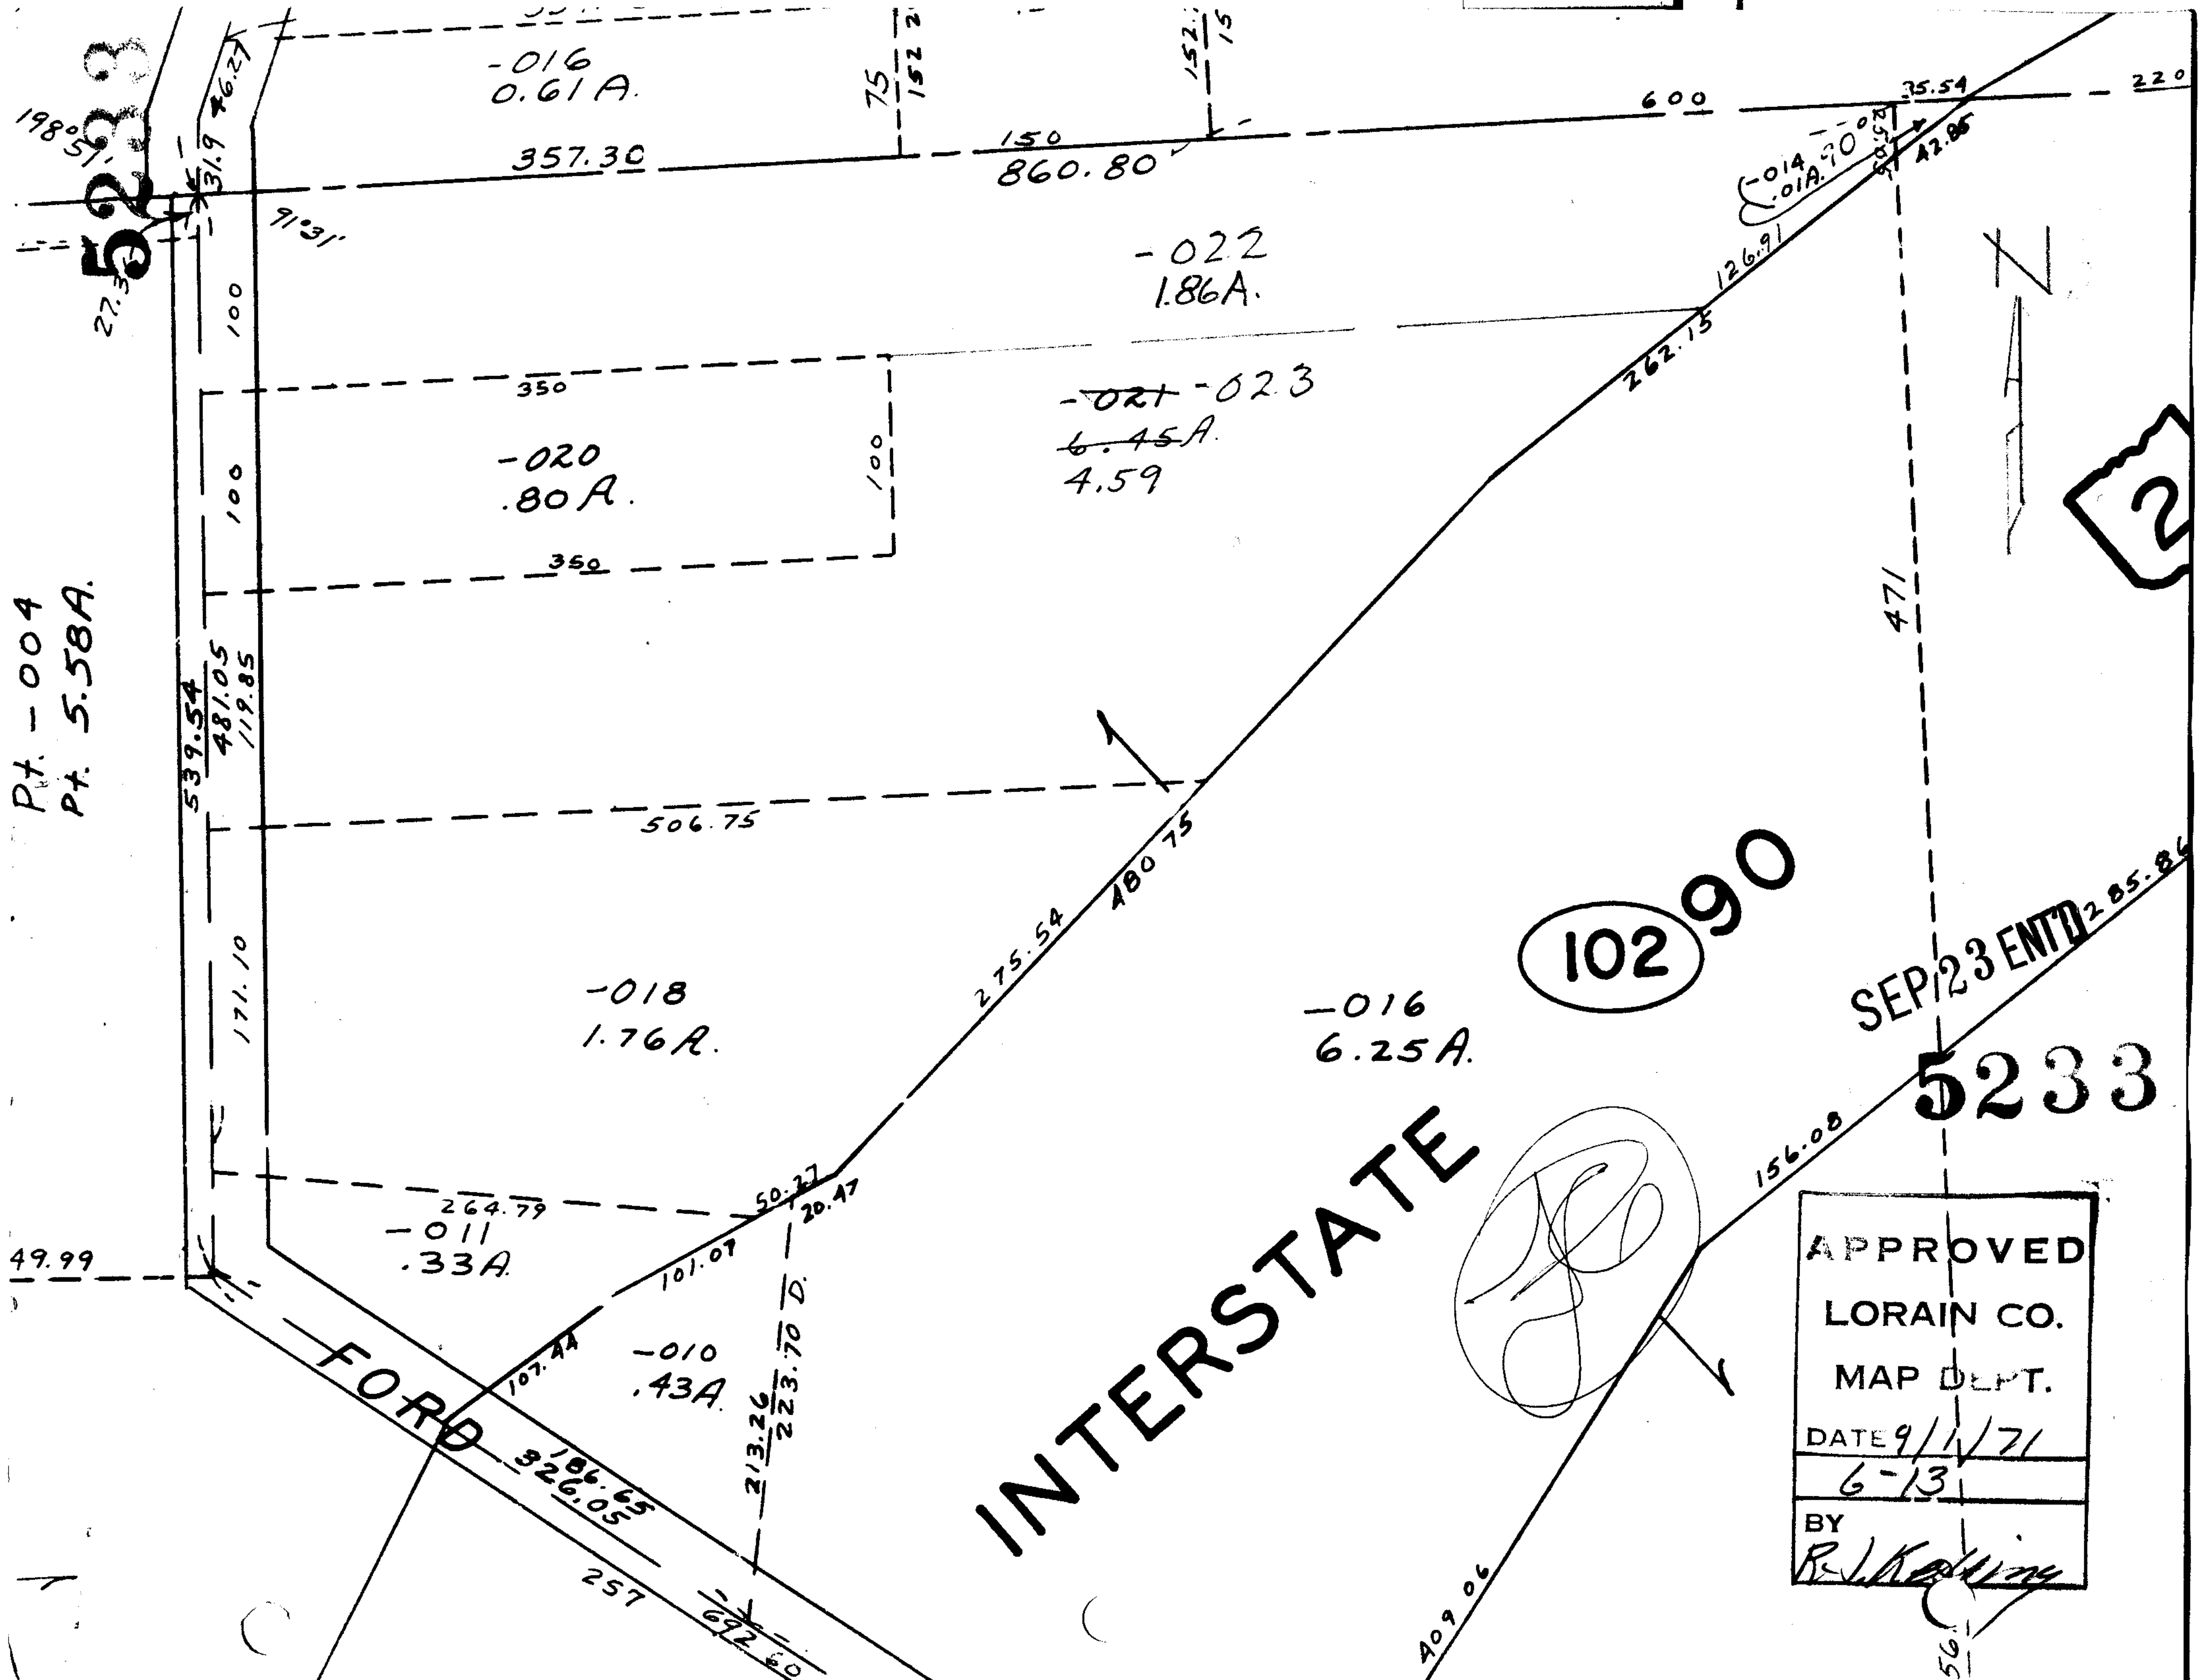

10290

SEP 23 ENT 2 85-86

52333

APPROVED  
LORAIN CO.  
MAP DEPT.  
DATE 9/1/71  
6-13  
BY  
R. J. [Signature]

INTERSTATE

FORD