


05-00-037-111-001  
only Bldg. on 337, etc.)

# FRANKLIN

5238

ADD  
VAC

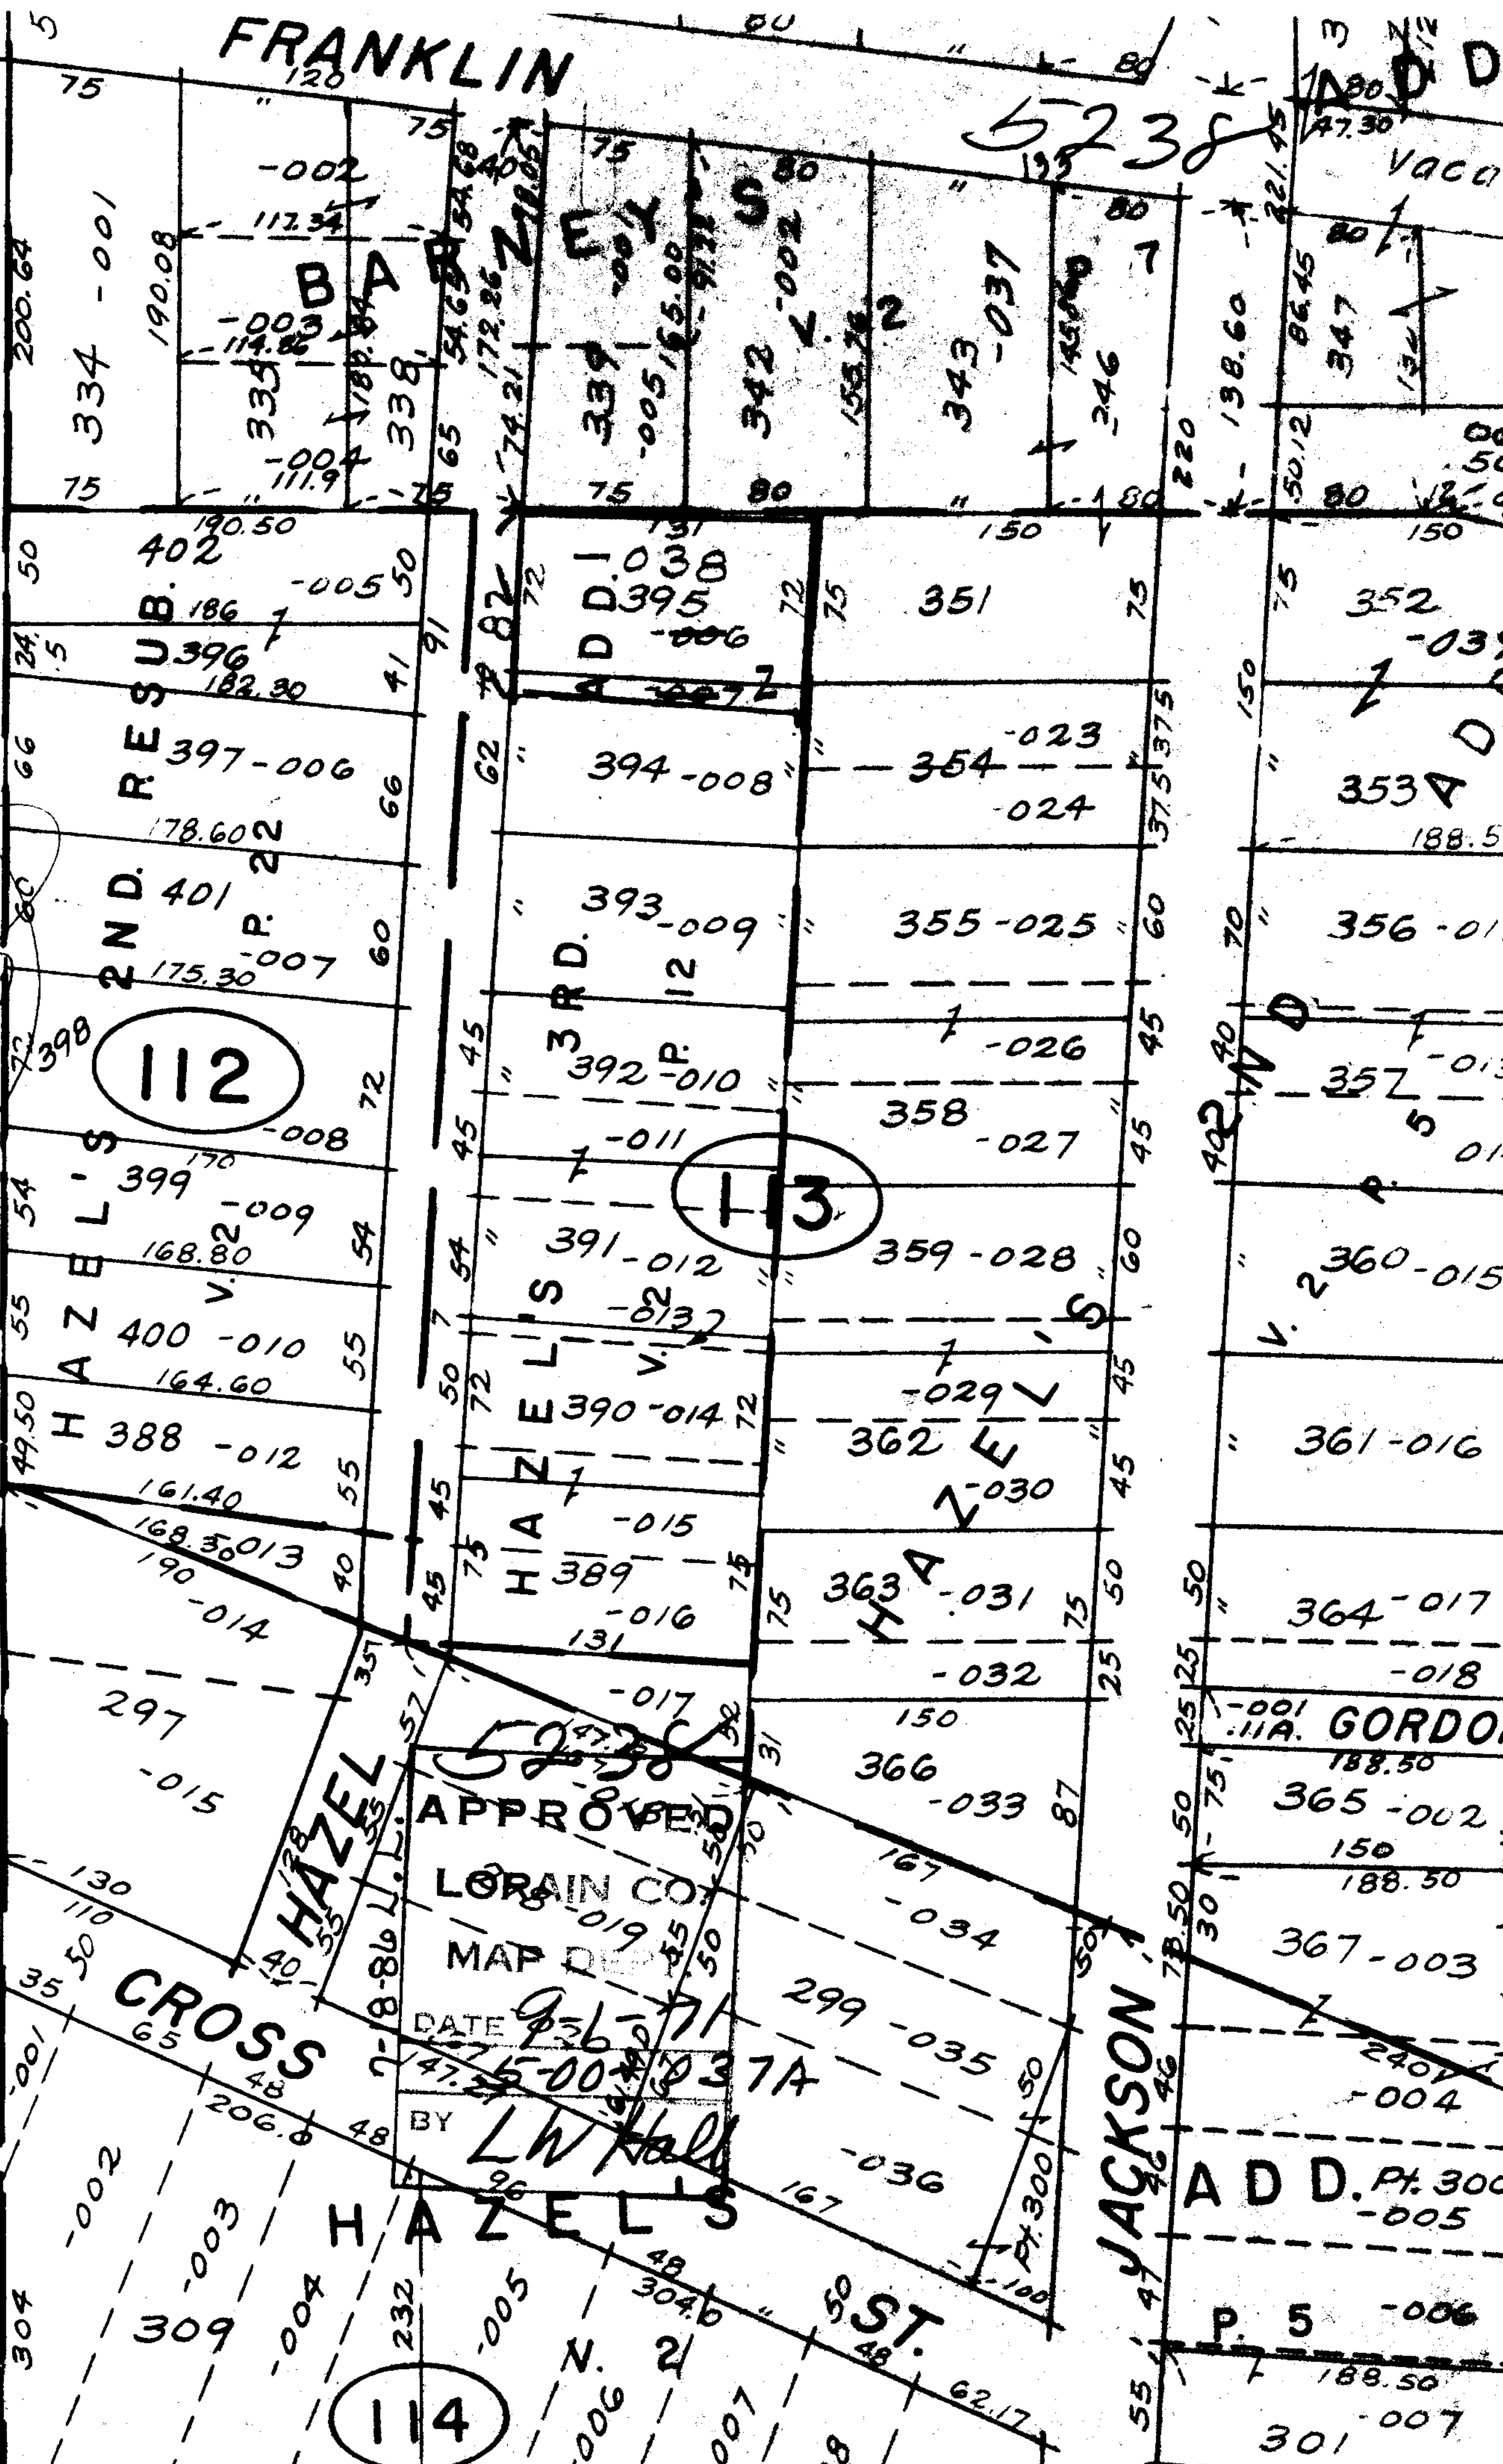

SEP 23 ENT'D

5-00-037A

APPROVED

LORAIN CO.

MAP DEPT.

DATE 9-26-71

BY LW Hall

114

113

112

GORDON

ADD. Pt. 300

P. 5

301

HAZEL

JACKSON

ST.

CROSS

HAZEL'S

HAZEL'S

304

309

334

335

338

339

342

343

346

351

352

353

356

357

358

359

360

361

362

363

366

367

