


5238

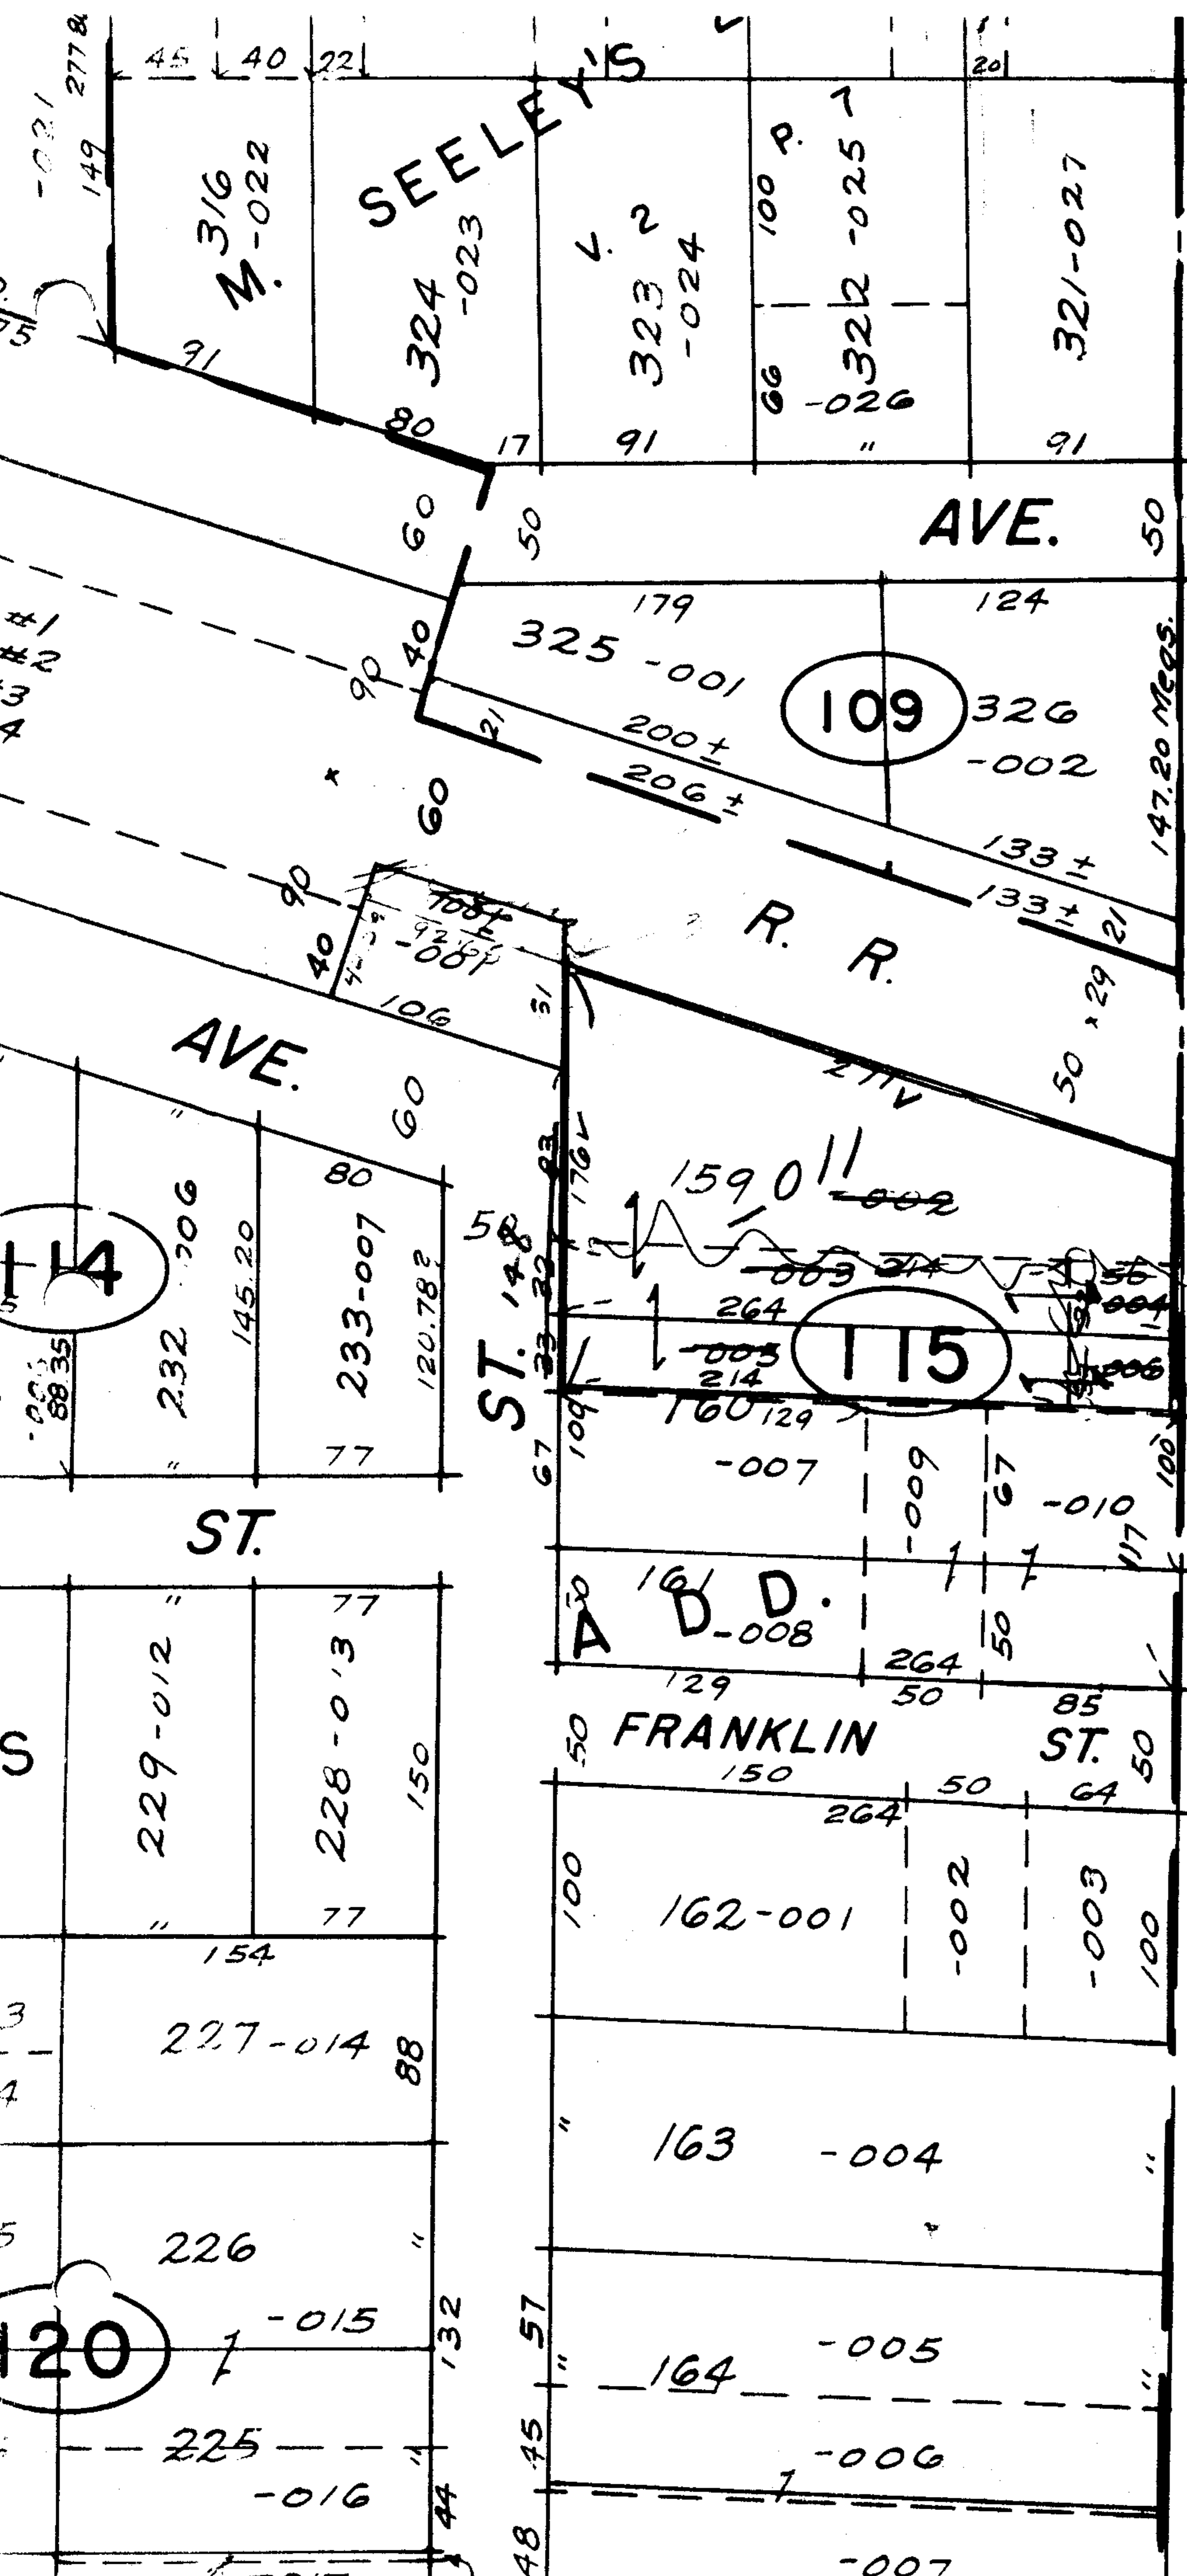

33  
32  
83  
148

SEP 23 ENTD

SEE 5-00-037-A

5238  
APPROVED  
LORAIN CO.  
MAP DEPT.  
DATE 9-1-71  
5-00-024B  
BY LWHall

5-00-024B