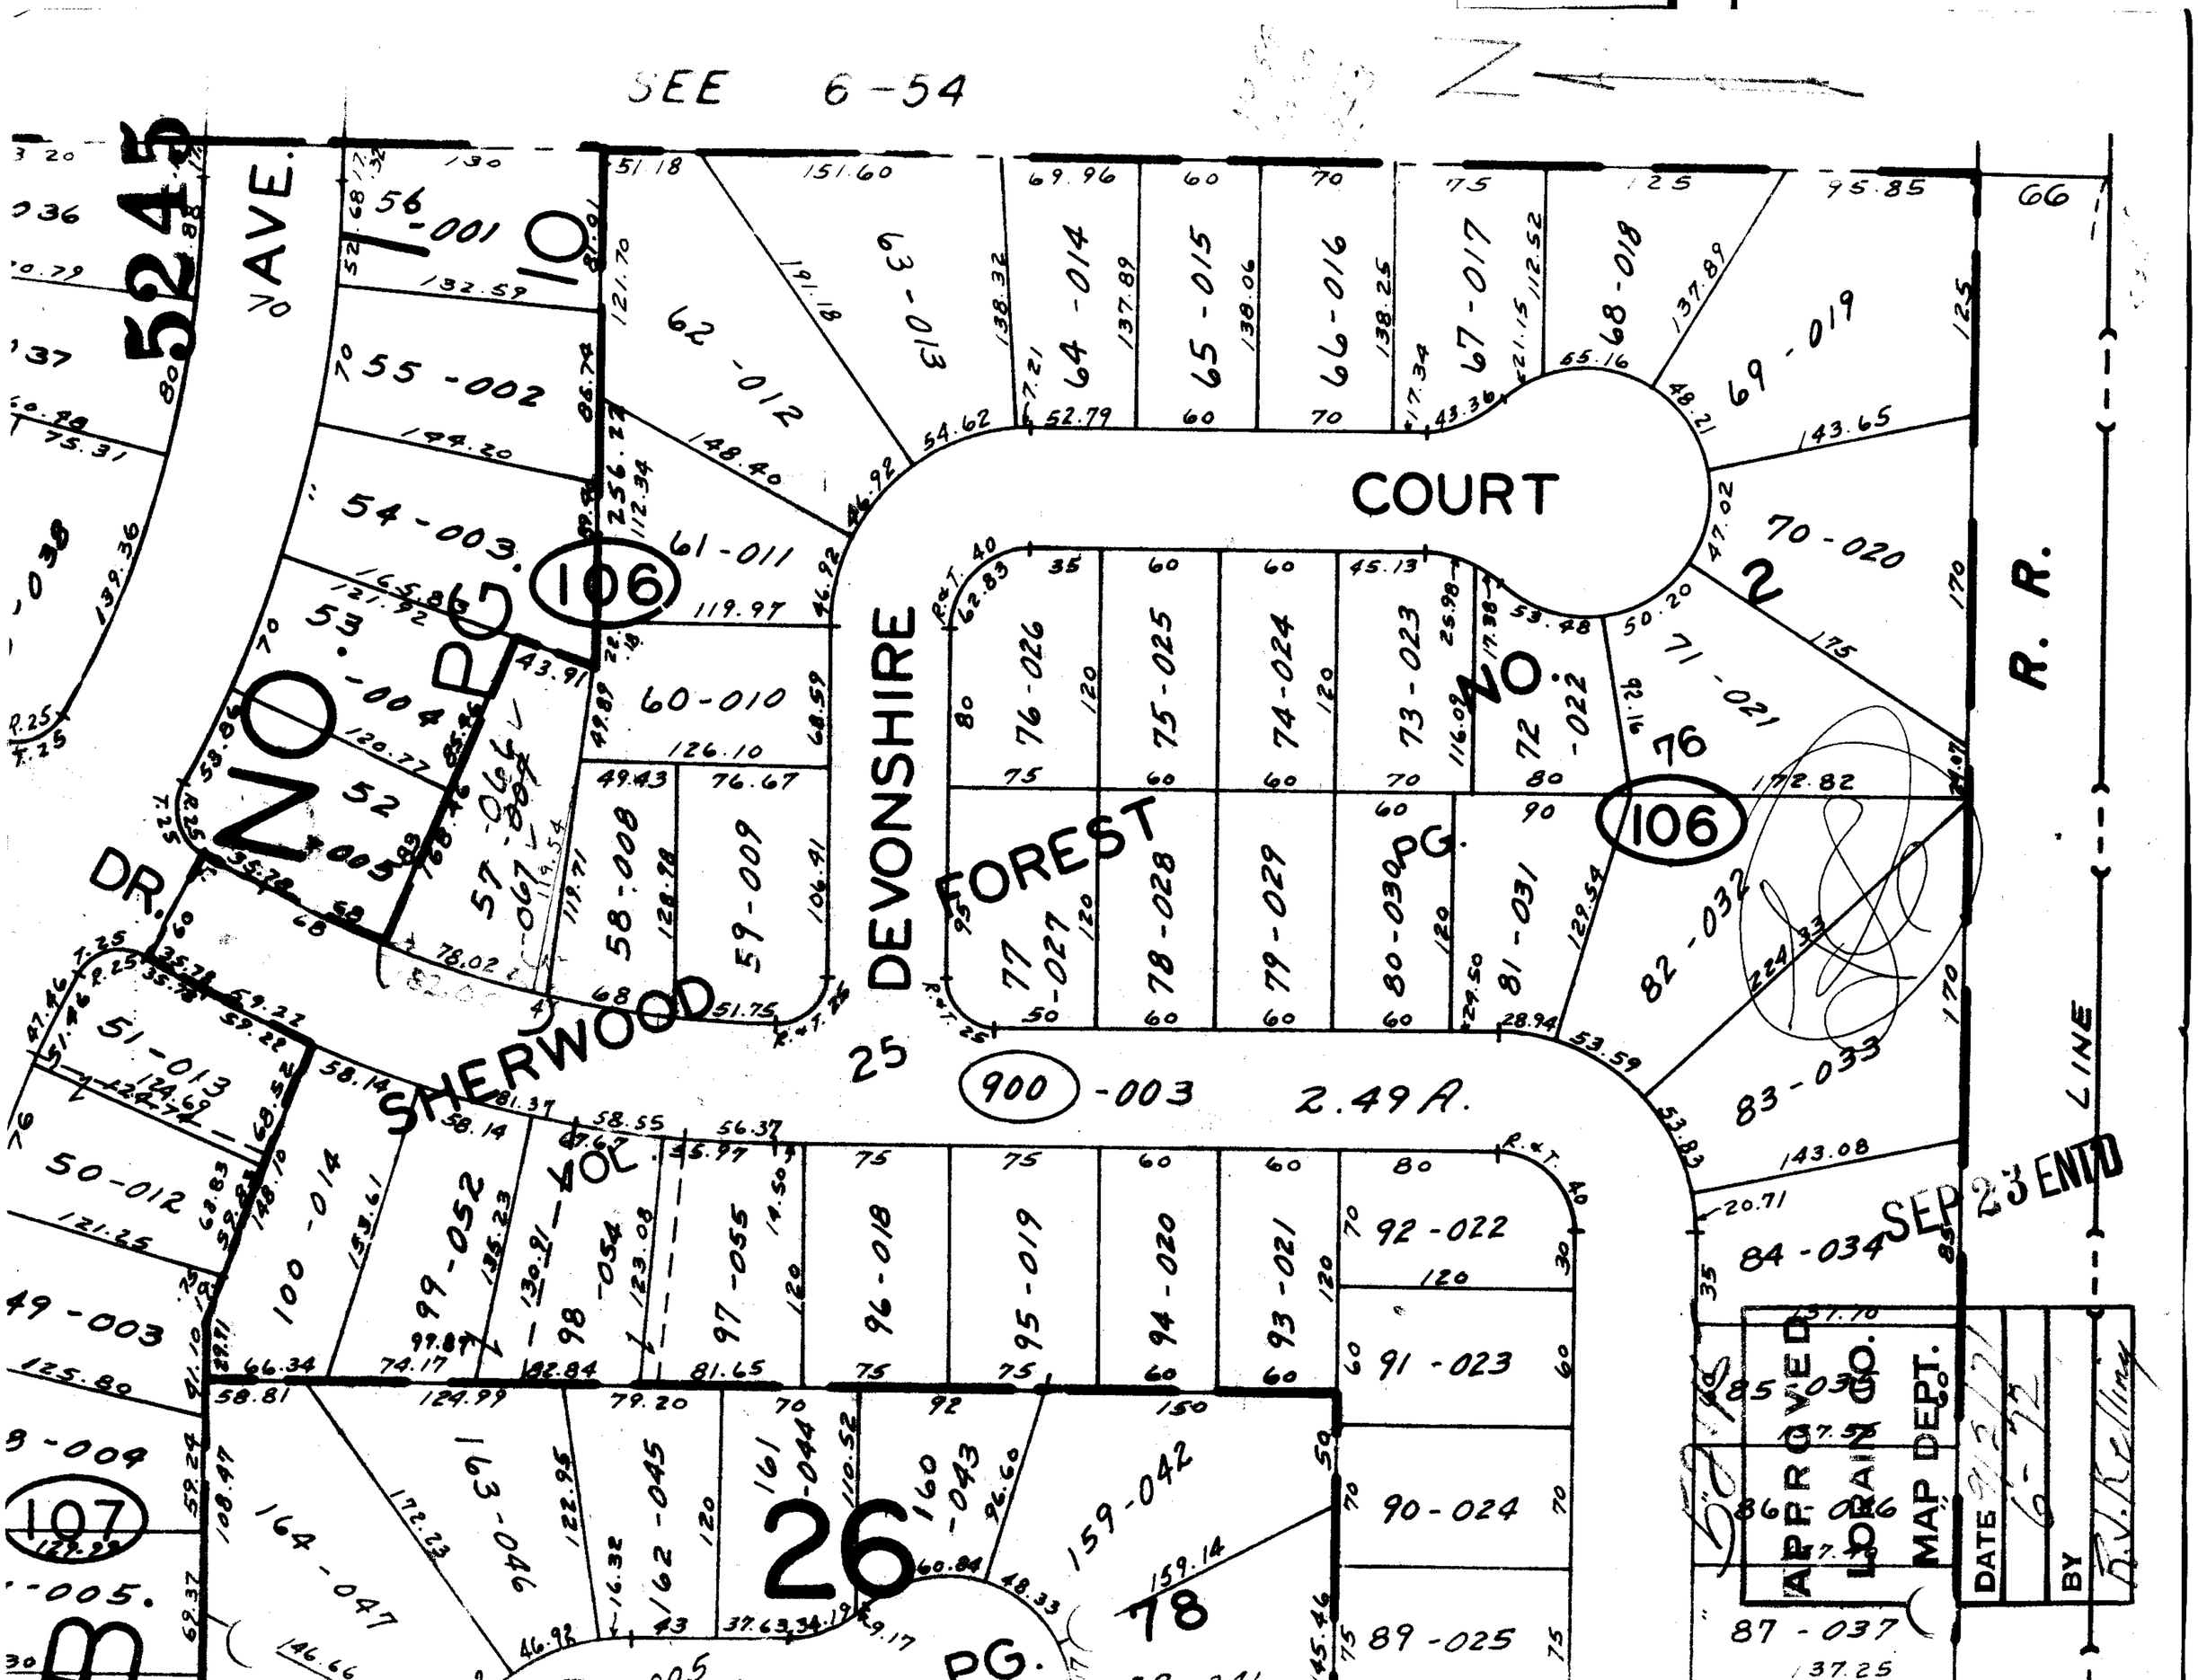
SEE 6-54
COURT
DEVONSHIRE
FOREST
SHERWOOD
DR.
AVE.
R. R.
LINE
2.49 A.
900 -003
106
107
5245
26
25
76
78
SEP 23 ENTD
APPROVED
LORAIN CO.
MAP DEPT.
DATE
BY