


5247

101

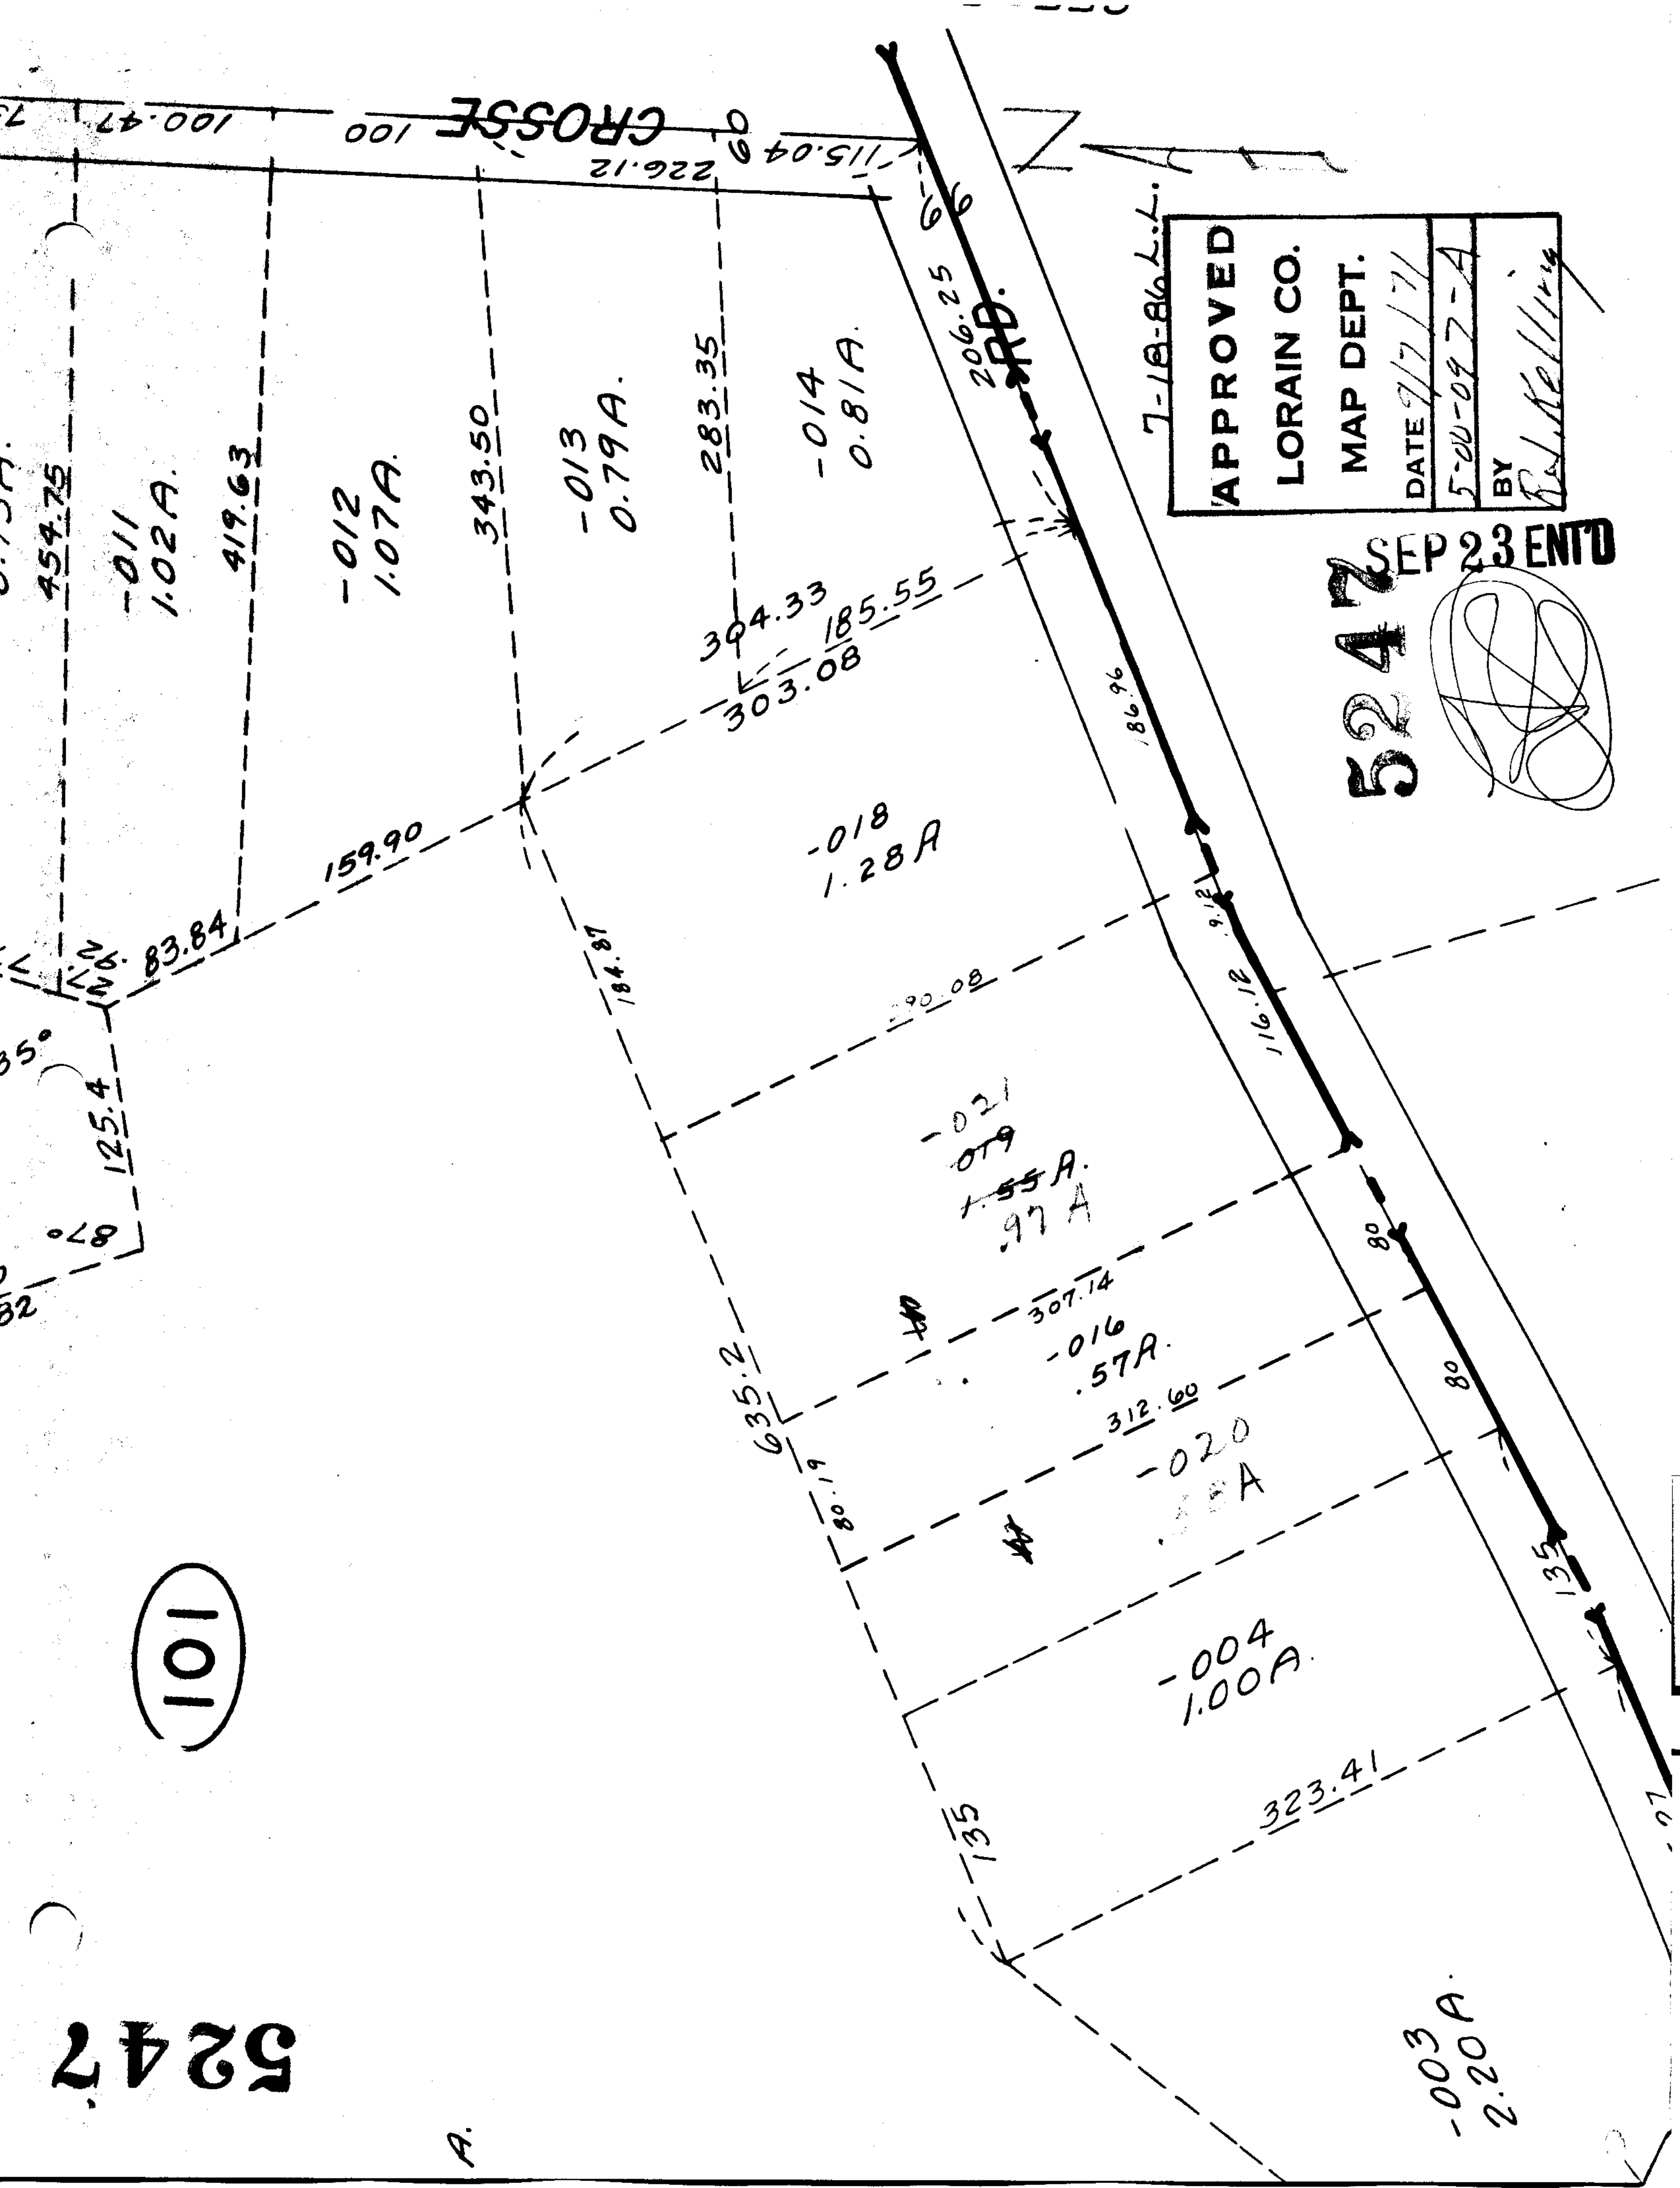

7-18-86 L.L.

APPROVED
LORAIN CO.
MAP DEPT.
DATE 9/7/77
5-00-097-A
BY R. Kelling




A.