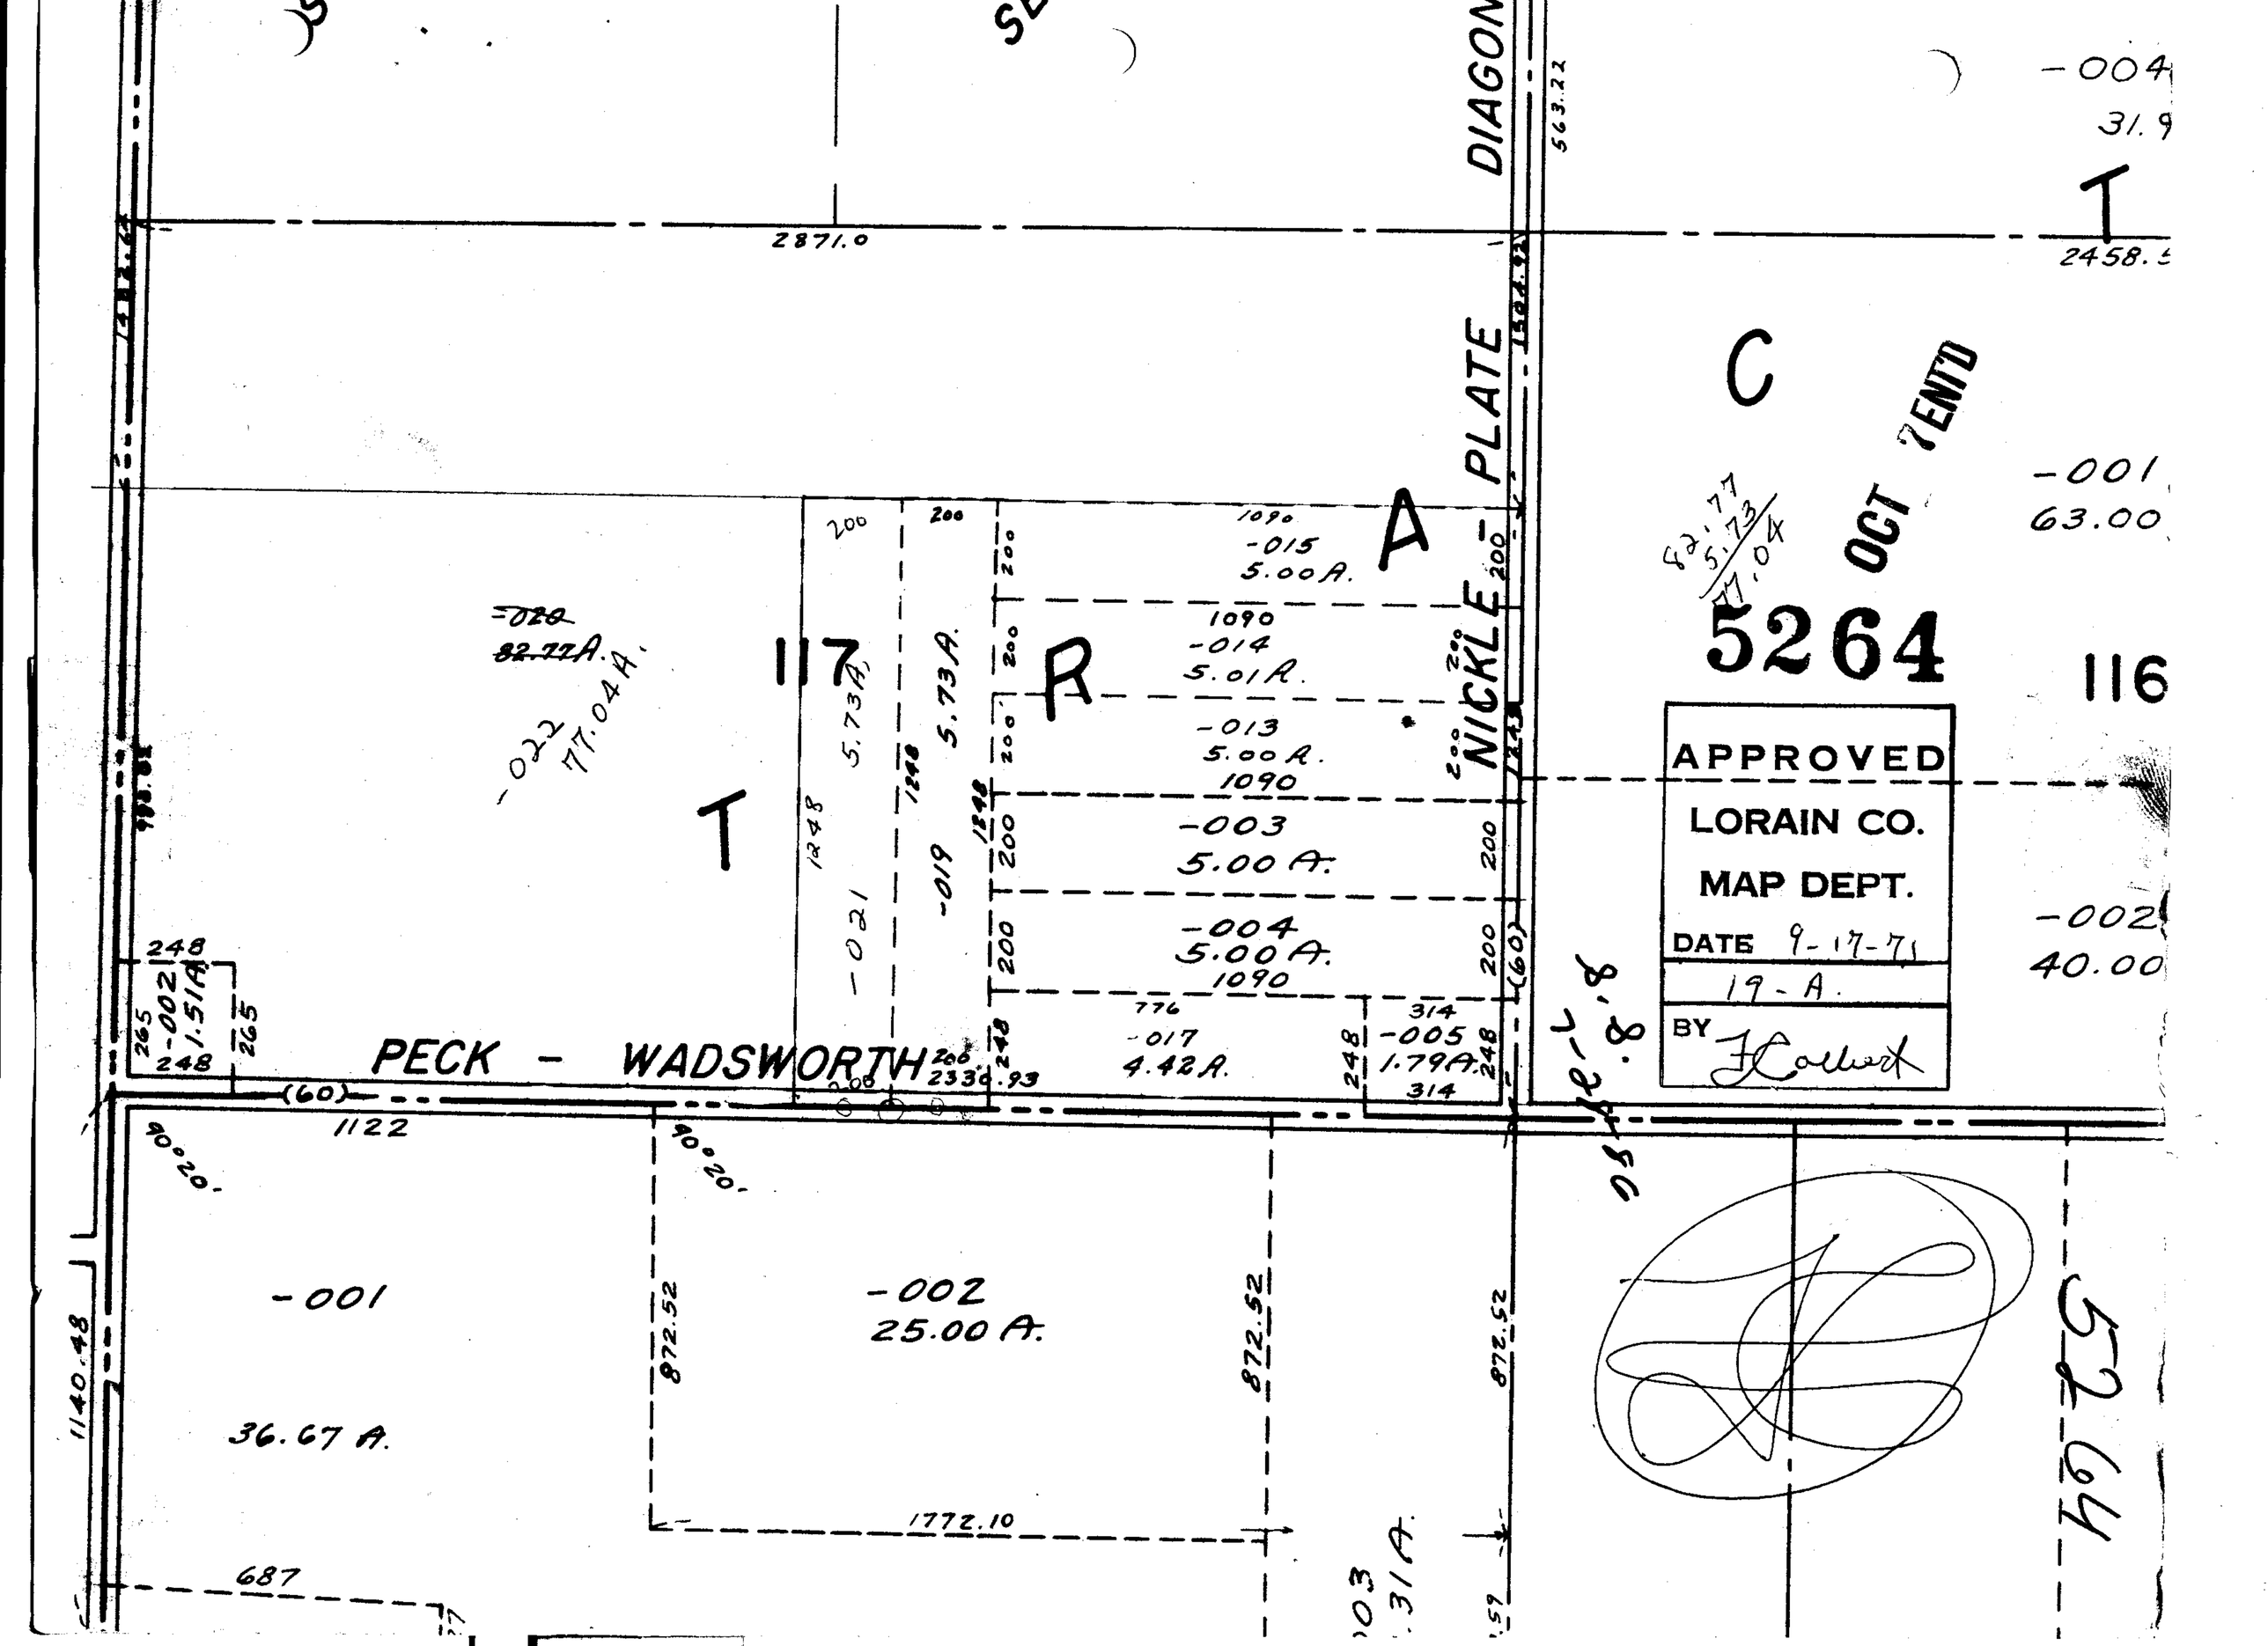

DIAGON
NICKLE - PLATE
PECK - WADSWORTH
117
116
T
R
A
C
-004
31.9
2458.5
2871.0
563.22
-001
63.00
-002
40.00
-015
5.00 A.
-014
5.01 A.
-013
5.00 A.
-003
5.00 A.
-004
5.00 A.
-017
4.42 A.
-005
1.79 A.
-020
82.77 A.
-022
77.04 A.
-021
5.73 A.
-019
5.73 A.
-002
1.51 A.
-001
36.67 A.
-002
25.00 A.
1122
1140.48
687
1772.10
872.52
90°20'
(60)
82.77
5.73
77.04
OCT 7 ENT'D
5264
APPROVED
LORAIN CO.
MAP DEPT.
DATE 9-17-71
19-A.
BY