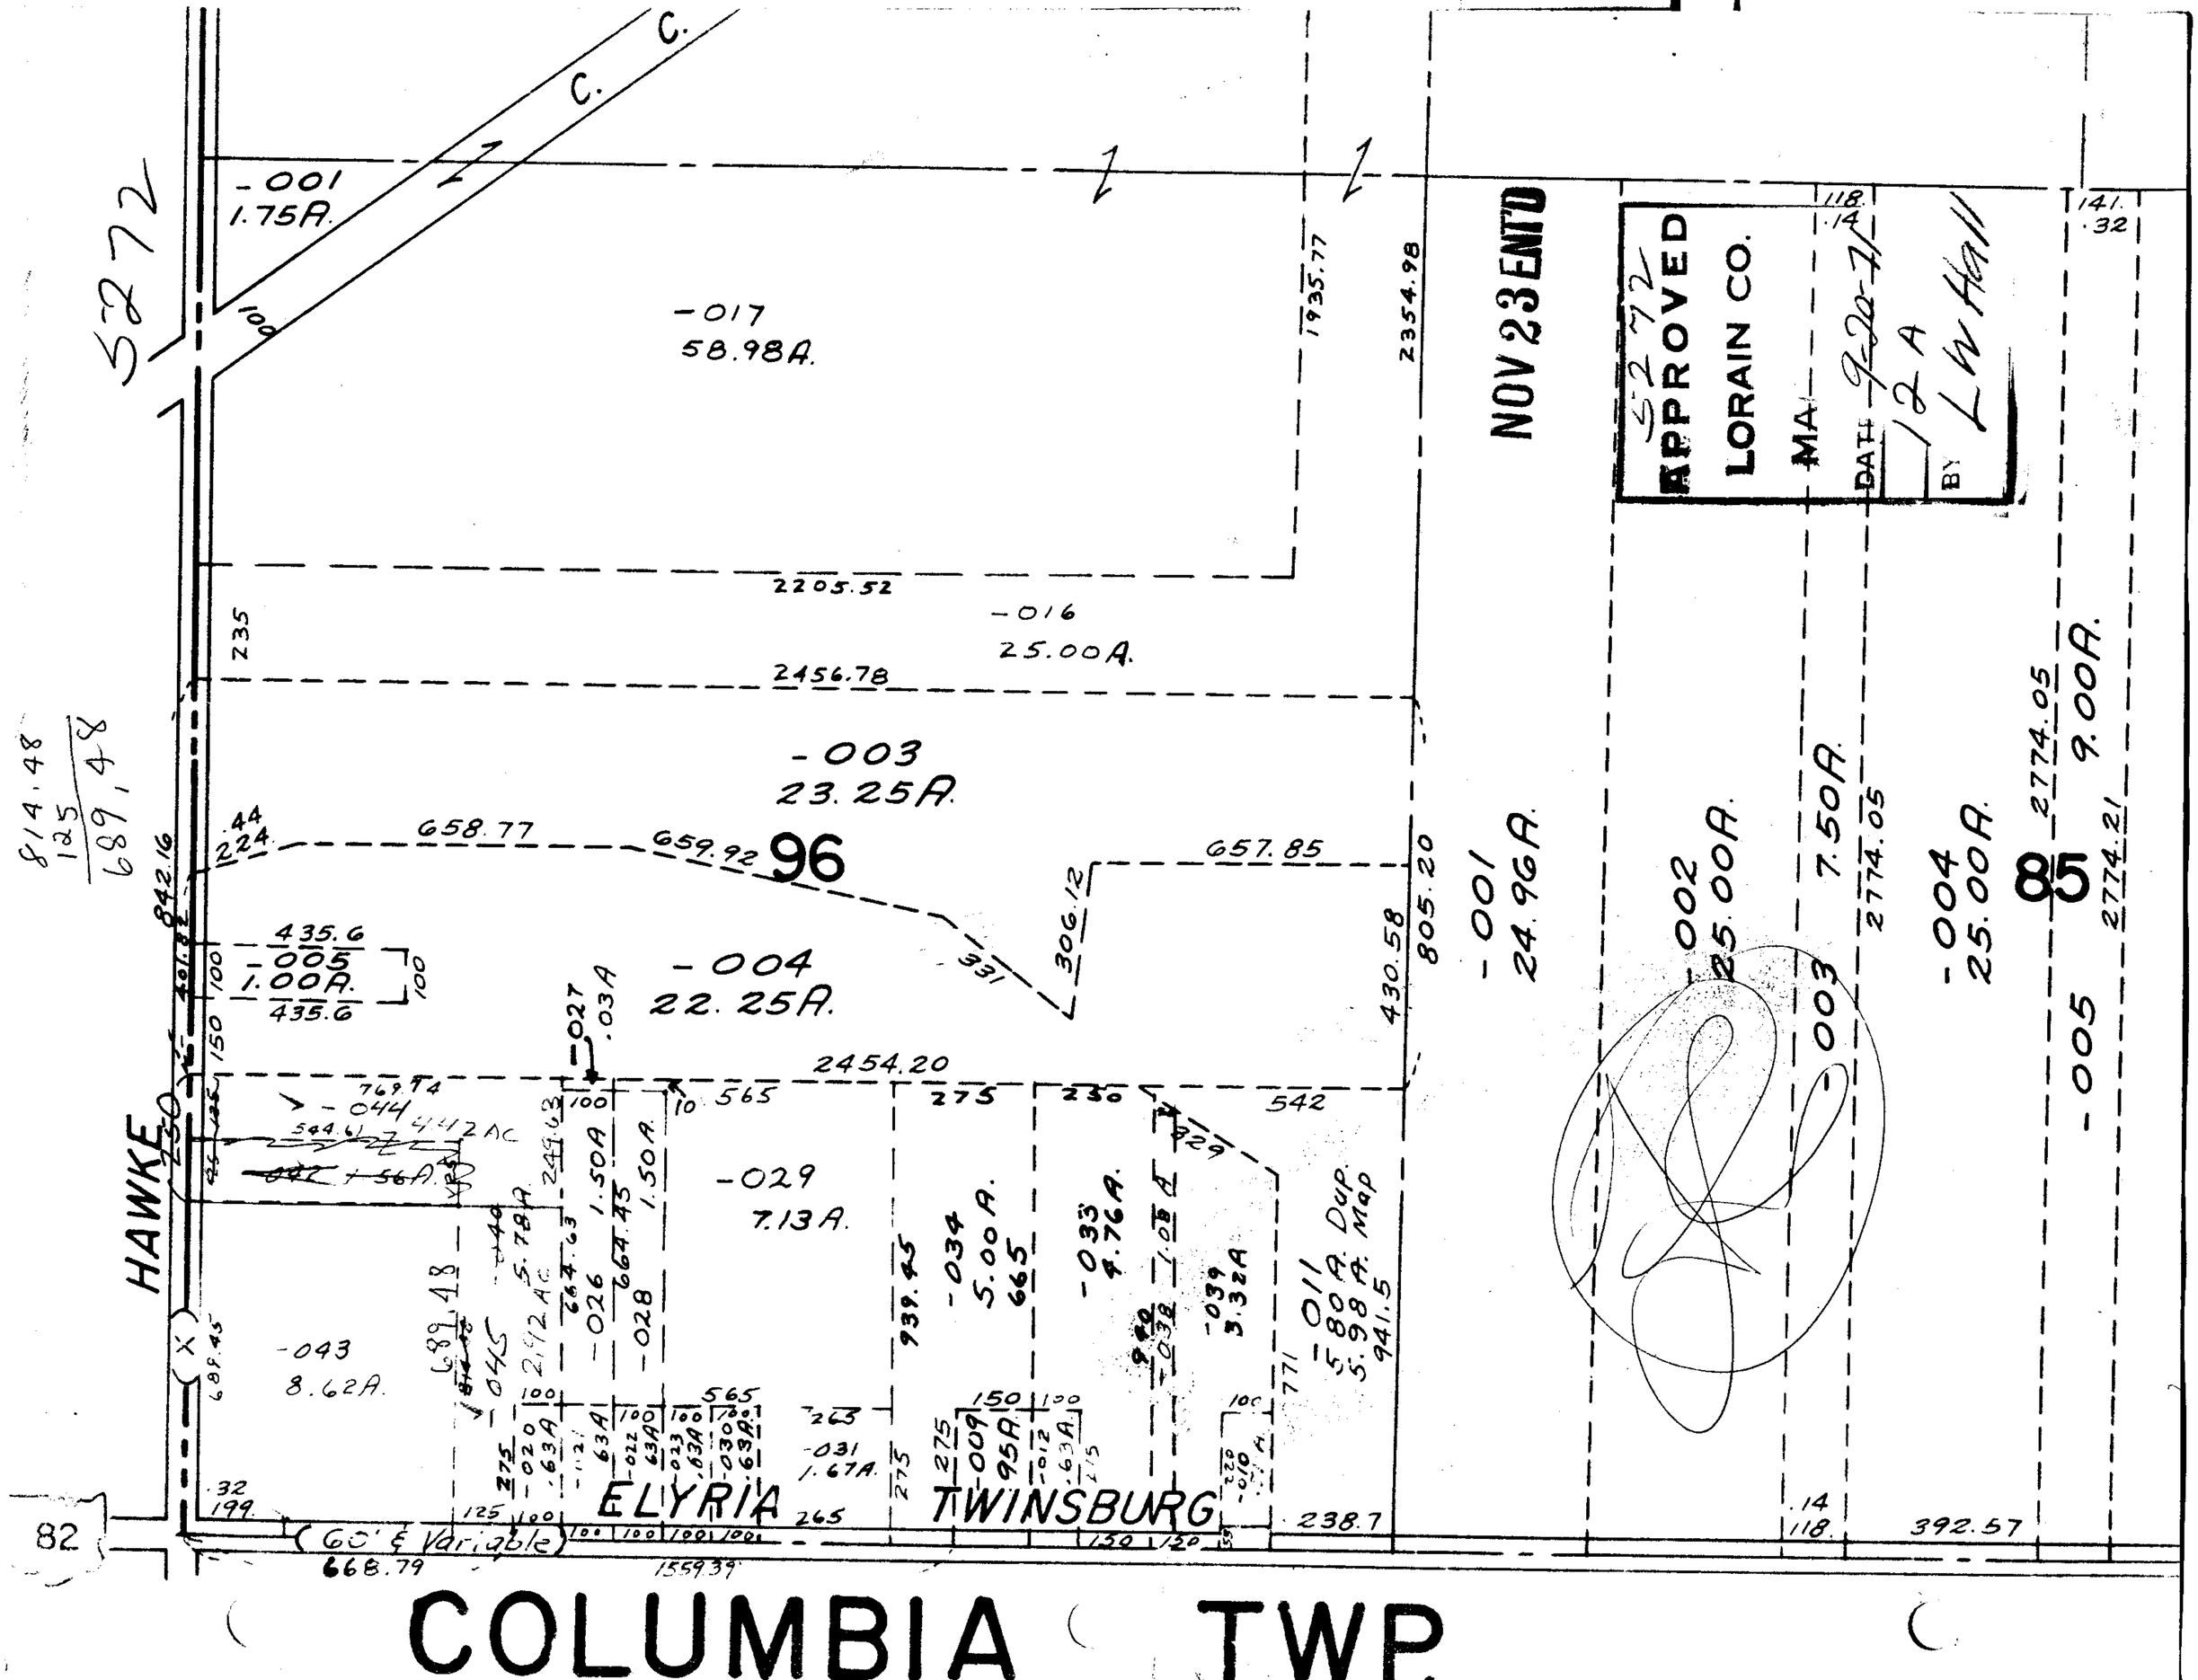

5272
-001
1.75A.
-017
58.98A.
-016
25.00A.
-003
23.25A.
96
-004
22.25A.
-005
1.00A.
-029
7.13A.
-043
8.62A.
-034
5.00A.
-033
4.76A.
-011
5.80A. Dup.
5.98A. Map
-001
24.96A.
-002
25.00A.
-003
7.50A.
-004
25.00A.
-005
9.00A.
85
HAWKE
ELYRIA
TWINSBURG
(60' & Variable)
NOV 23 ENT'D
APPROVED
LORAIN CO.
MA
DATE 9-20-71
12 A
BY LW Hall
82
COLUMBIA TWP.