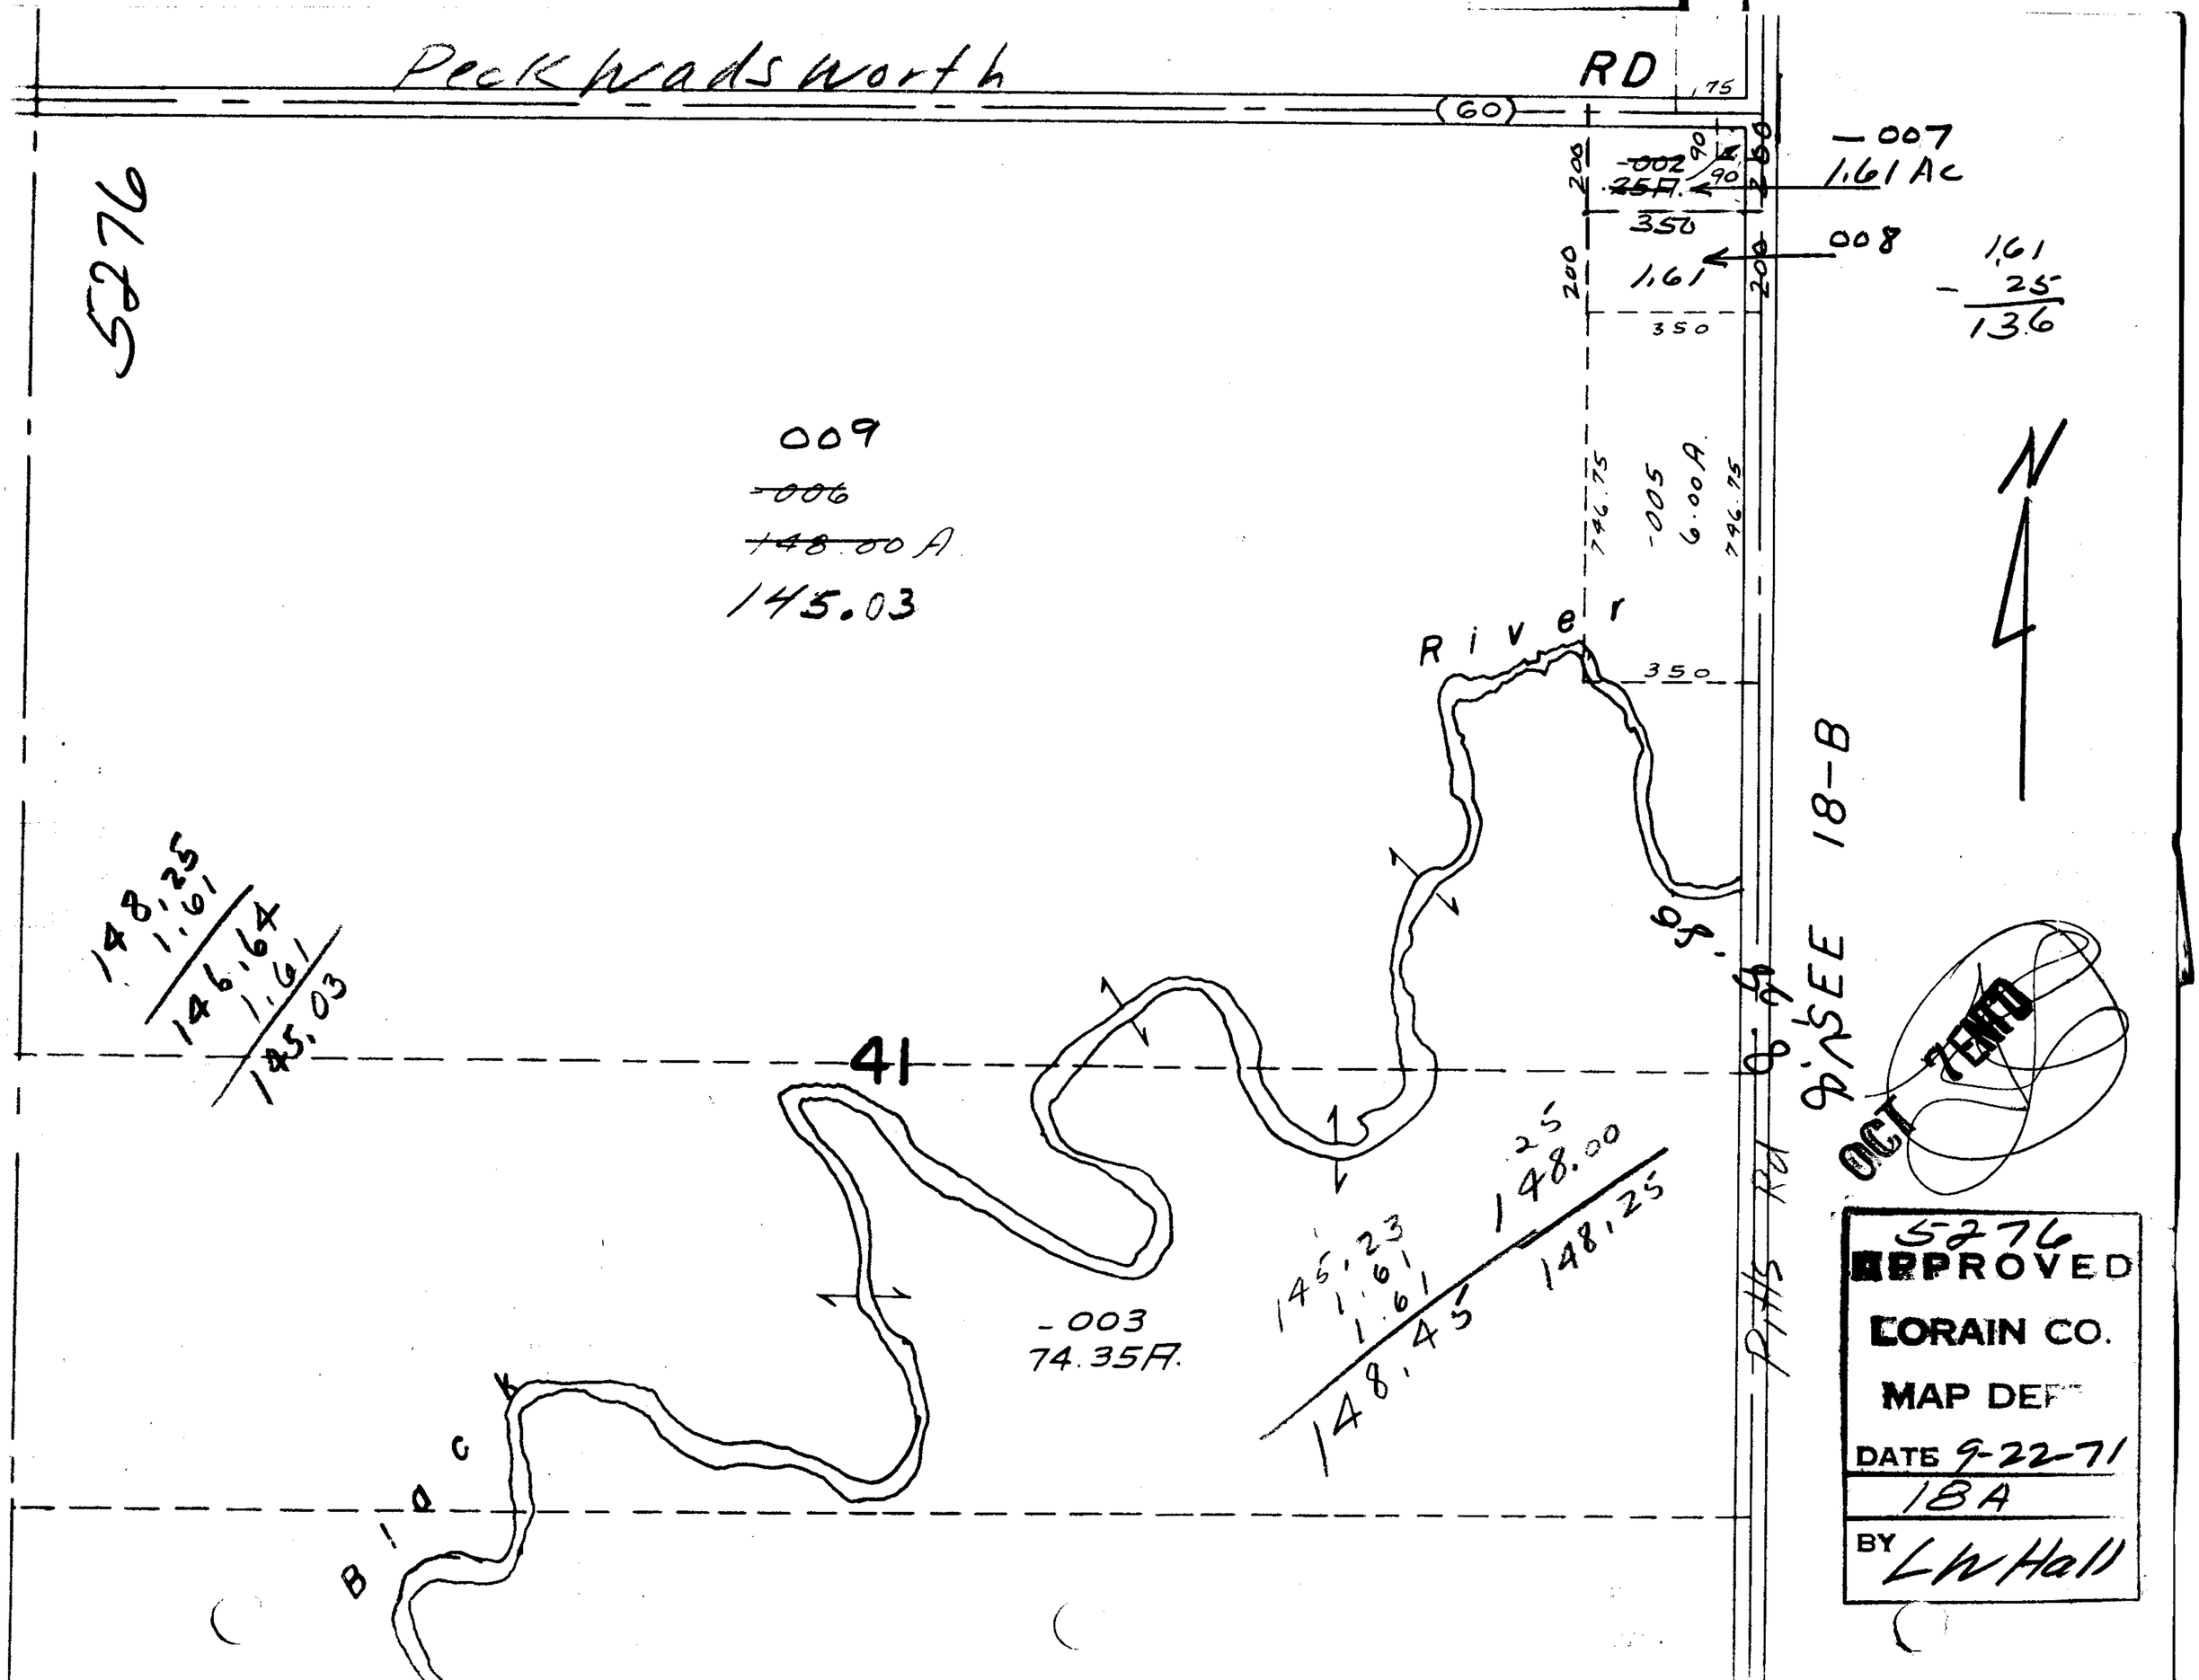

Peckwadsworth
RD
(60)
5276
-007
1.61 Ac
-002
.25A.
350
008
1.61
200
1.61
- .25
13.6
009
-006
148.00 A
145.03
746.75
-005
6.00A.
746.75
River
350
N
18-B
SEE
148.25
1.61
146.64
1.61
145.03
41
-003
74.35A.
145.23
1.61
1.61
148.45
.25
148.00
148.25
Black
Pitts Rd
OCT 7 ENTD
5276
APPROVED
LORAIN CO.
MAP DEPT
DATE 9-22-71
18A
BY LW Hall