


5279

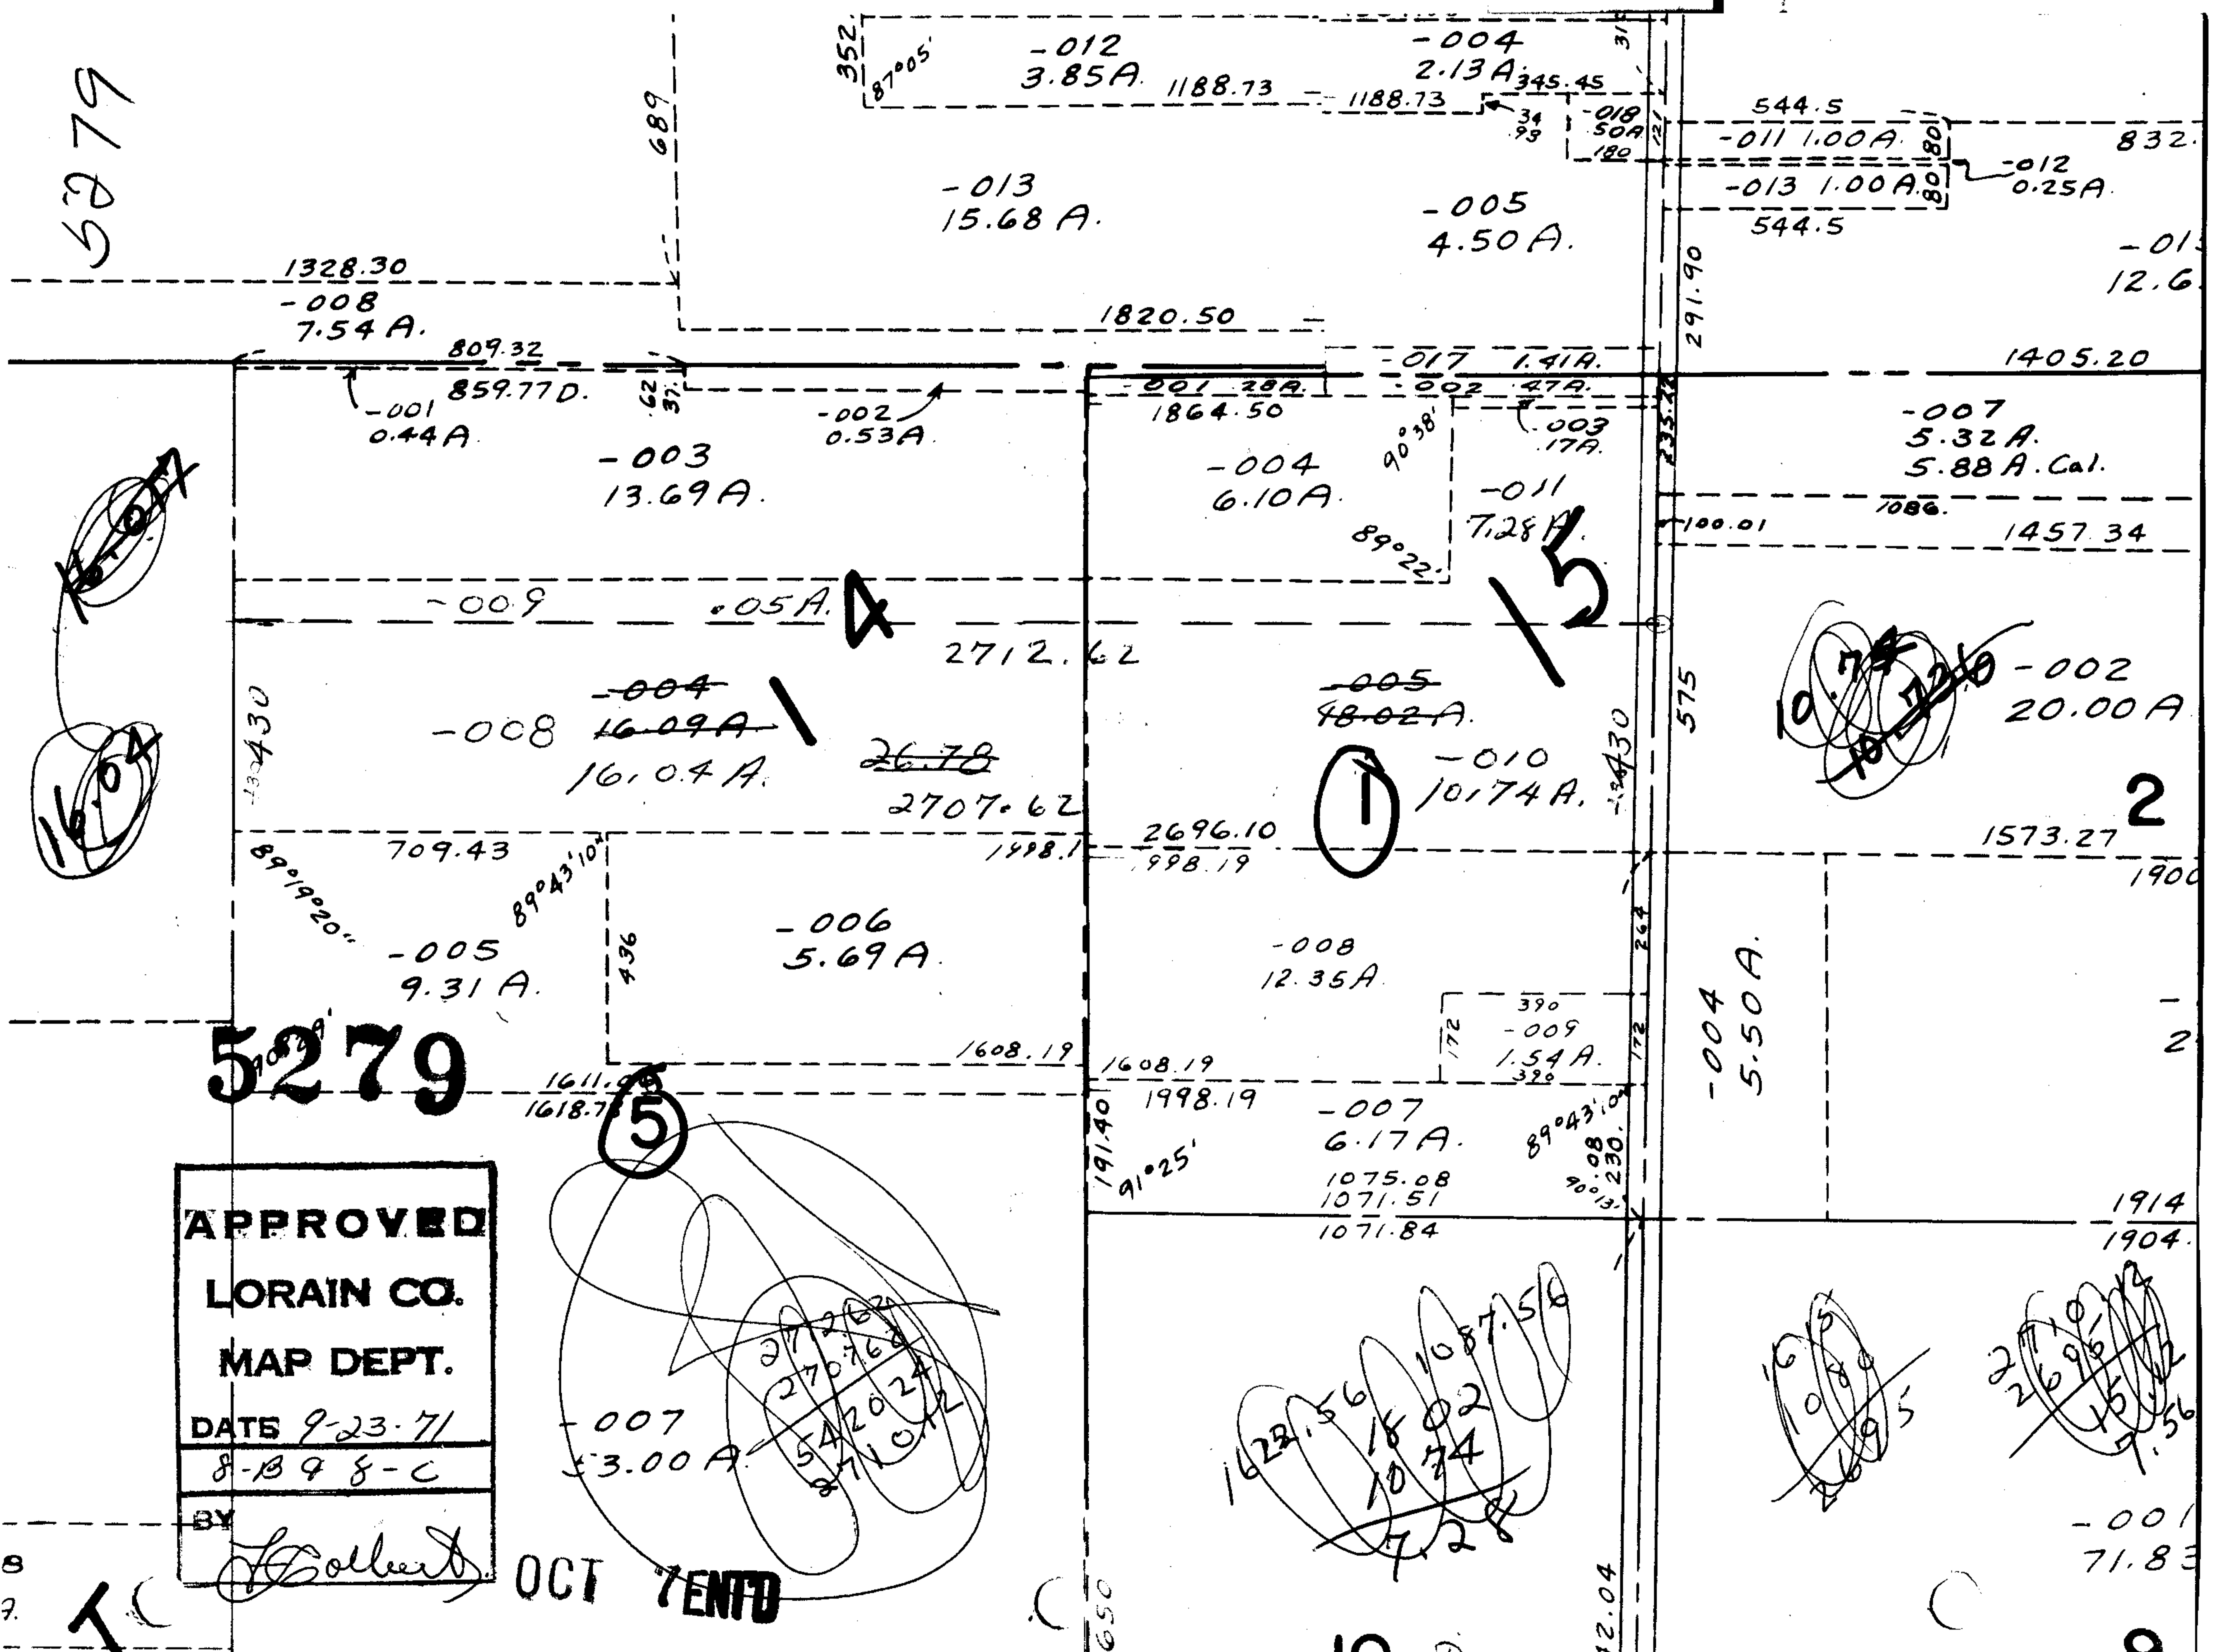

APPROVED
LORAIN CO.
MAP DEPT.
 DATE 9-23-71
 8-B 9 8-C
 BY *Robert*

OCT 7 1971

8
7

T

650

42.04

9