


5282

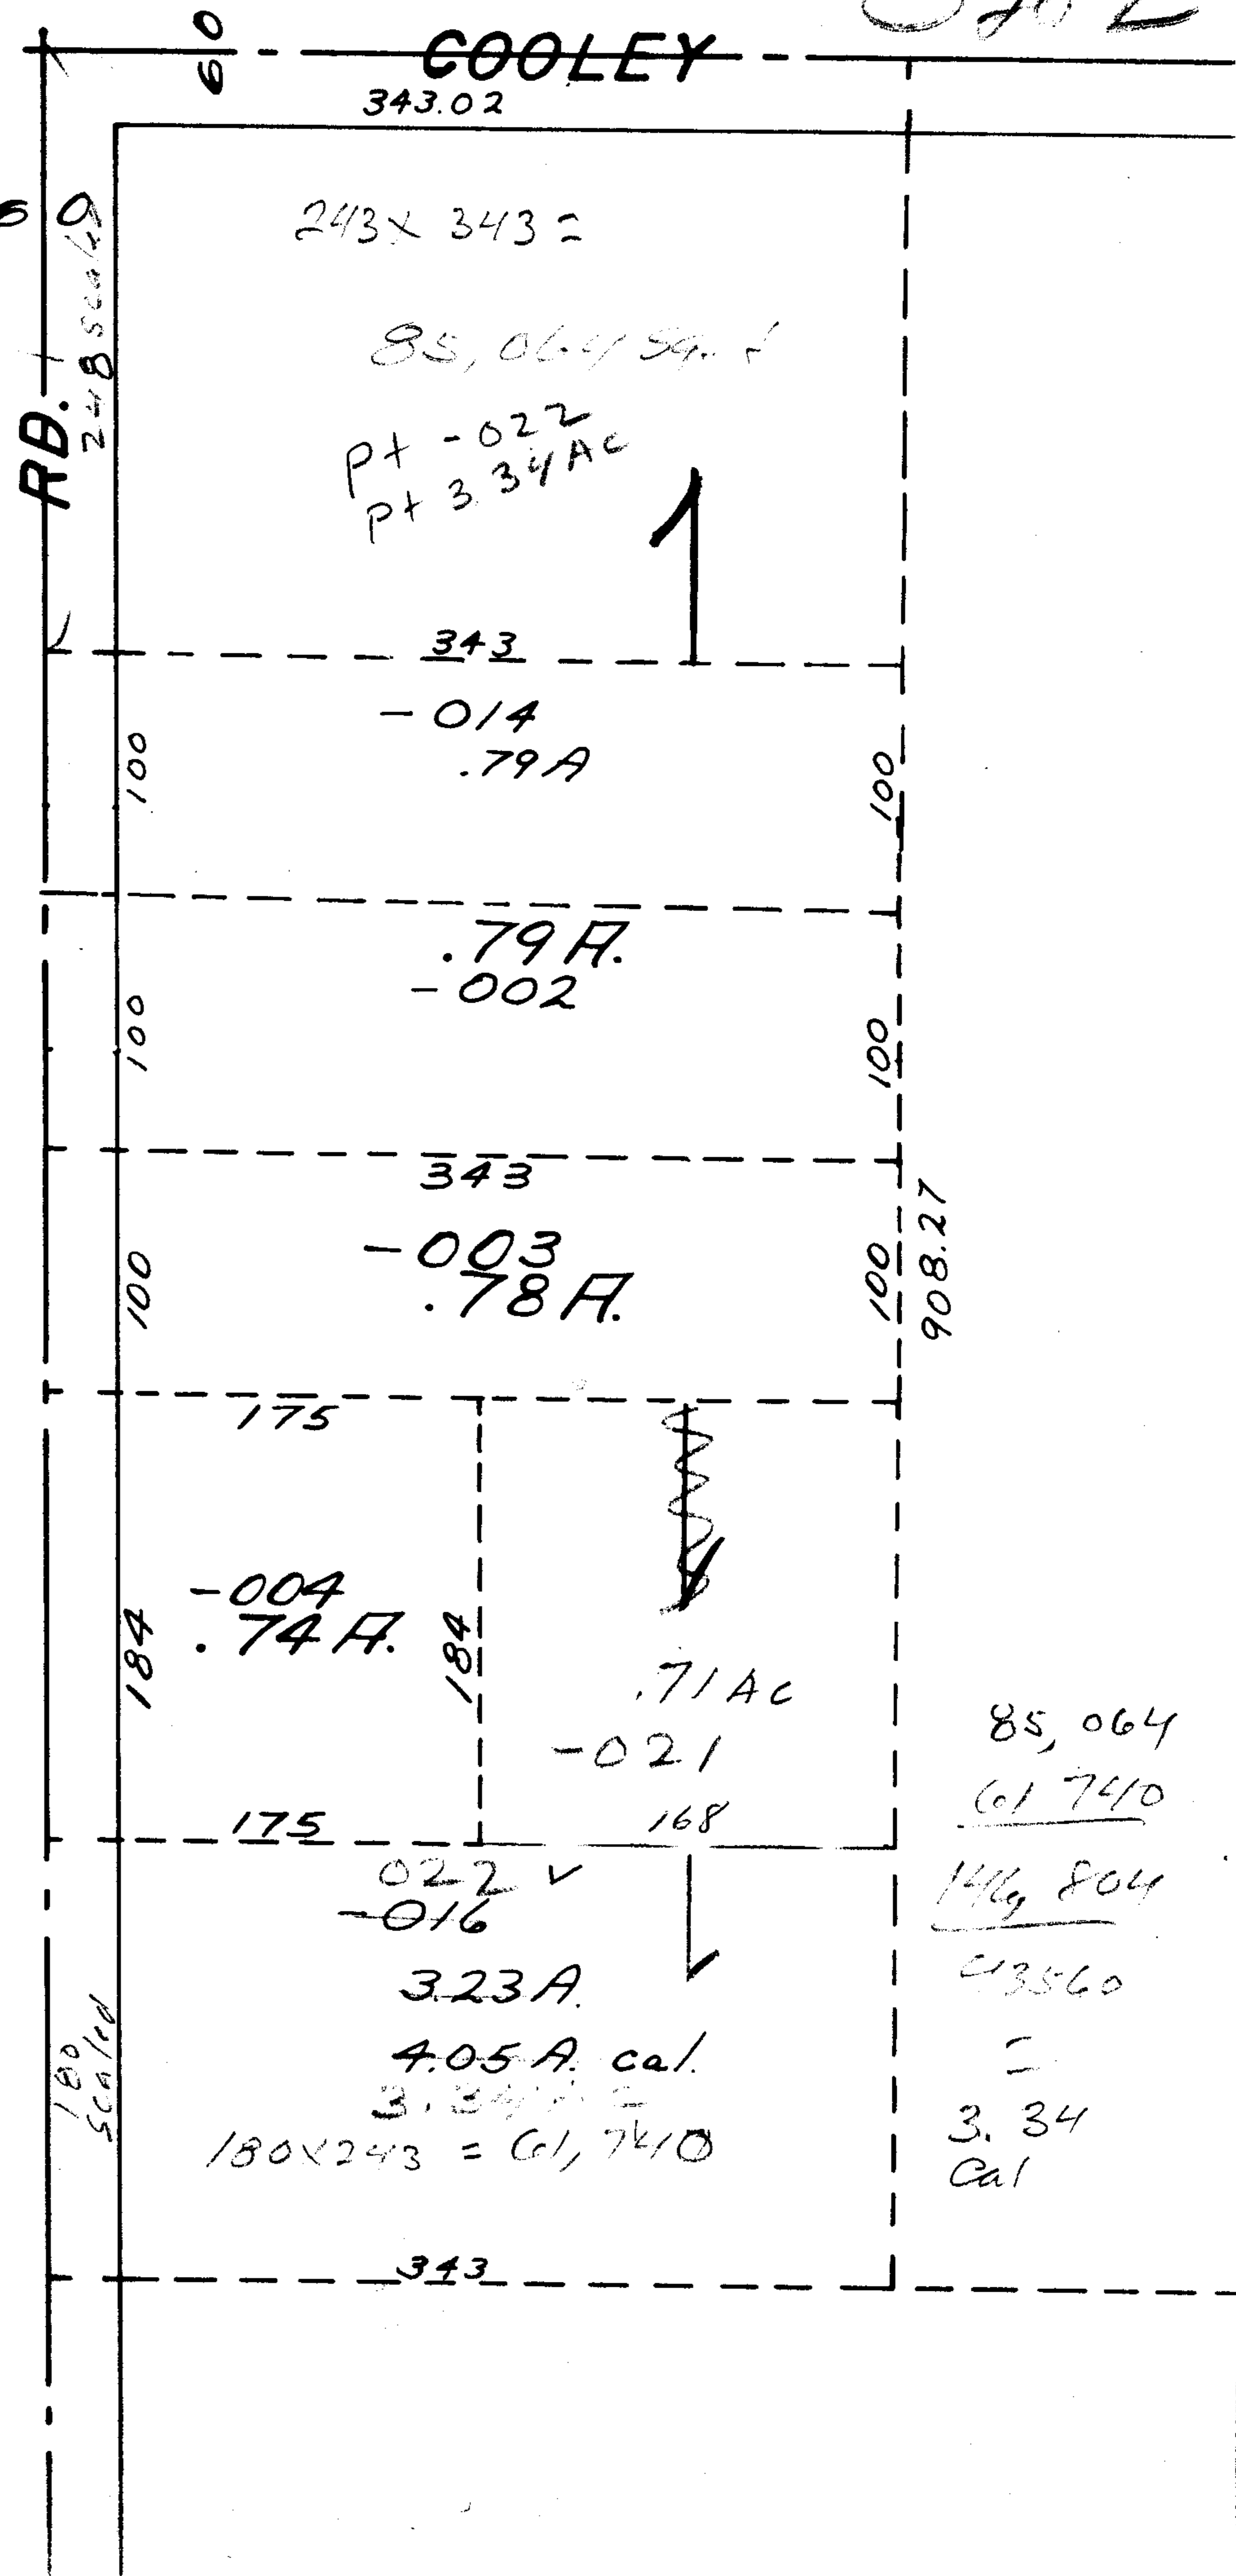

5282


APPROVED
 LORAIN CO.
 MAP DEPT.
 DATE 9.27.71
 11-00-327A
 BY L. W. Hall

S.S. 7-22-86

L.R. Boyson
NOV 23 ENT'D

343
 175

 168

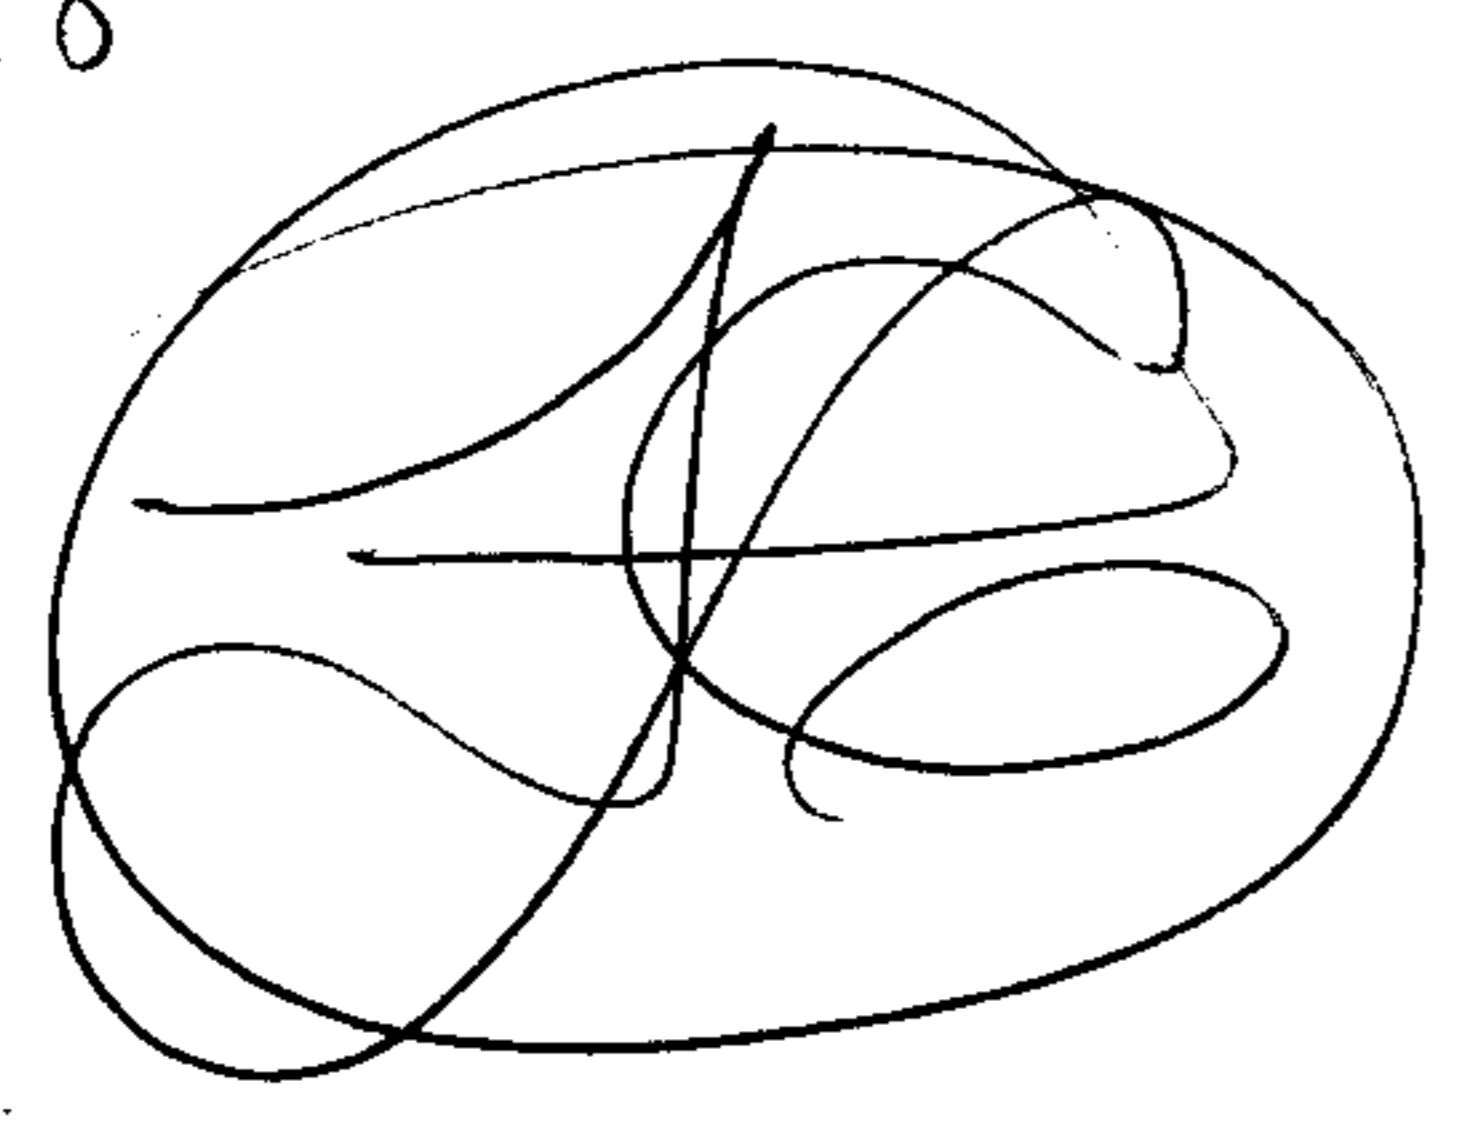

85,064
 61,740

 146,804

 43,560

 3.34
 Cal

022 v
 -016
 3.23 A.
 4.05 A. cal.
 3.34 AC
 180 x 243 = 61,740