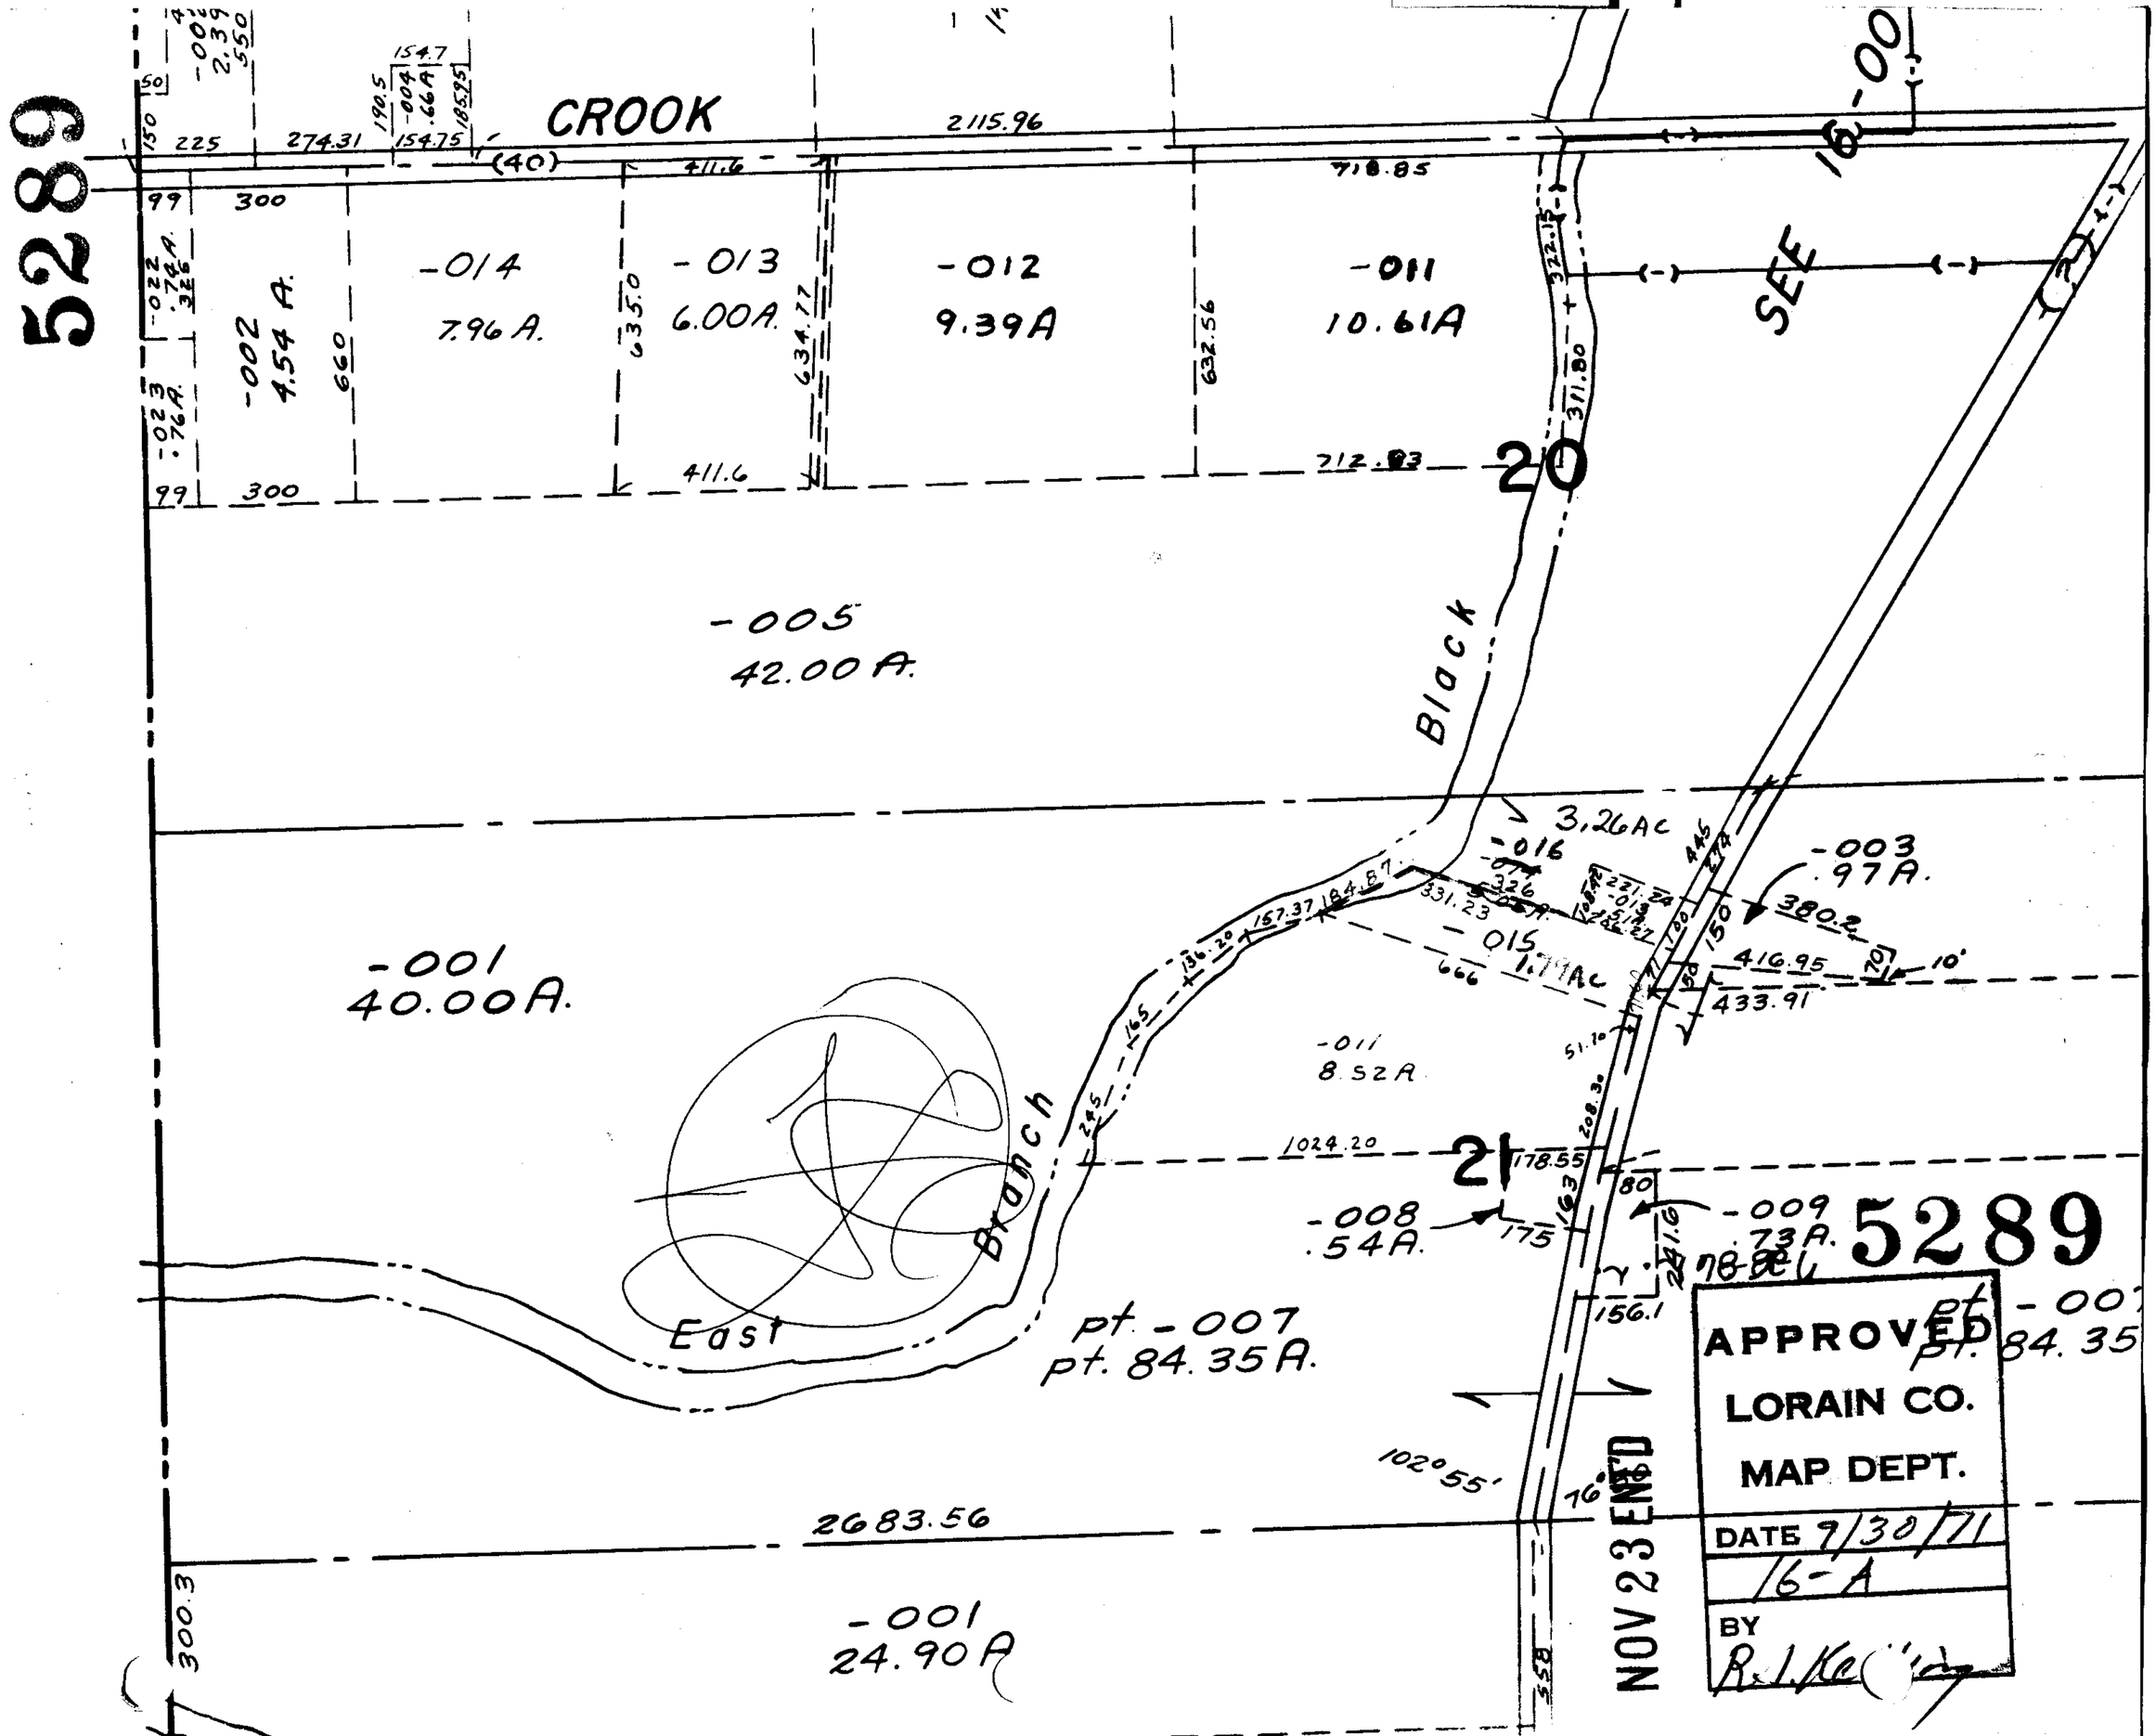
5289
CROOK
2115.96
(40)
411.6
718.85
225
274.31
154.7
154.75
190.5
185.95
99
300
-014
7.96 A.
-013
6.00A.
-012
9.39A
-011
10.61A
-002
4.54 A.
660
635.0
634.77
632.56
322.15
311.80
SEE 16-00
20
712.83
-005
42.00 A.
Black
3.26AC
-016
-003
.97A.
380.2
416.95
433.91
10'
-015
1.79AC
-001
40.00A.
-011
8.52A
1024.20
21
178.55
-008
.54A.
-009
.73A.
5289
East
Branch
pt. -007
pt. 84.35A.
156.1
102°55'
2683.56
-001
24.90A
300.3
NOV 23 END'D
APPROVED
LORAIN CO.
MAP DEPT.
DATE 9/30/71
16-A
BY