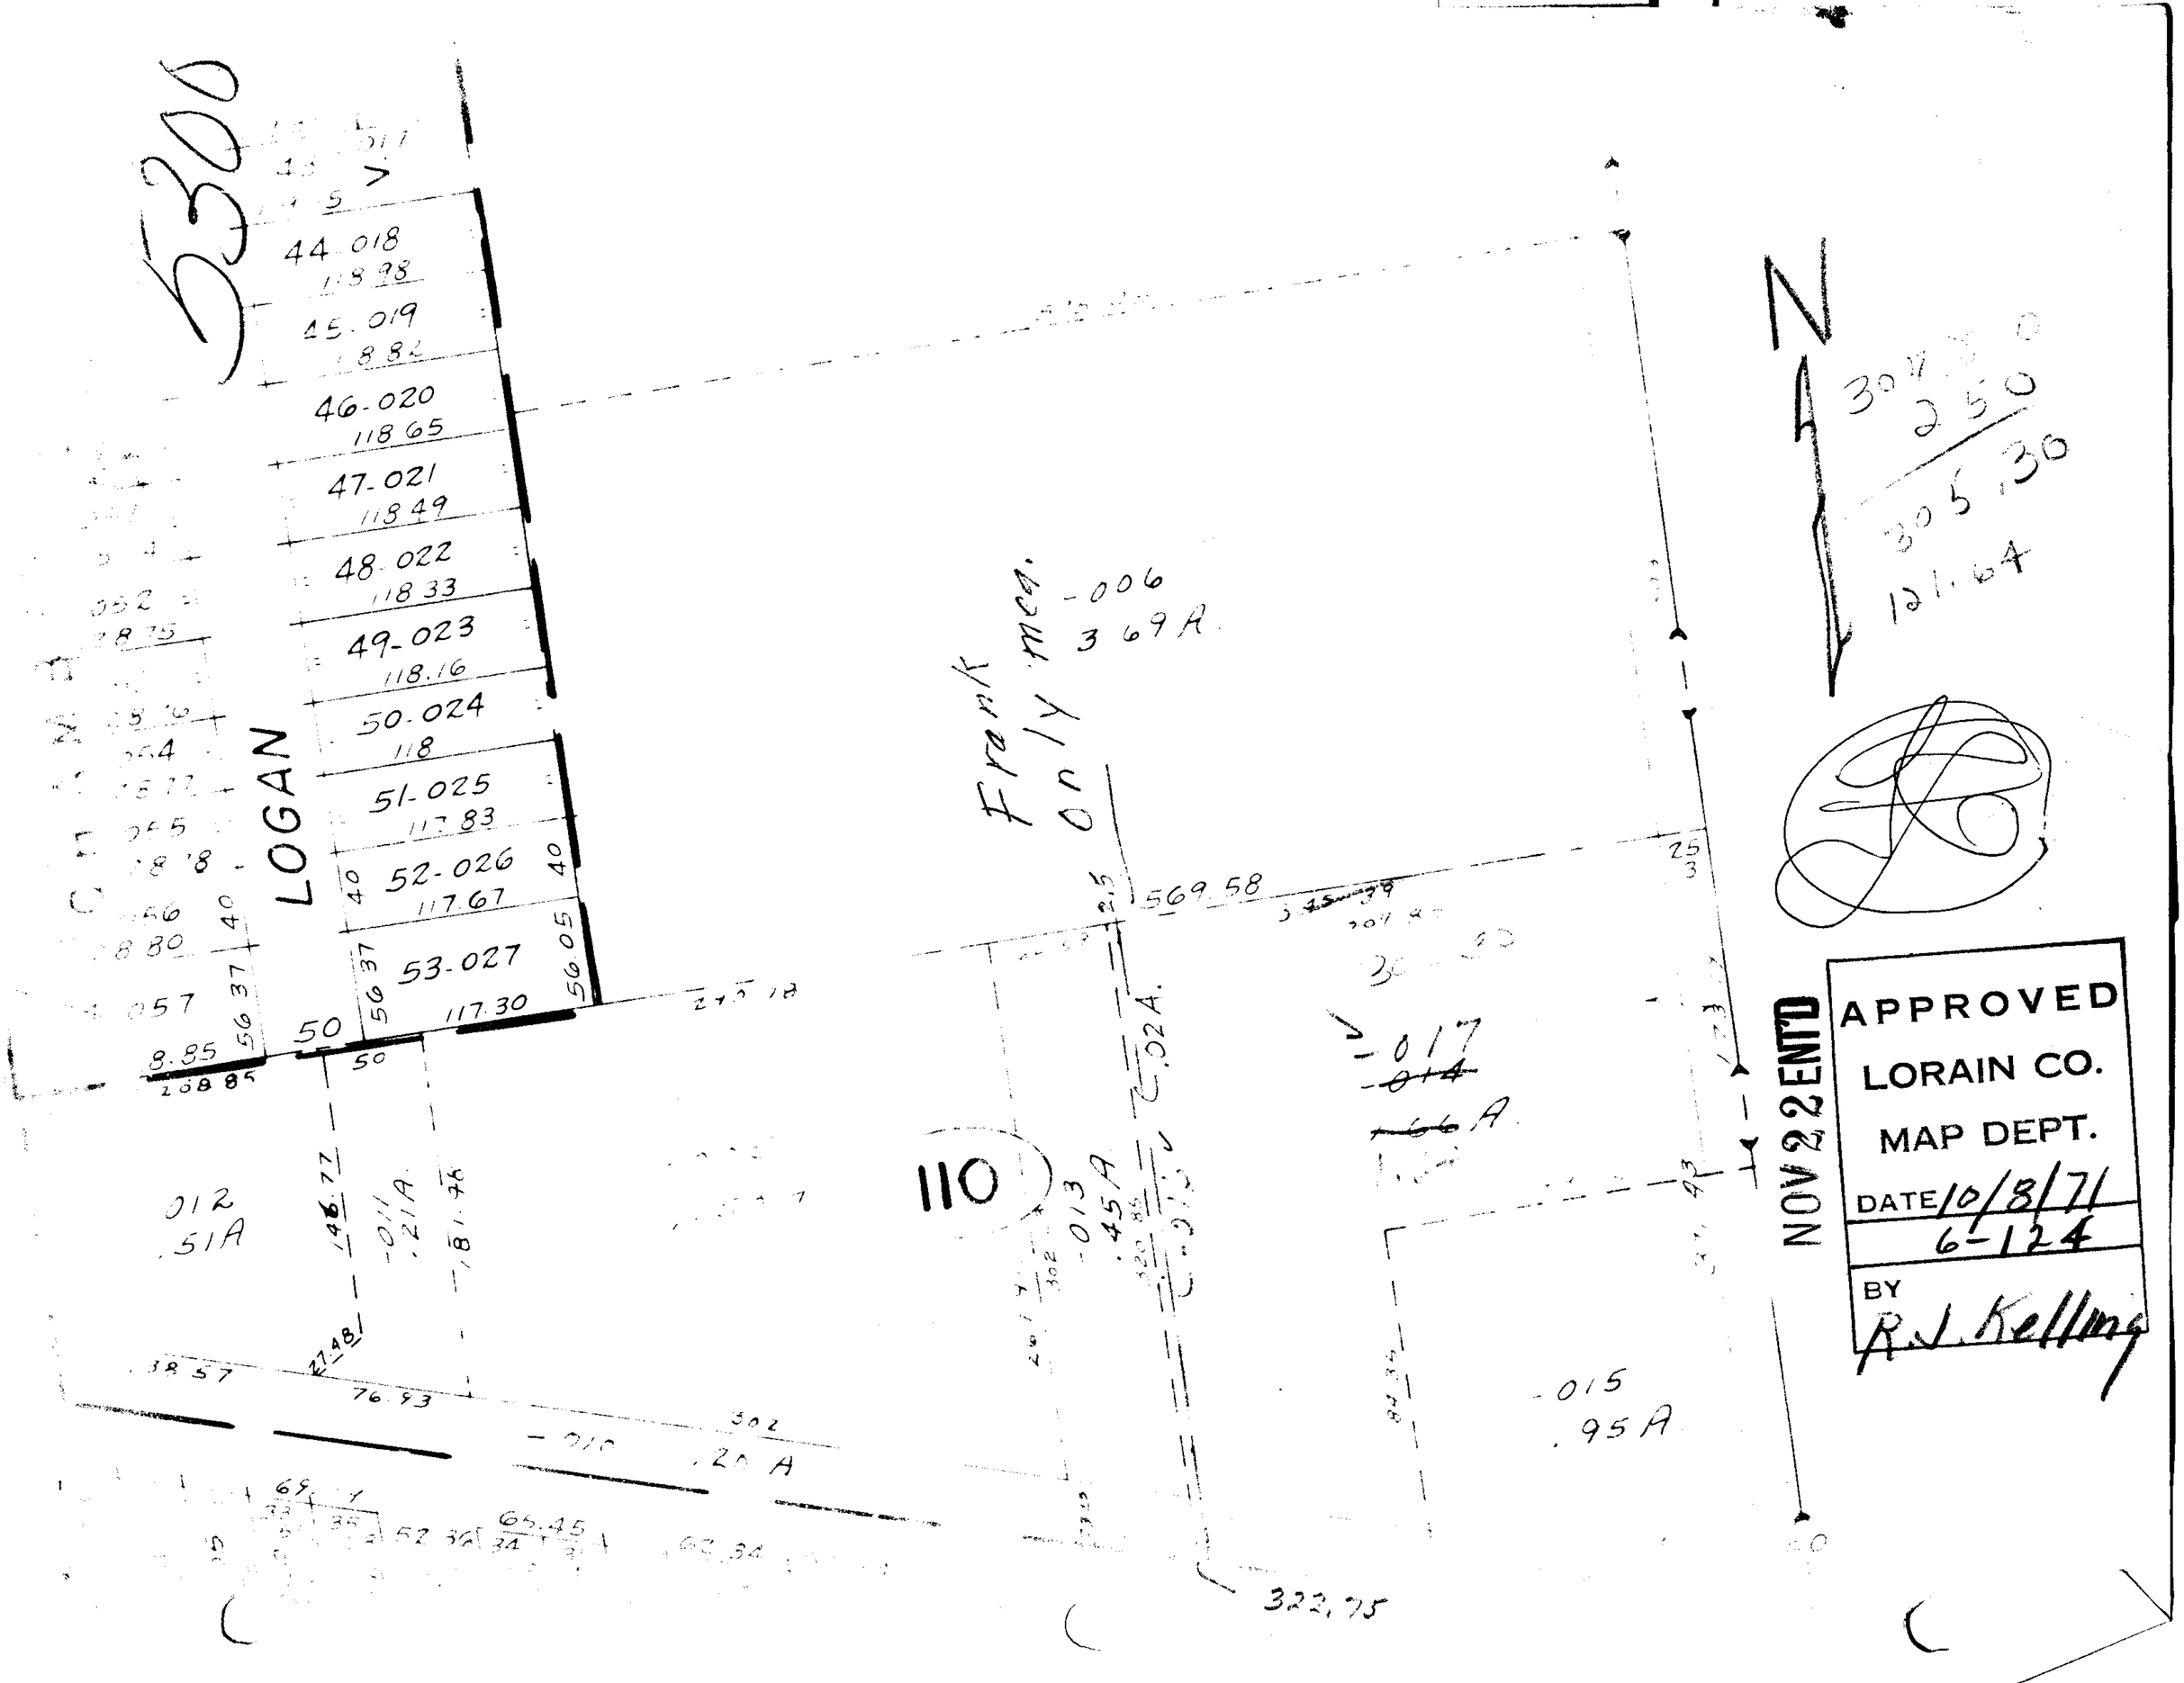
5300
LOGAN
44.018
118.98
45.019
46.020
118.65
47.021
118.49
48.022
118.33
49.023
118.16
50.024
118
51.025
117.83
52.026
117.67
53.027
117.30
Frank
only mea.
-006
3.69A
569.58
-017
-014
-66A
110
-013
.45A
-012
.51A
-011
.21A
-015
.95A
322.75
N
305.30
121.64
NOV 22 ENT'D
APPROVED
LORAIN CO.
MAP DEPT.
DATE 10/8/71
6-124
BY
R.J. Kelling