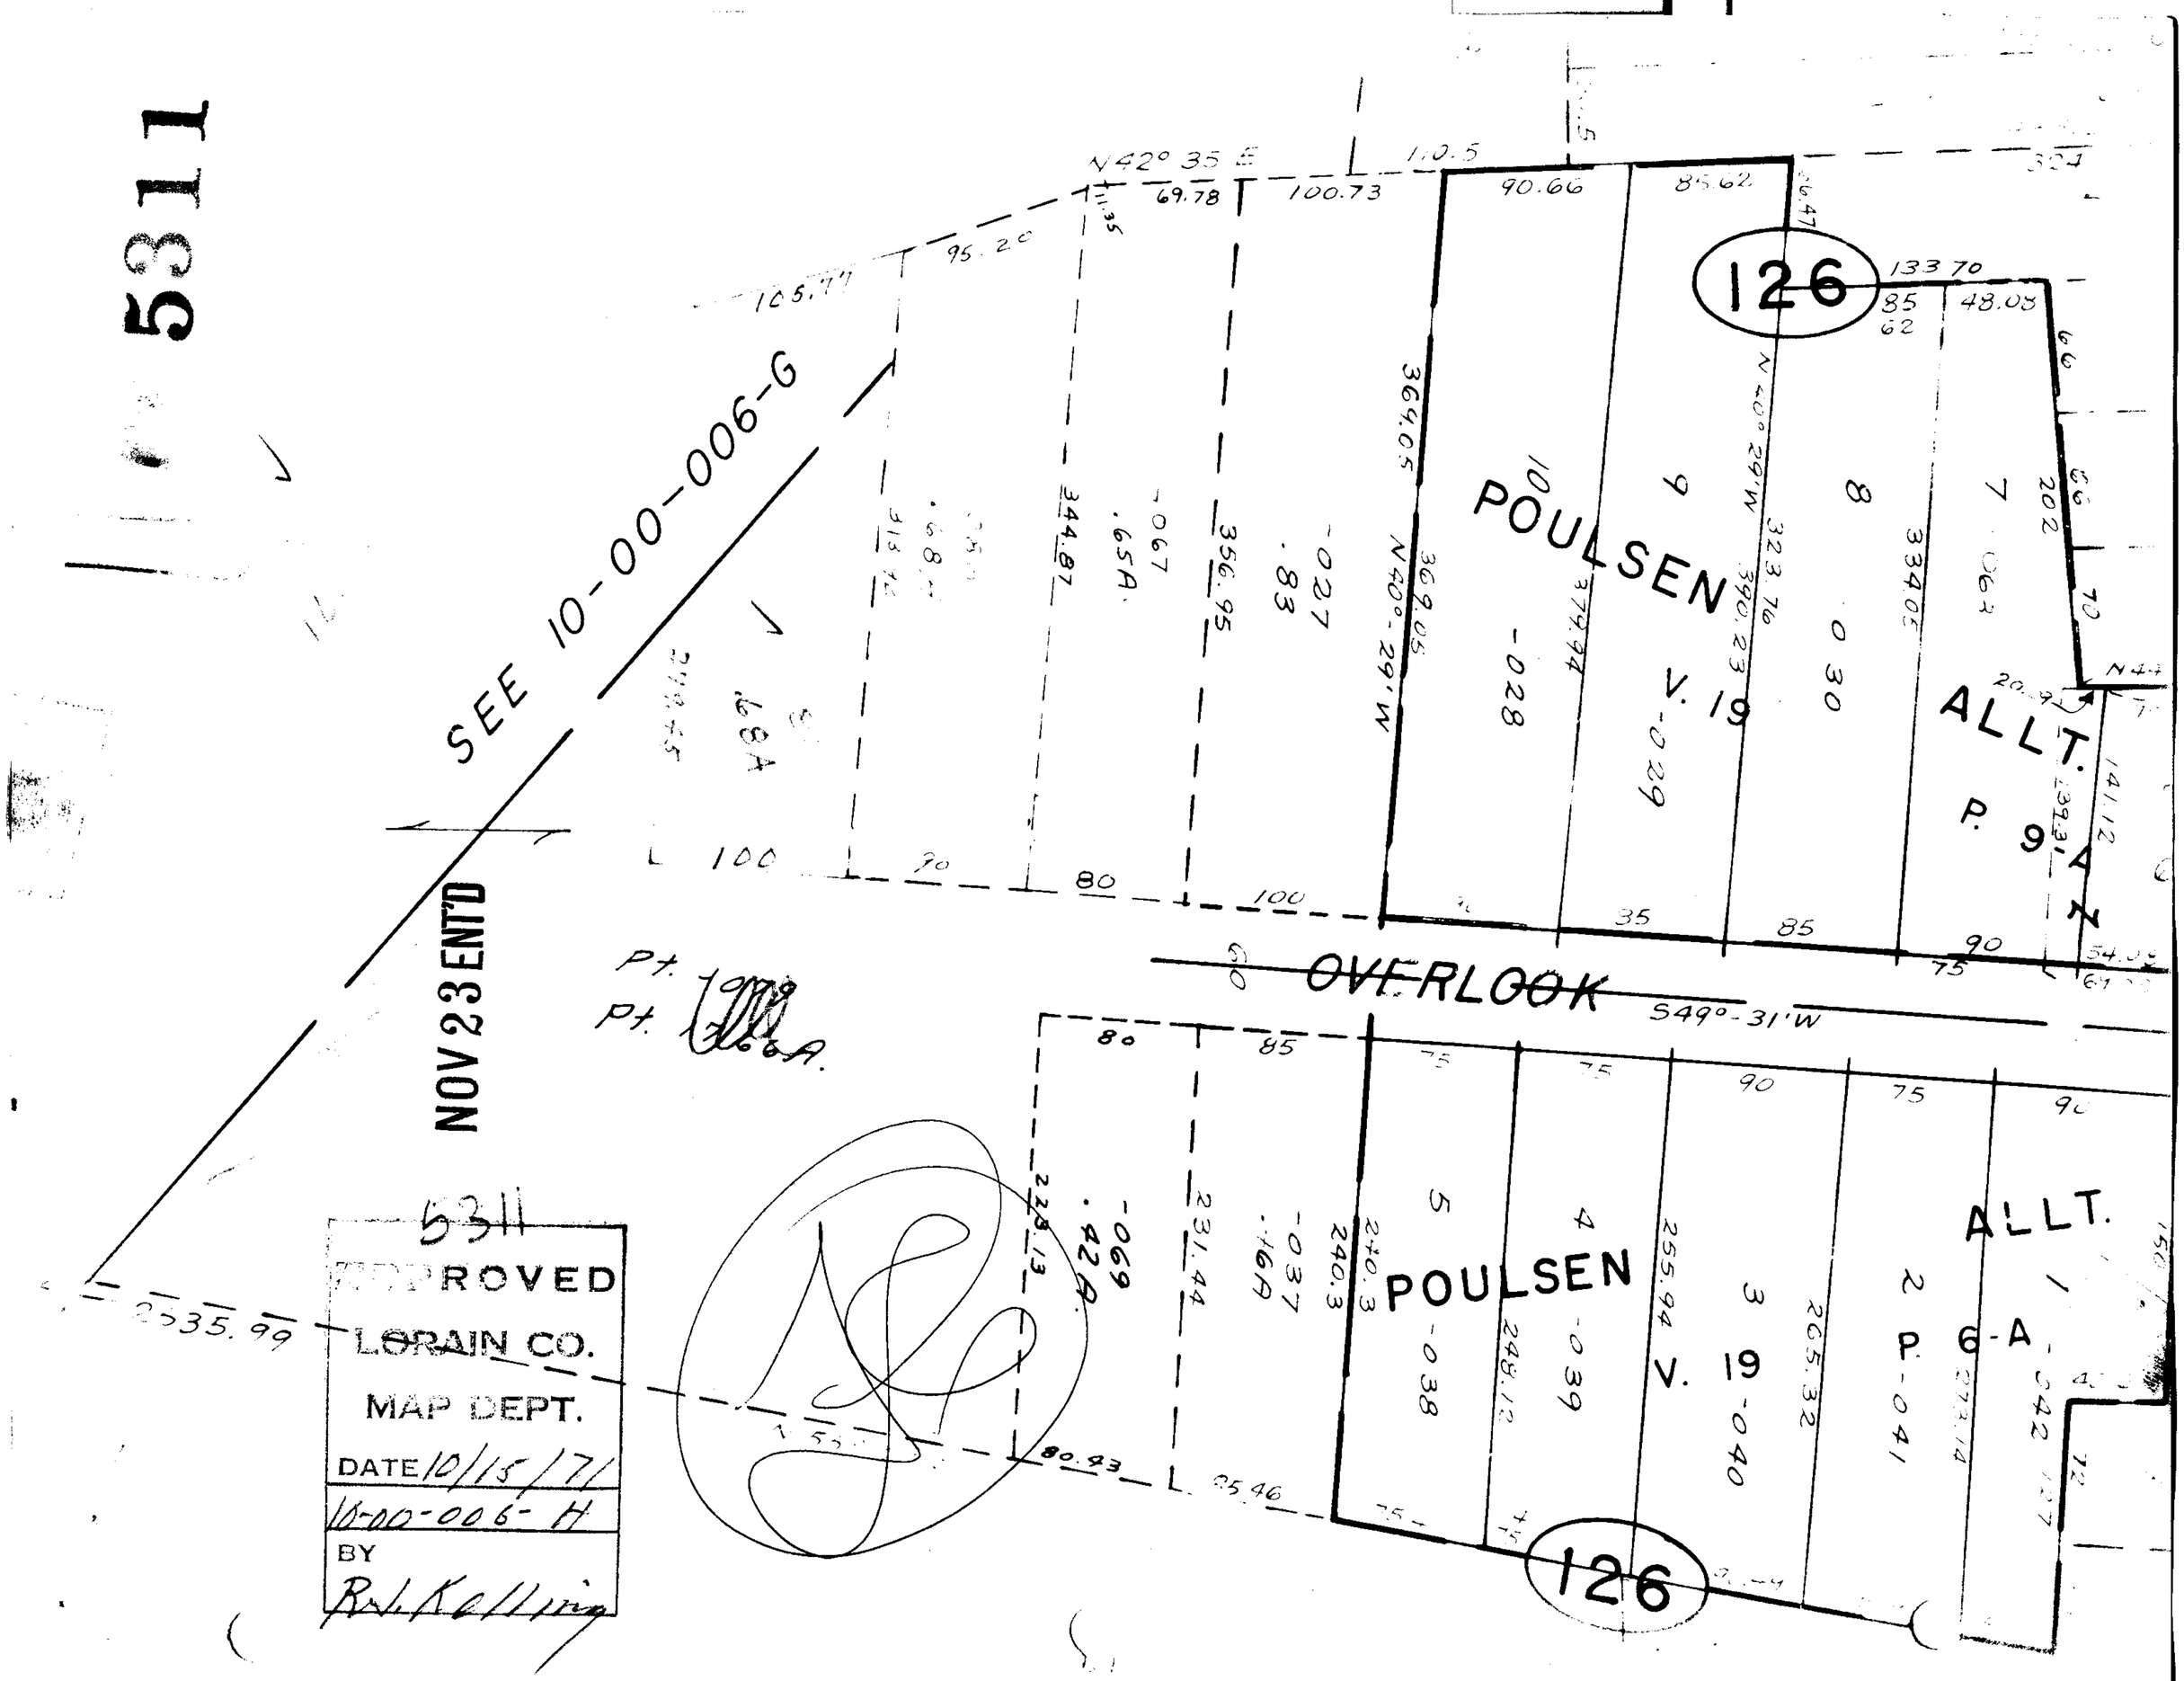
5311
SEE 10-00-006-G
NOV 23 ENT'D
N42° 35 E
126
POULSEN
V. 19
ALLT.
P. 9-A
OVERLOOK
S49°-31'W
POULSEN
V. 19
ALLT.
P. 6-A
126
5311
APPROVED
LORAIN CO.
MAP DEPT.
DATE 10/15/71
10-00-006-H
BY
R.L. Kolling