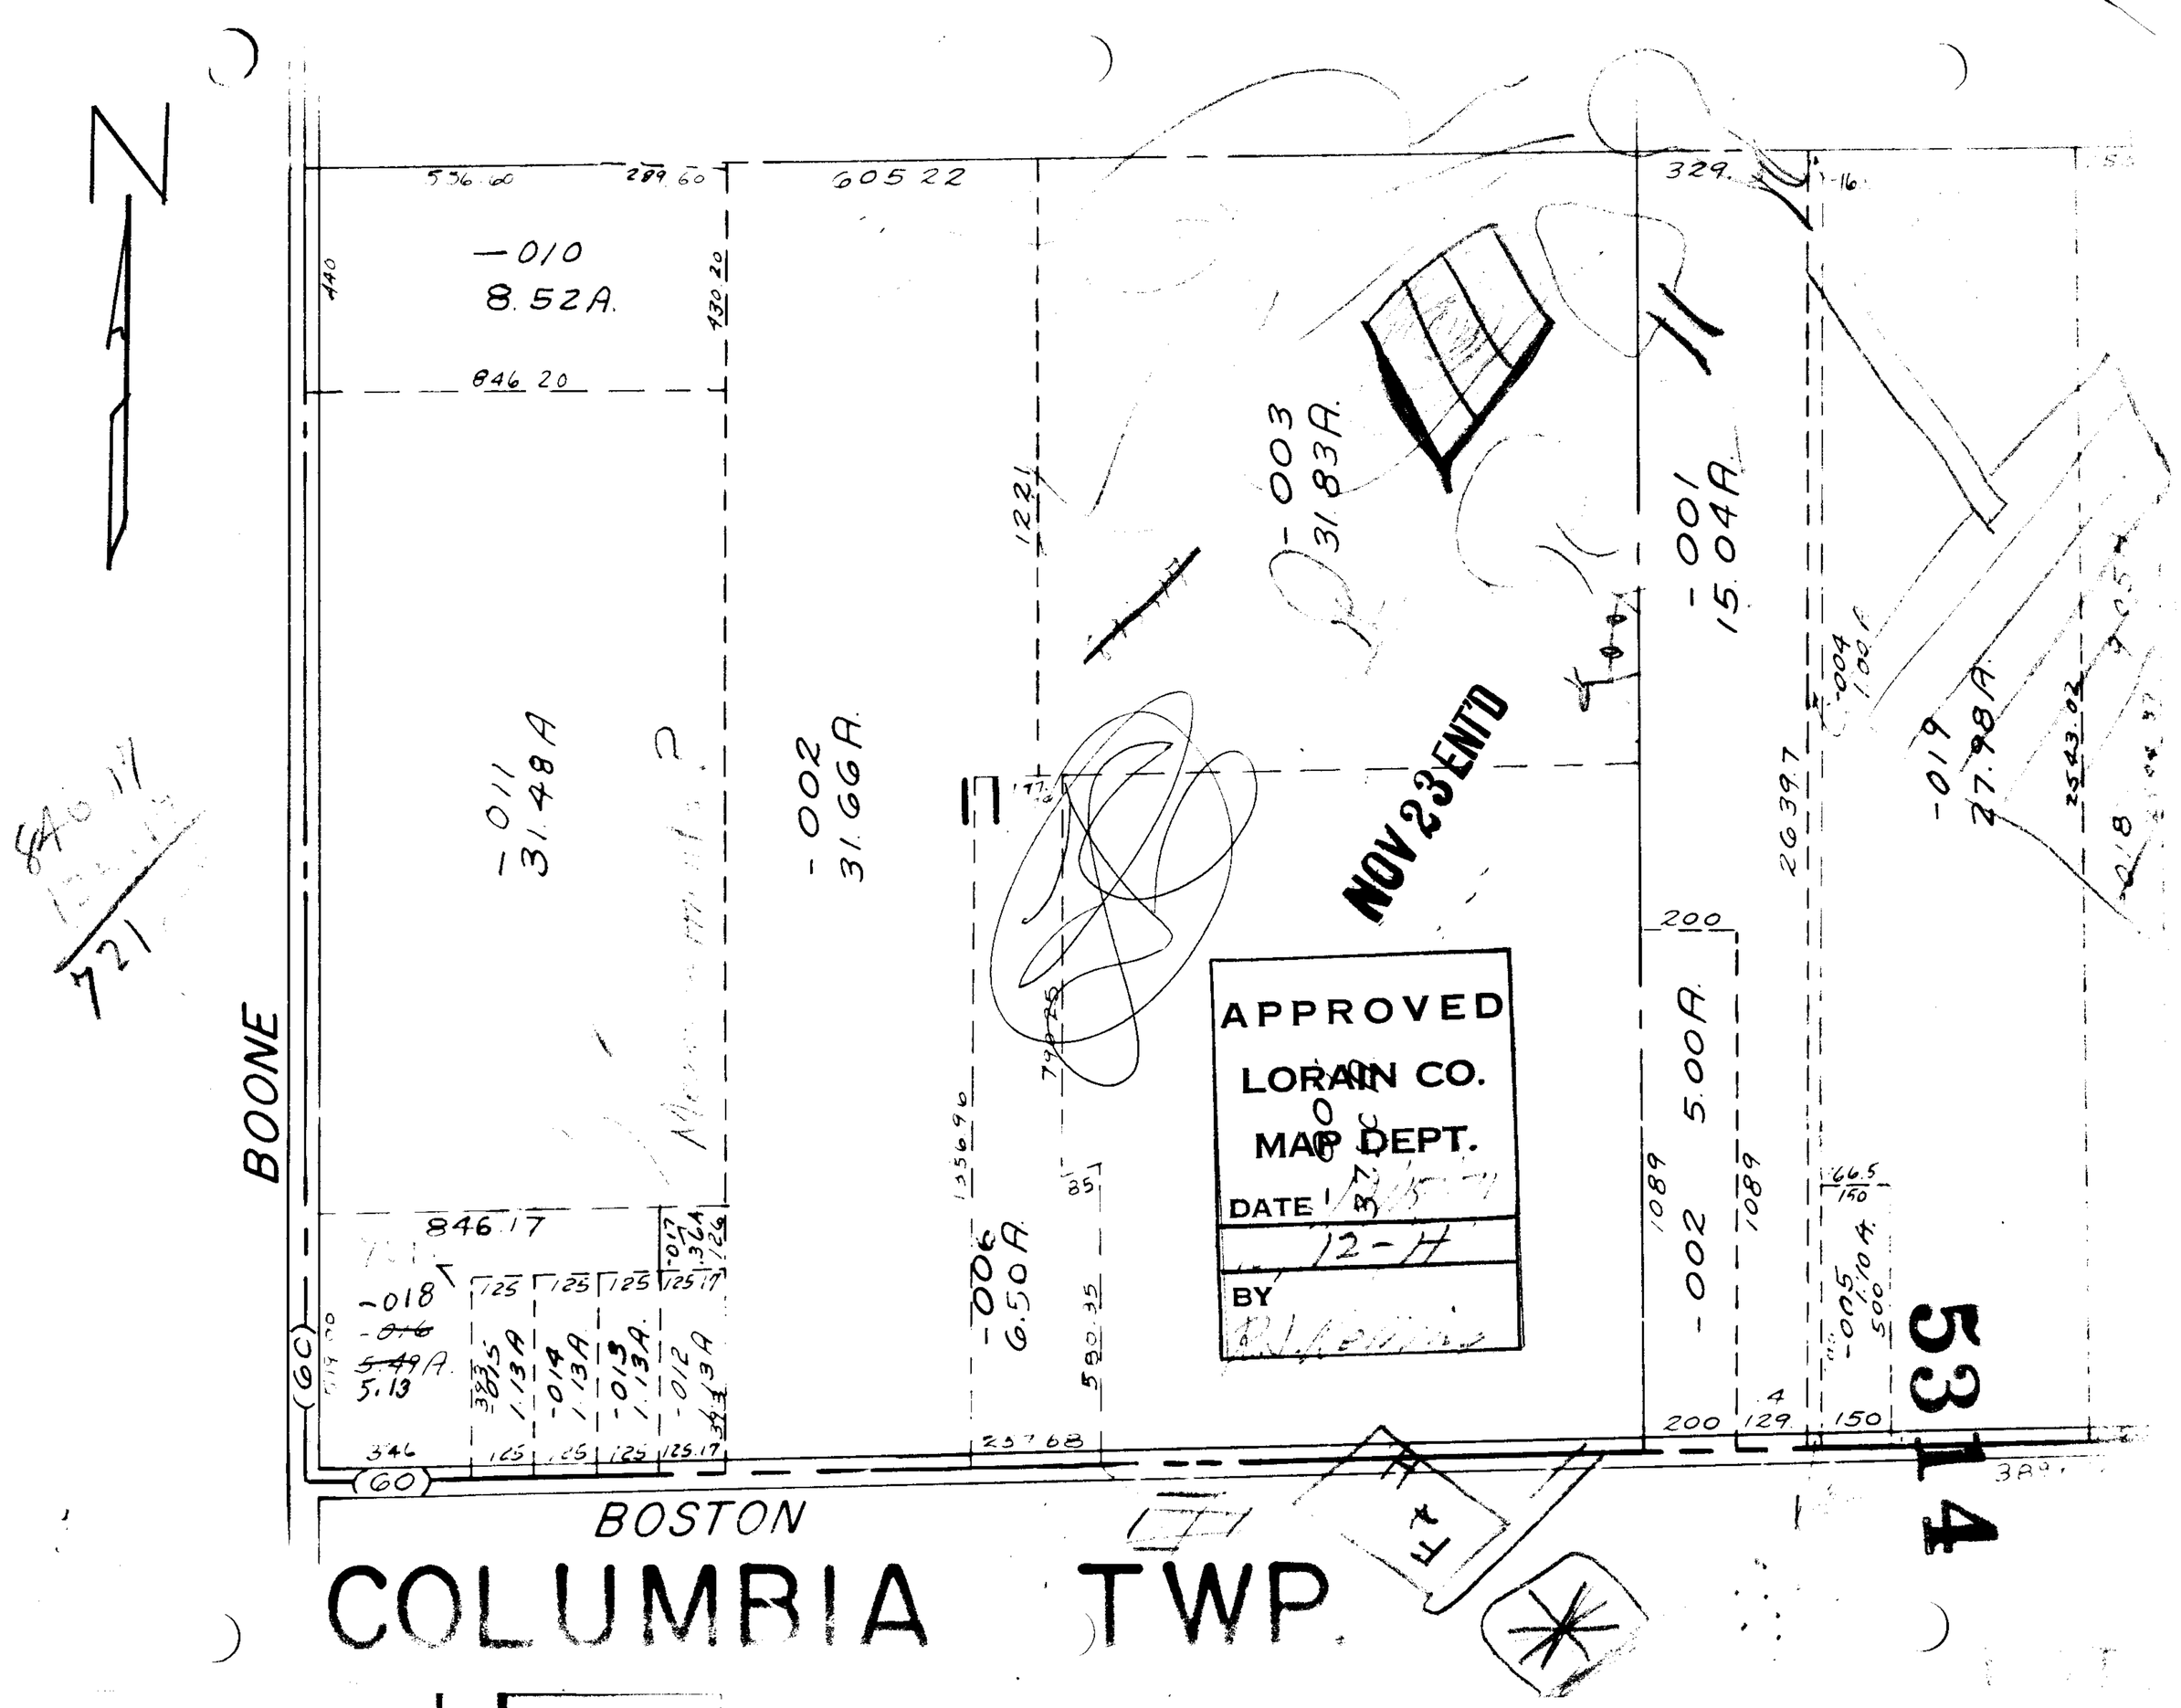

N
BOONE
BOSTON
COLUMBIA TWP.
-010
8.52A.
-011
31.48A
-002
31.66A.
-003
31.83A.
-001
15.04A.
-019
27.98A.
-006
6.50A.
-002
5.00A.
-018
5.13
-015
1.13A
-014
1.13A
-013
1.13A.
-012
1.13A
-004
1.00A
-005
1.10A.
NOV 23 ENT'D
APPROVED
LORAIN CO.
MAP DEPT.
DATE
12-H
BY
5314