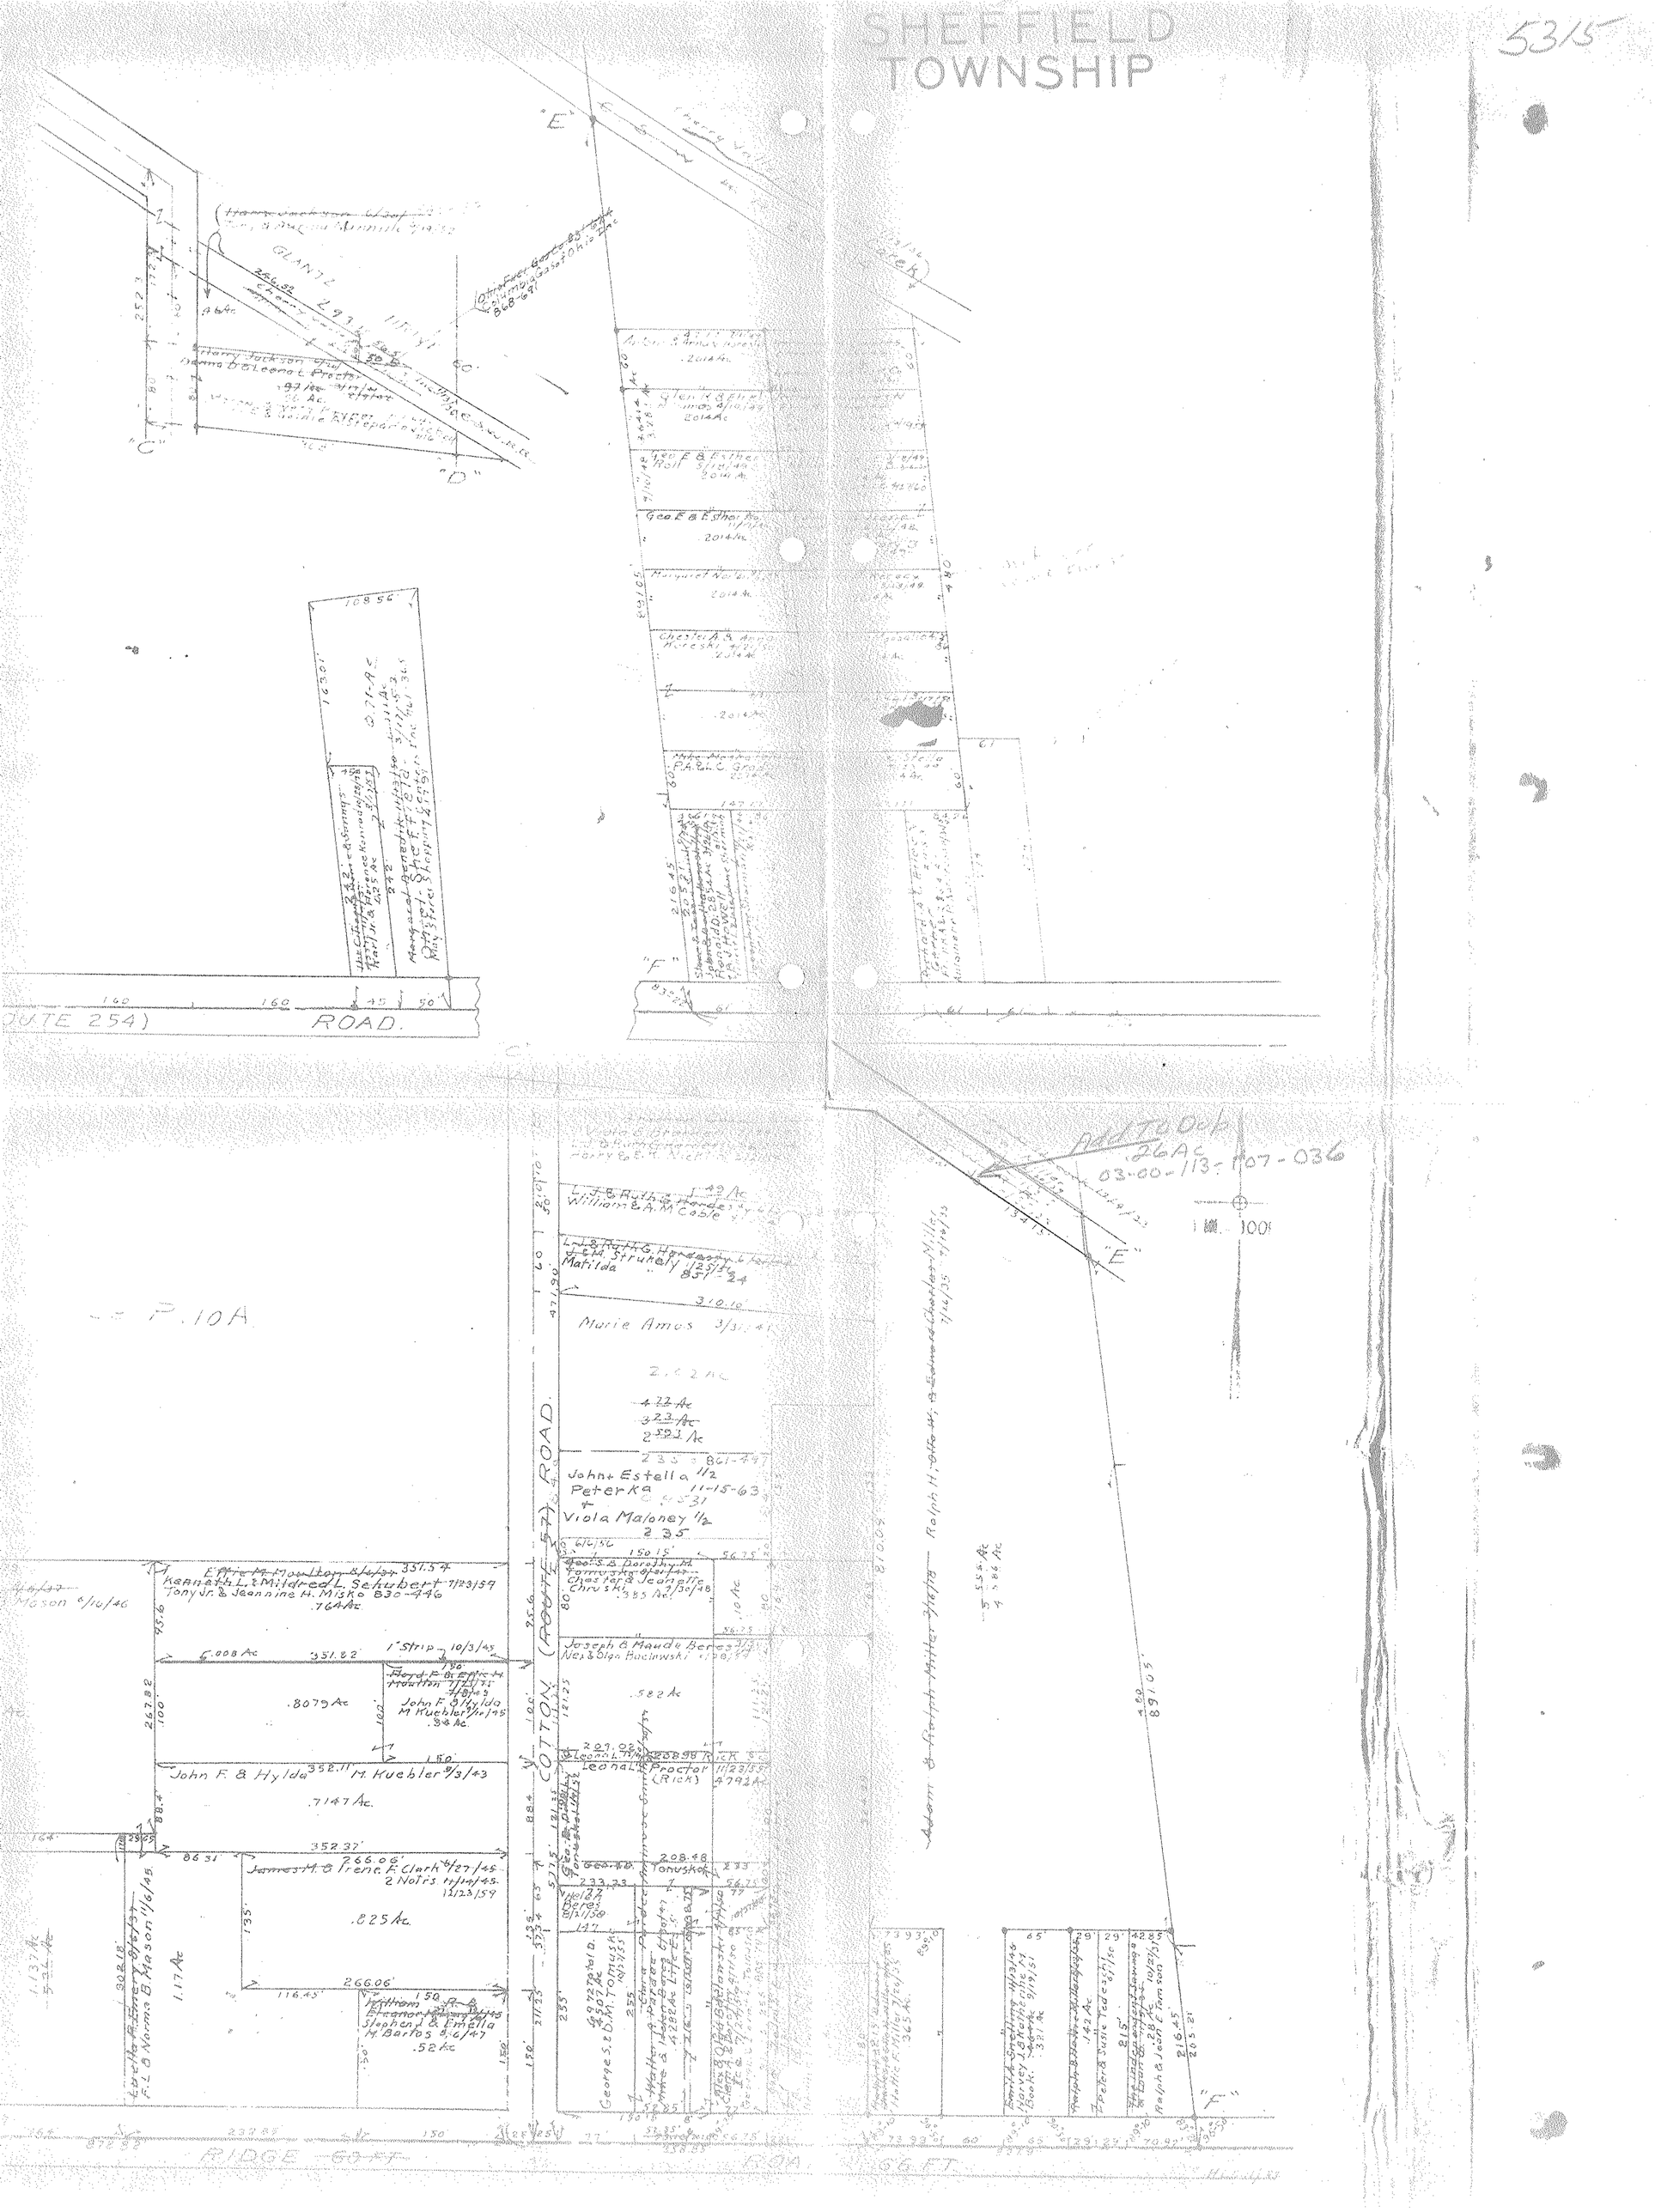
GLANTZ
"C"
"D"
"E"
"F"
ROAD.
COTTON (ROUTE 57) ROAD
Marie Amos
John + Estella 1/2
Peterka
+
Viola Maloney 1/2
Kenneth L. & Mildred L. Schubert
Tony Jr. & Jeannine H. Misko
John F. & Hylda M. Kuebler
Joseph & Maude Beres
Leonal L. Proctor (Rick)
Adam & Ralph Miller
Add To Dock
26 Ac
03-00-113-107-036
P.10A
RIDGE 66 FT
ROAD 66 FT