

5332
APPROVED
LORAIN
MAP D.
DATE 10-21-71
BY 55-133
7-00-017D

7-18-86 L.L.

5332

NOV 22 1971

SEE

CROSS


ST

AVE.

BLVD.

AVE.

HOME SITE

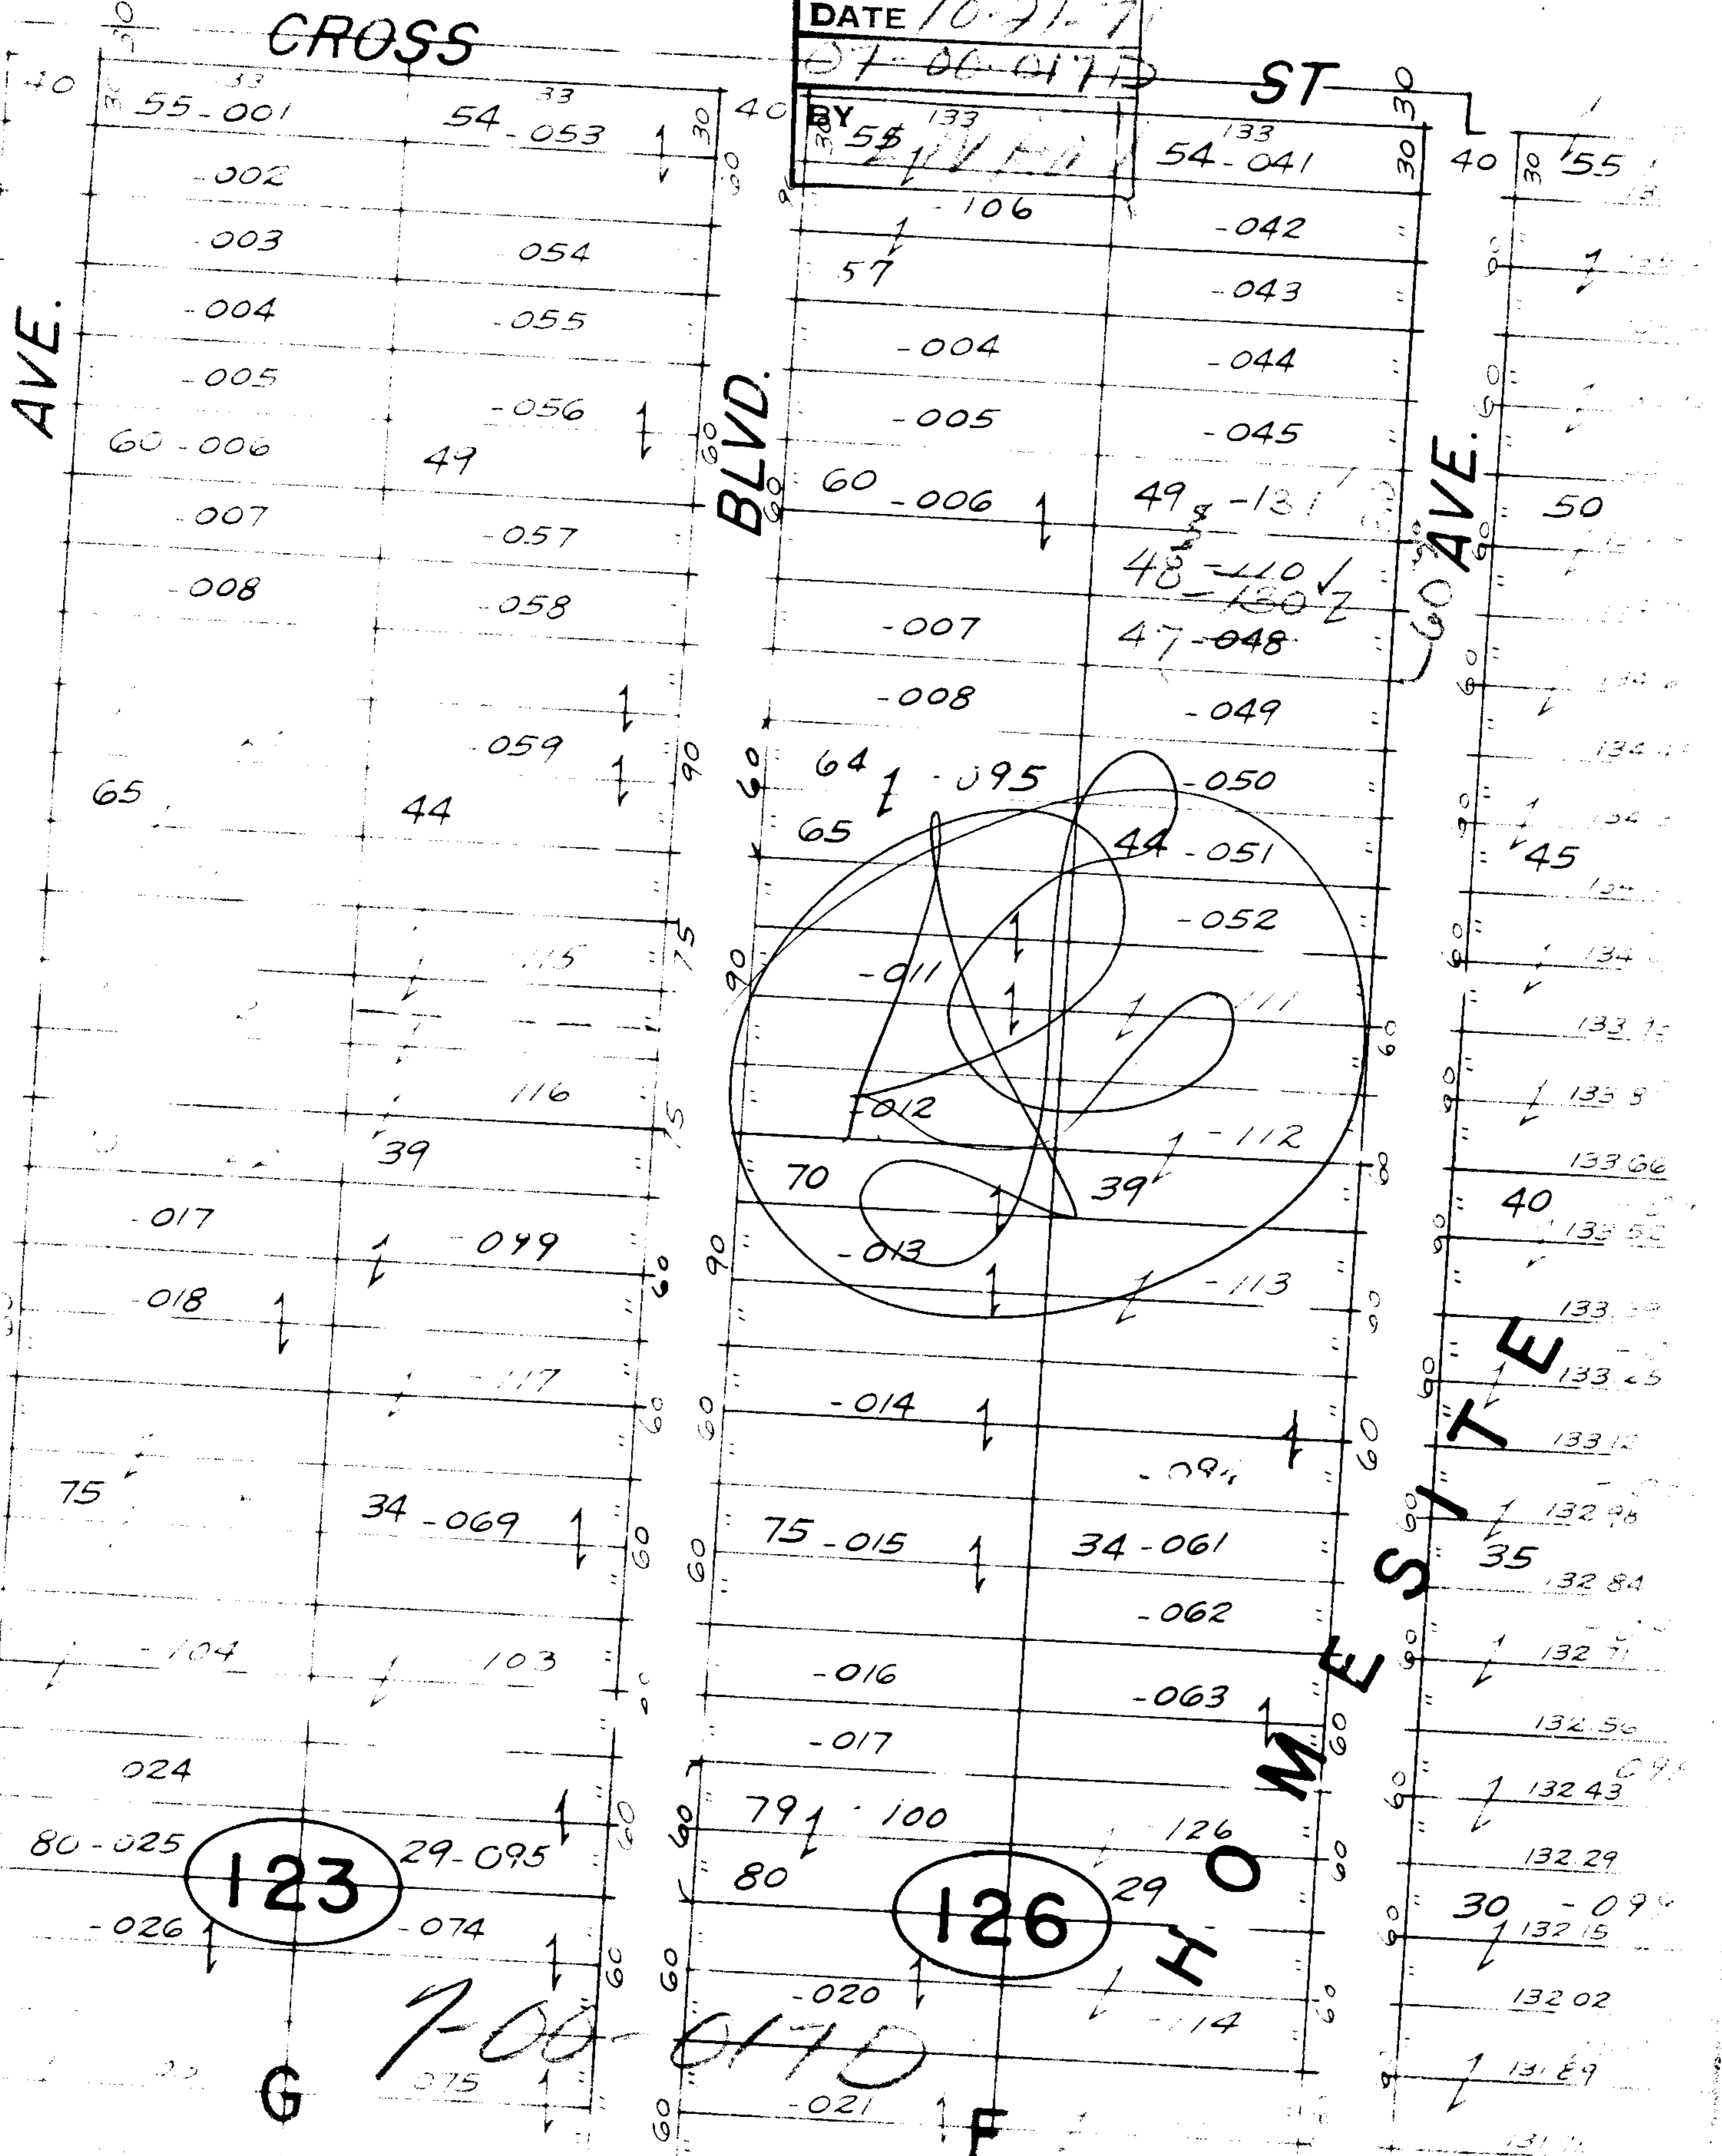

123

126

7-00-017D

G

F