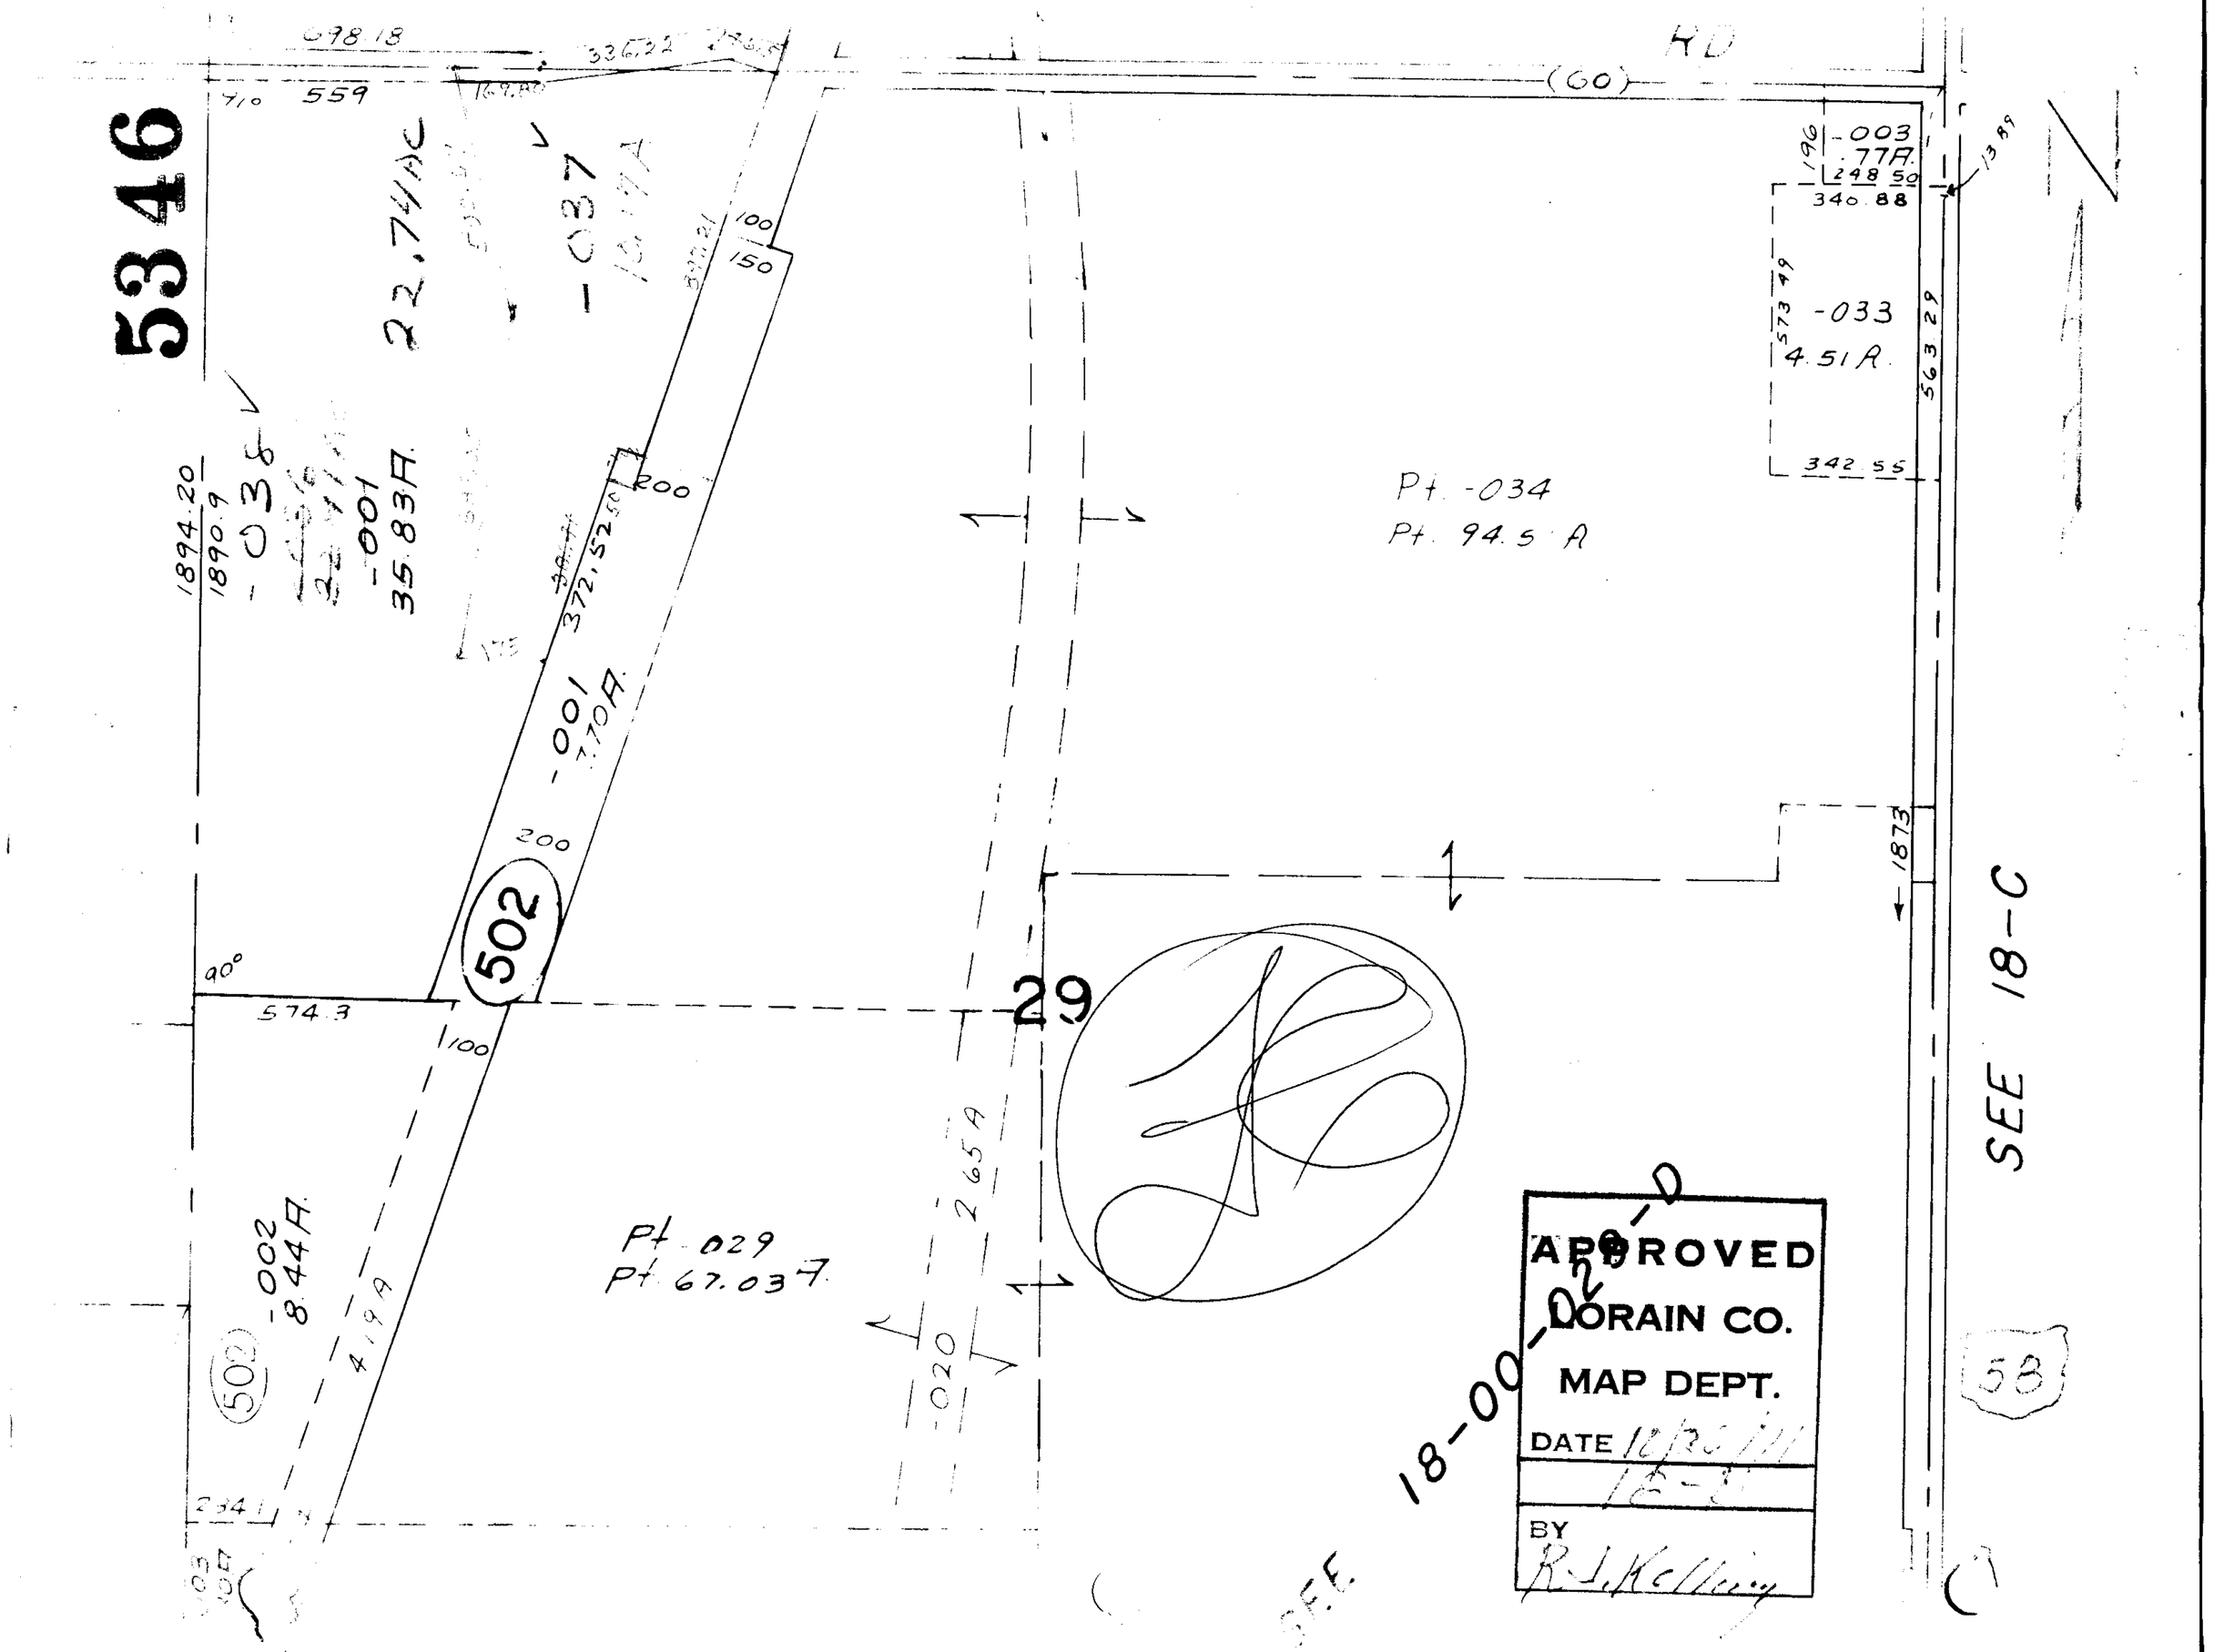
5346
698.18
559
336.22
(60)
RD
-003
.77A.
248.50
340.88
-033
4.51A.
342.55
563.29
573.49
1873
1894.20
1890.9
-038
-001
35.83A.
22.74AC
-037
100
150
200
372.52
-001
7.70A.
502
90°
574.3
100
29
Pt. -034
Pt. 94.5 A
Pt. 029
Pt. 67.03 A
-002
8.44A.
4.19A
2.65A
-020
SEE 18-C
58
APPROVED
LORAIN CO.
MAP DEPT.
DATE
BY
18-00-029-D