


5349

004
2.59

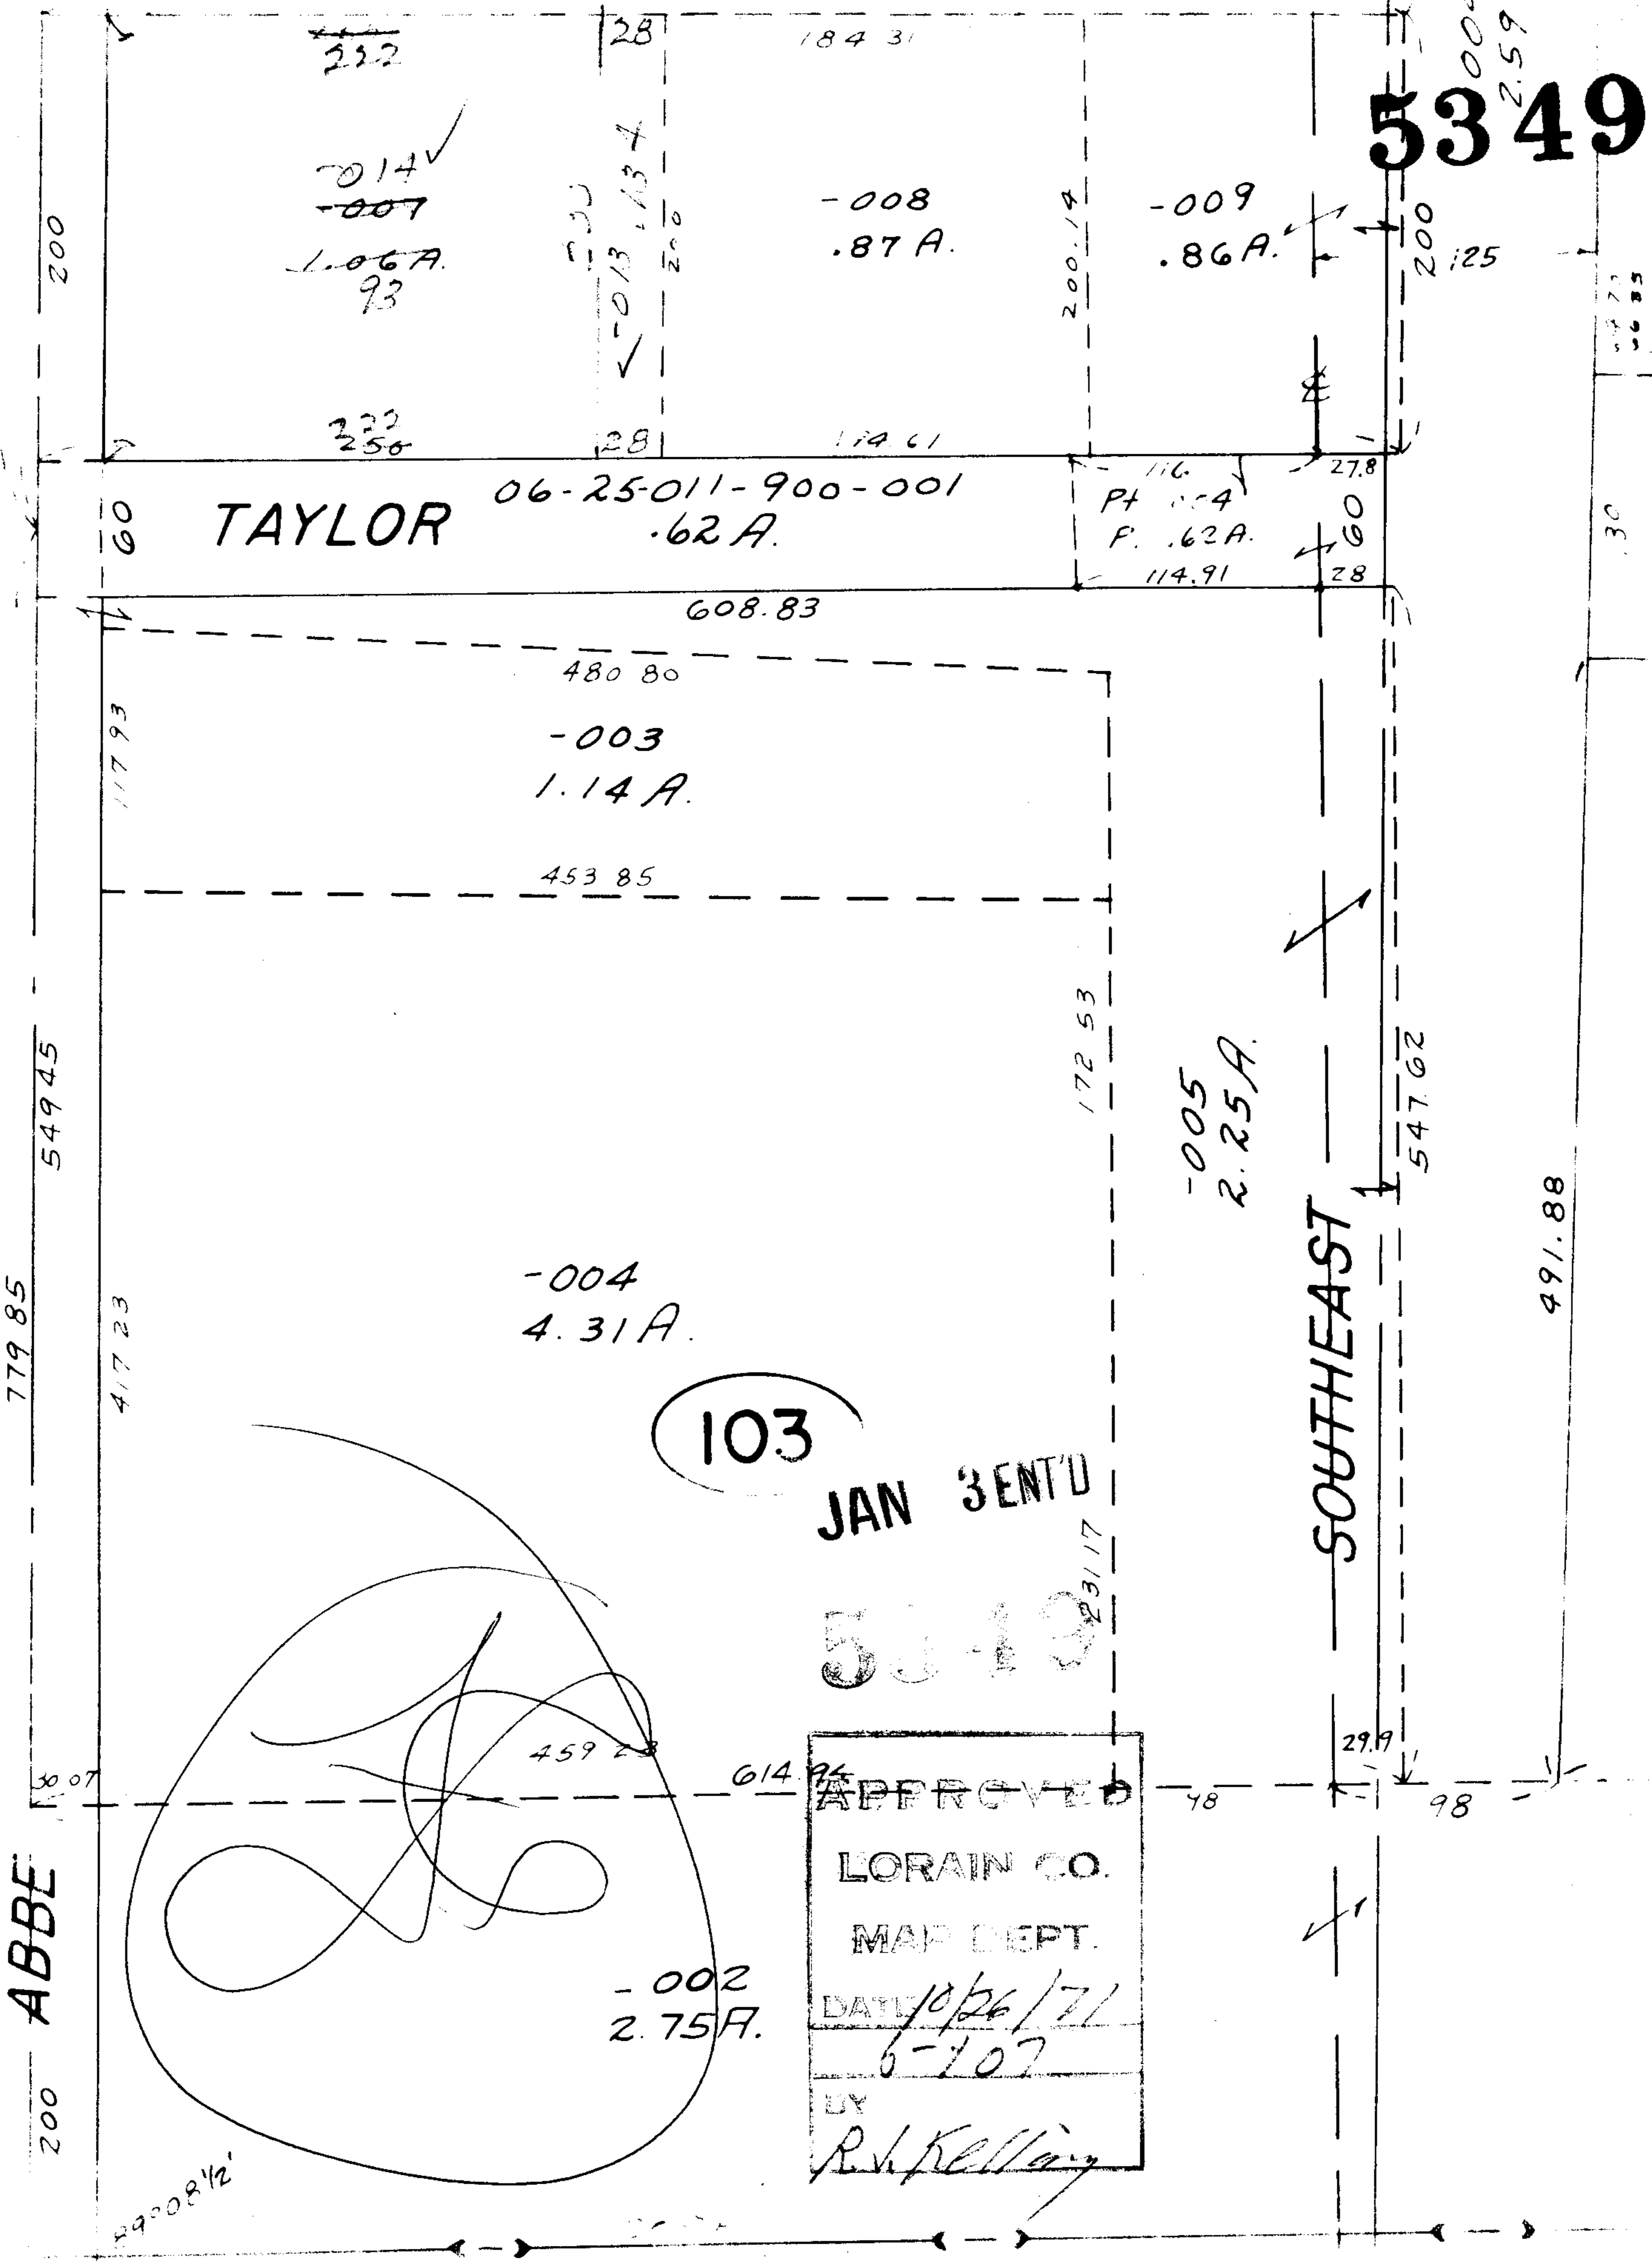

103


5349

APPROVED

LORAIN CO.

MAP DEPT.

DATE 10/26/71

6-707

BY R.H. Kelly

ABBE

SOUTHEAST

