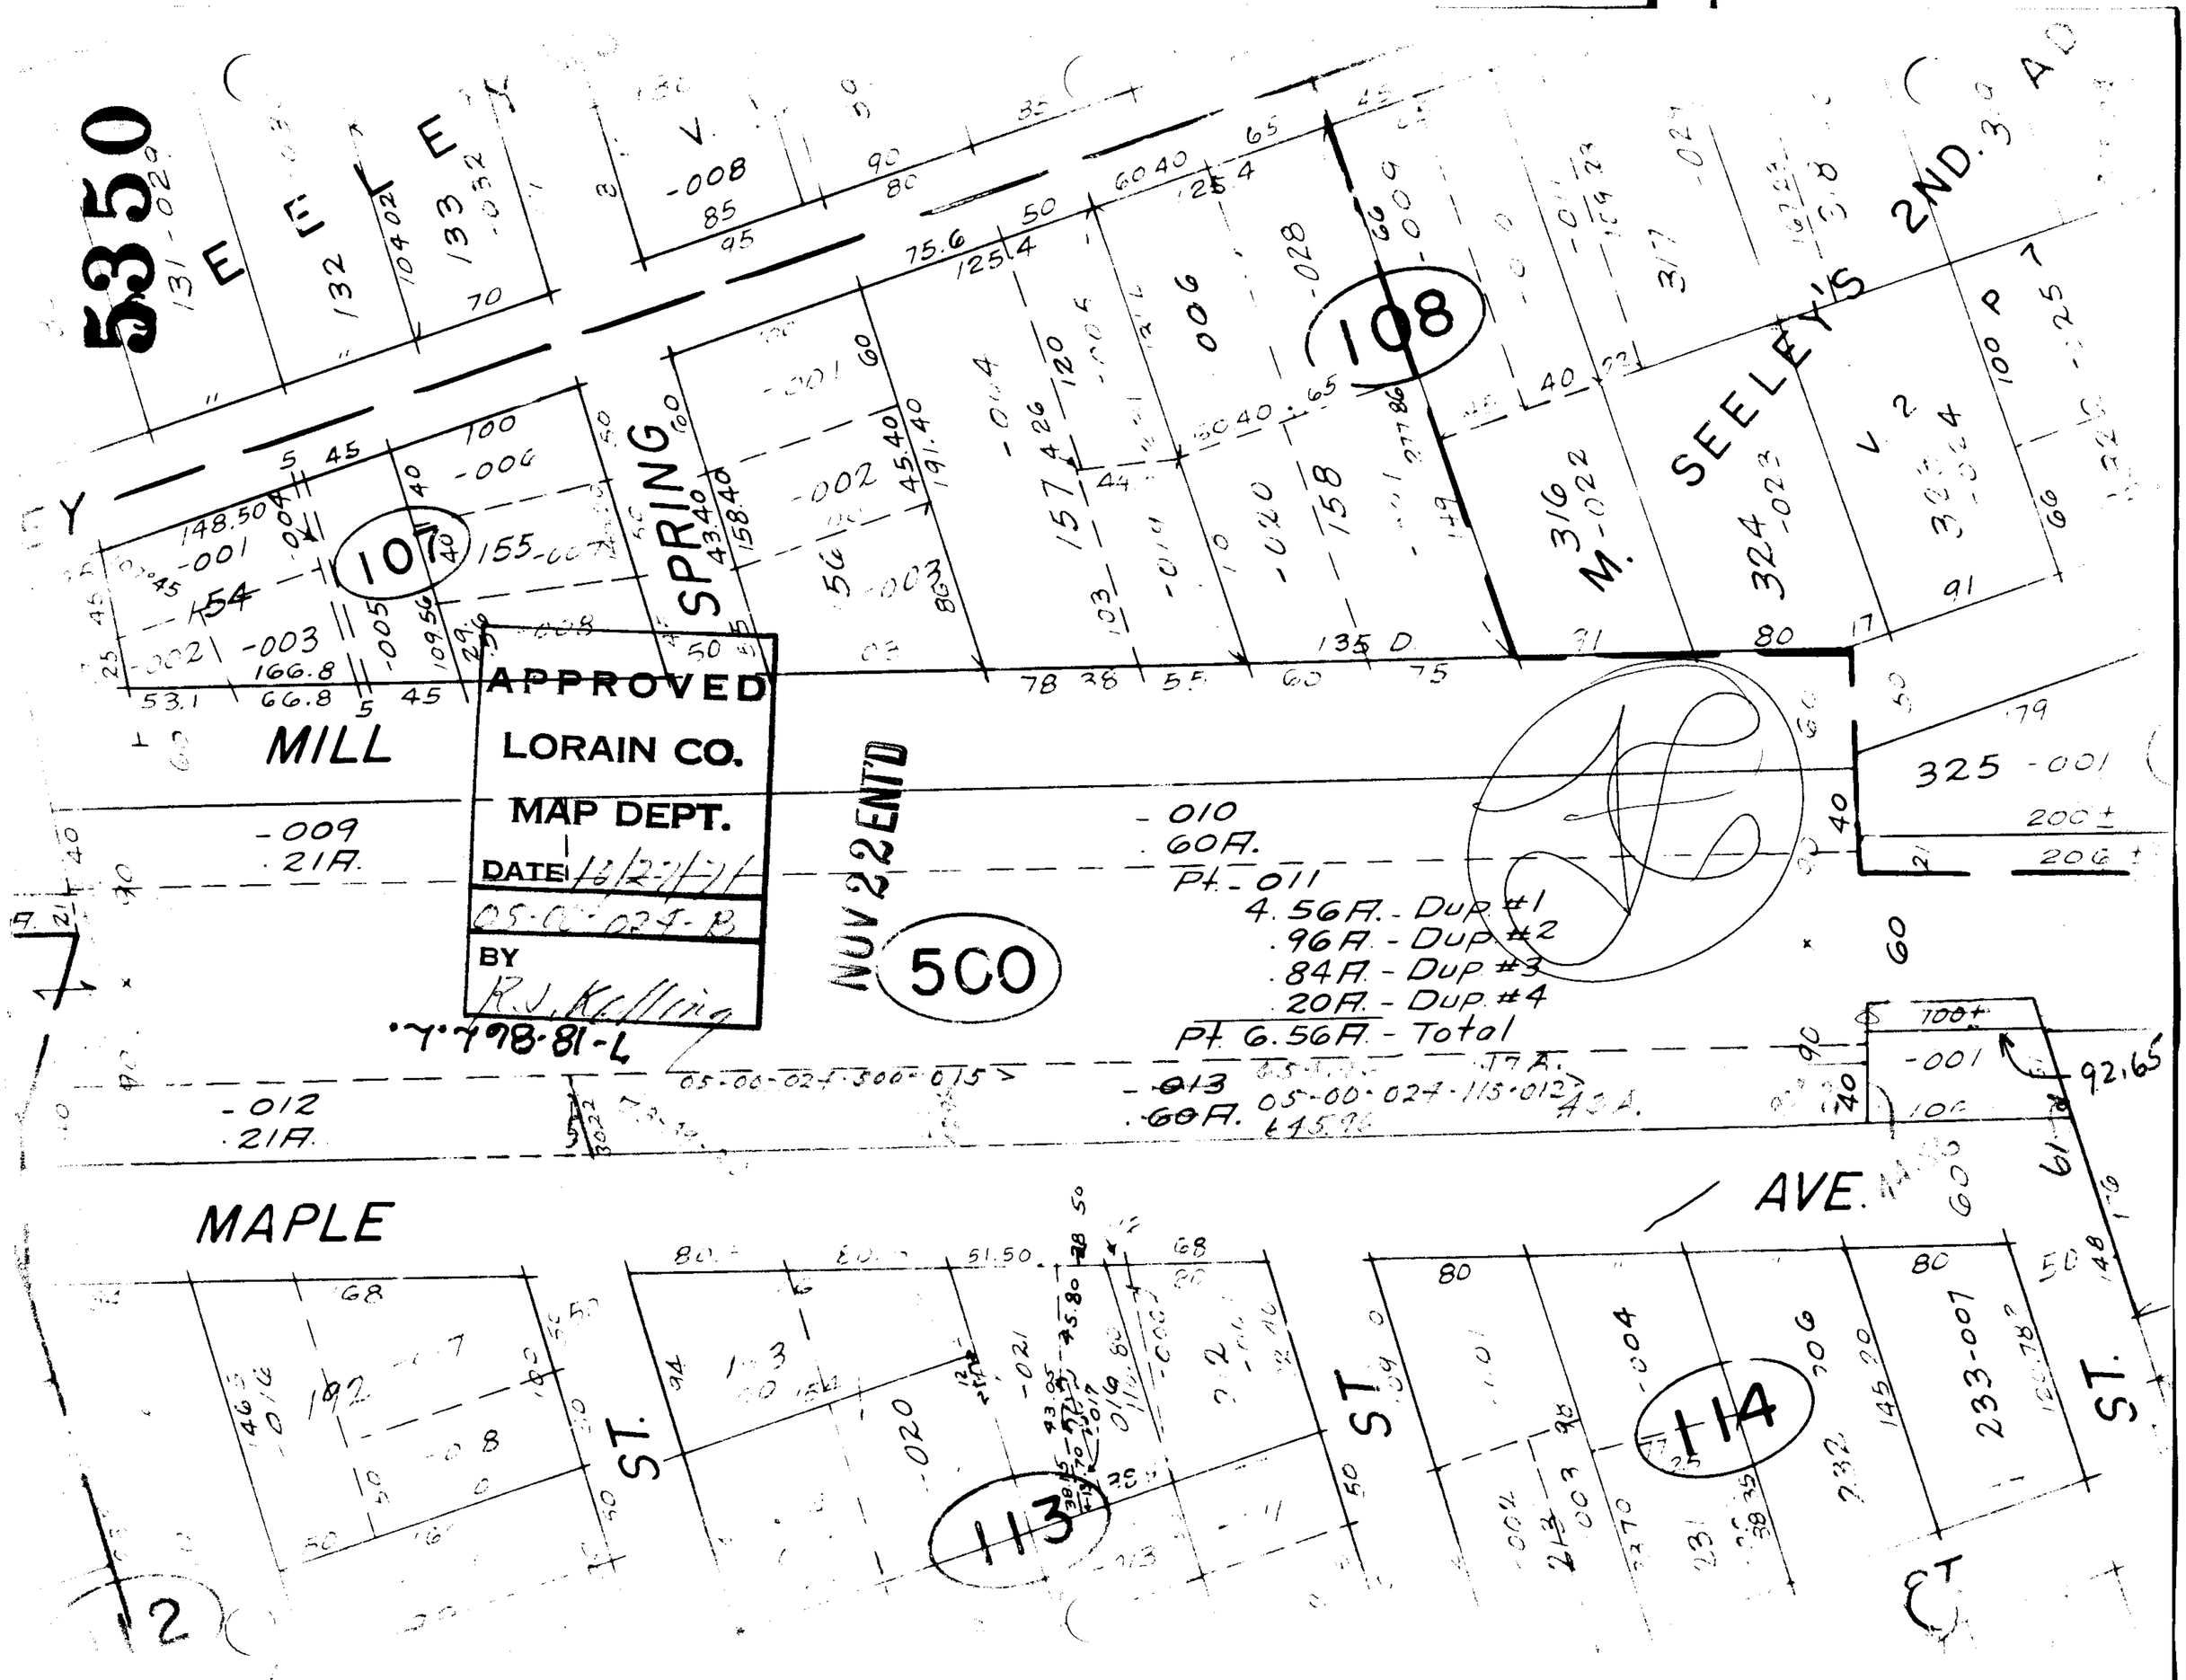
5350
SEELEY
SPRING
MILL
MAPLE
AVE.
SEELEY'S 2ND. AD
M.
NOV 22 ENT'D
APPROVED
LORAIN CO.
MAP DEPT.
DATE 10/27/71
05-00-024-B
BY
R.J. Kelling
107
108
500
113
114
Pt. 011
4.56A. - Dup #1
.96A. - Dup #2
.84A. - Dup #3
.20A. - Dup #4
Pt. 6.56A. - Total
05-00-024-500-015
05-00-024-115-012
92.65