




9-00-085A

9-00-085B

5354
SEE 9 C

ST. LORAIN

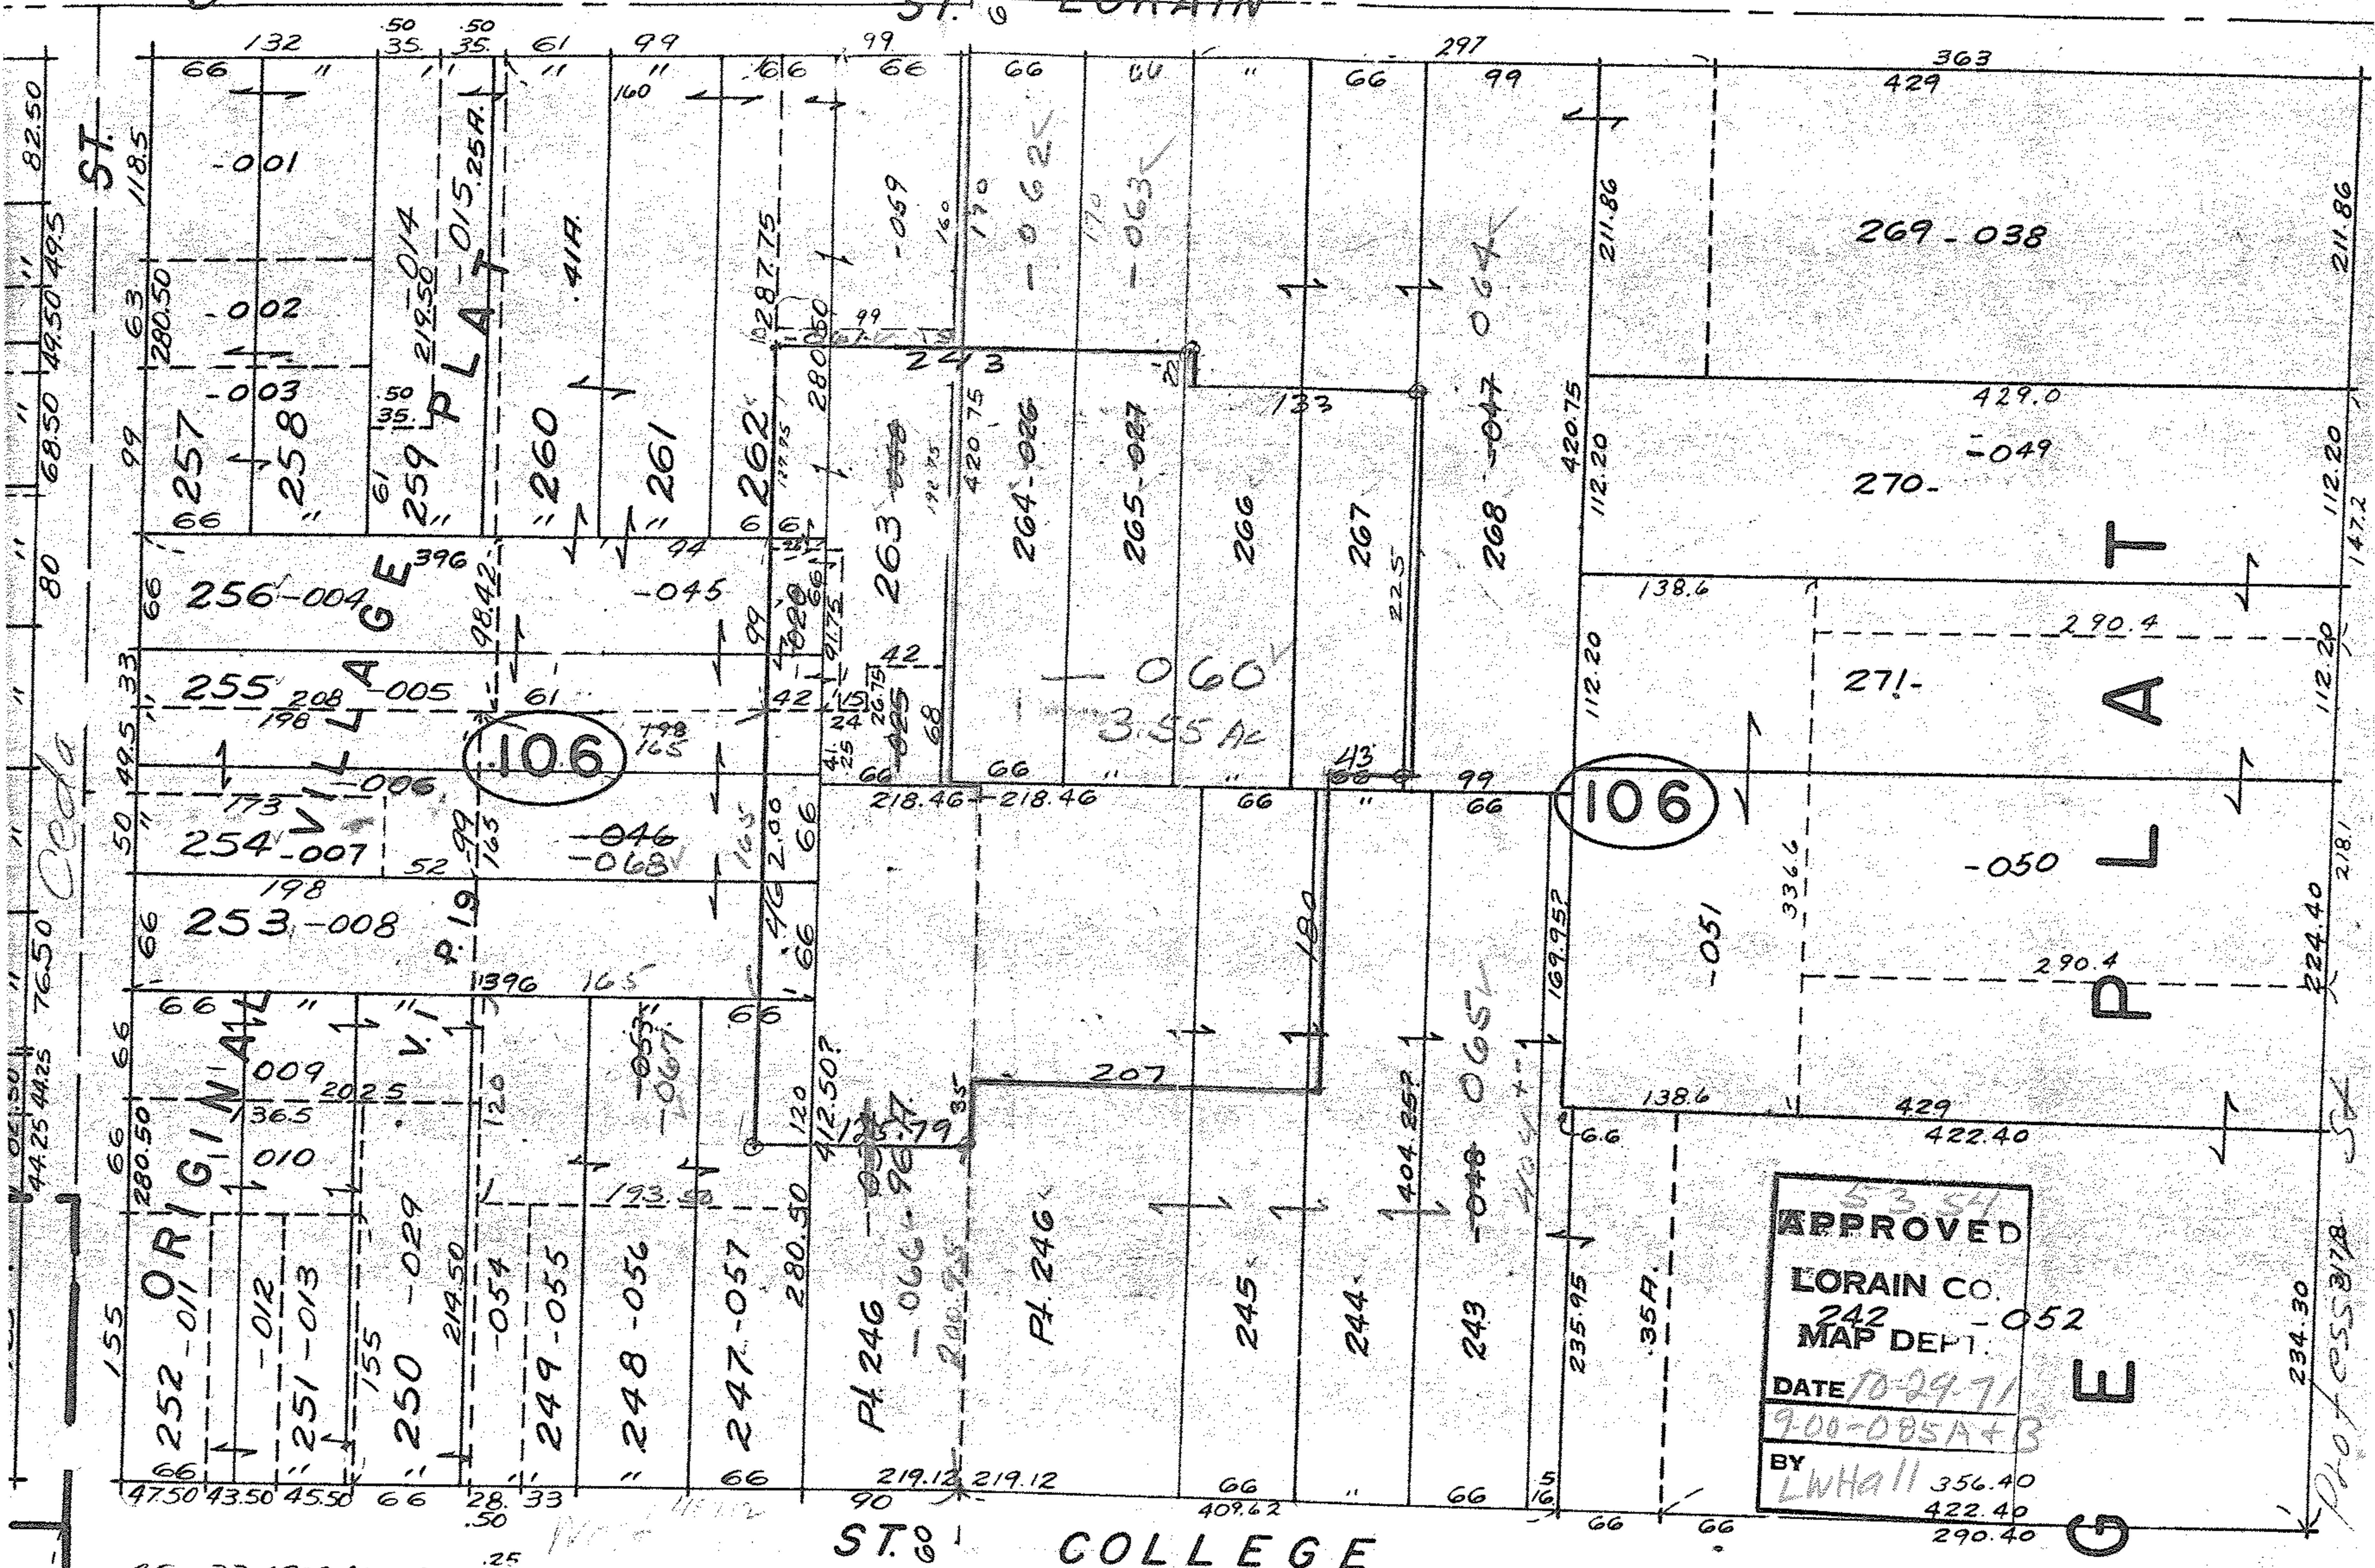

5354
APPROVED
 LORAIN CO.
 242 - 052
 MAP DEPT.
 DATE 10-29-71
 9-00-085A+B
 BY LWHall 356.40
 422.40
 290.40

234.30
 Professor

ST. COLLEGE