


SEE 10-00-006-B

5362

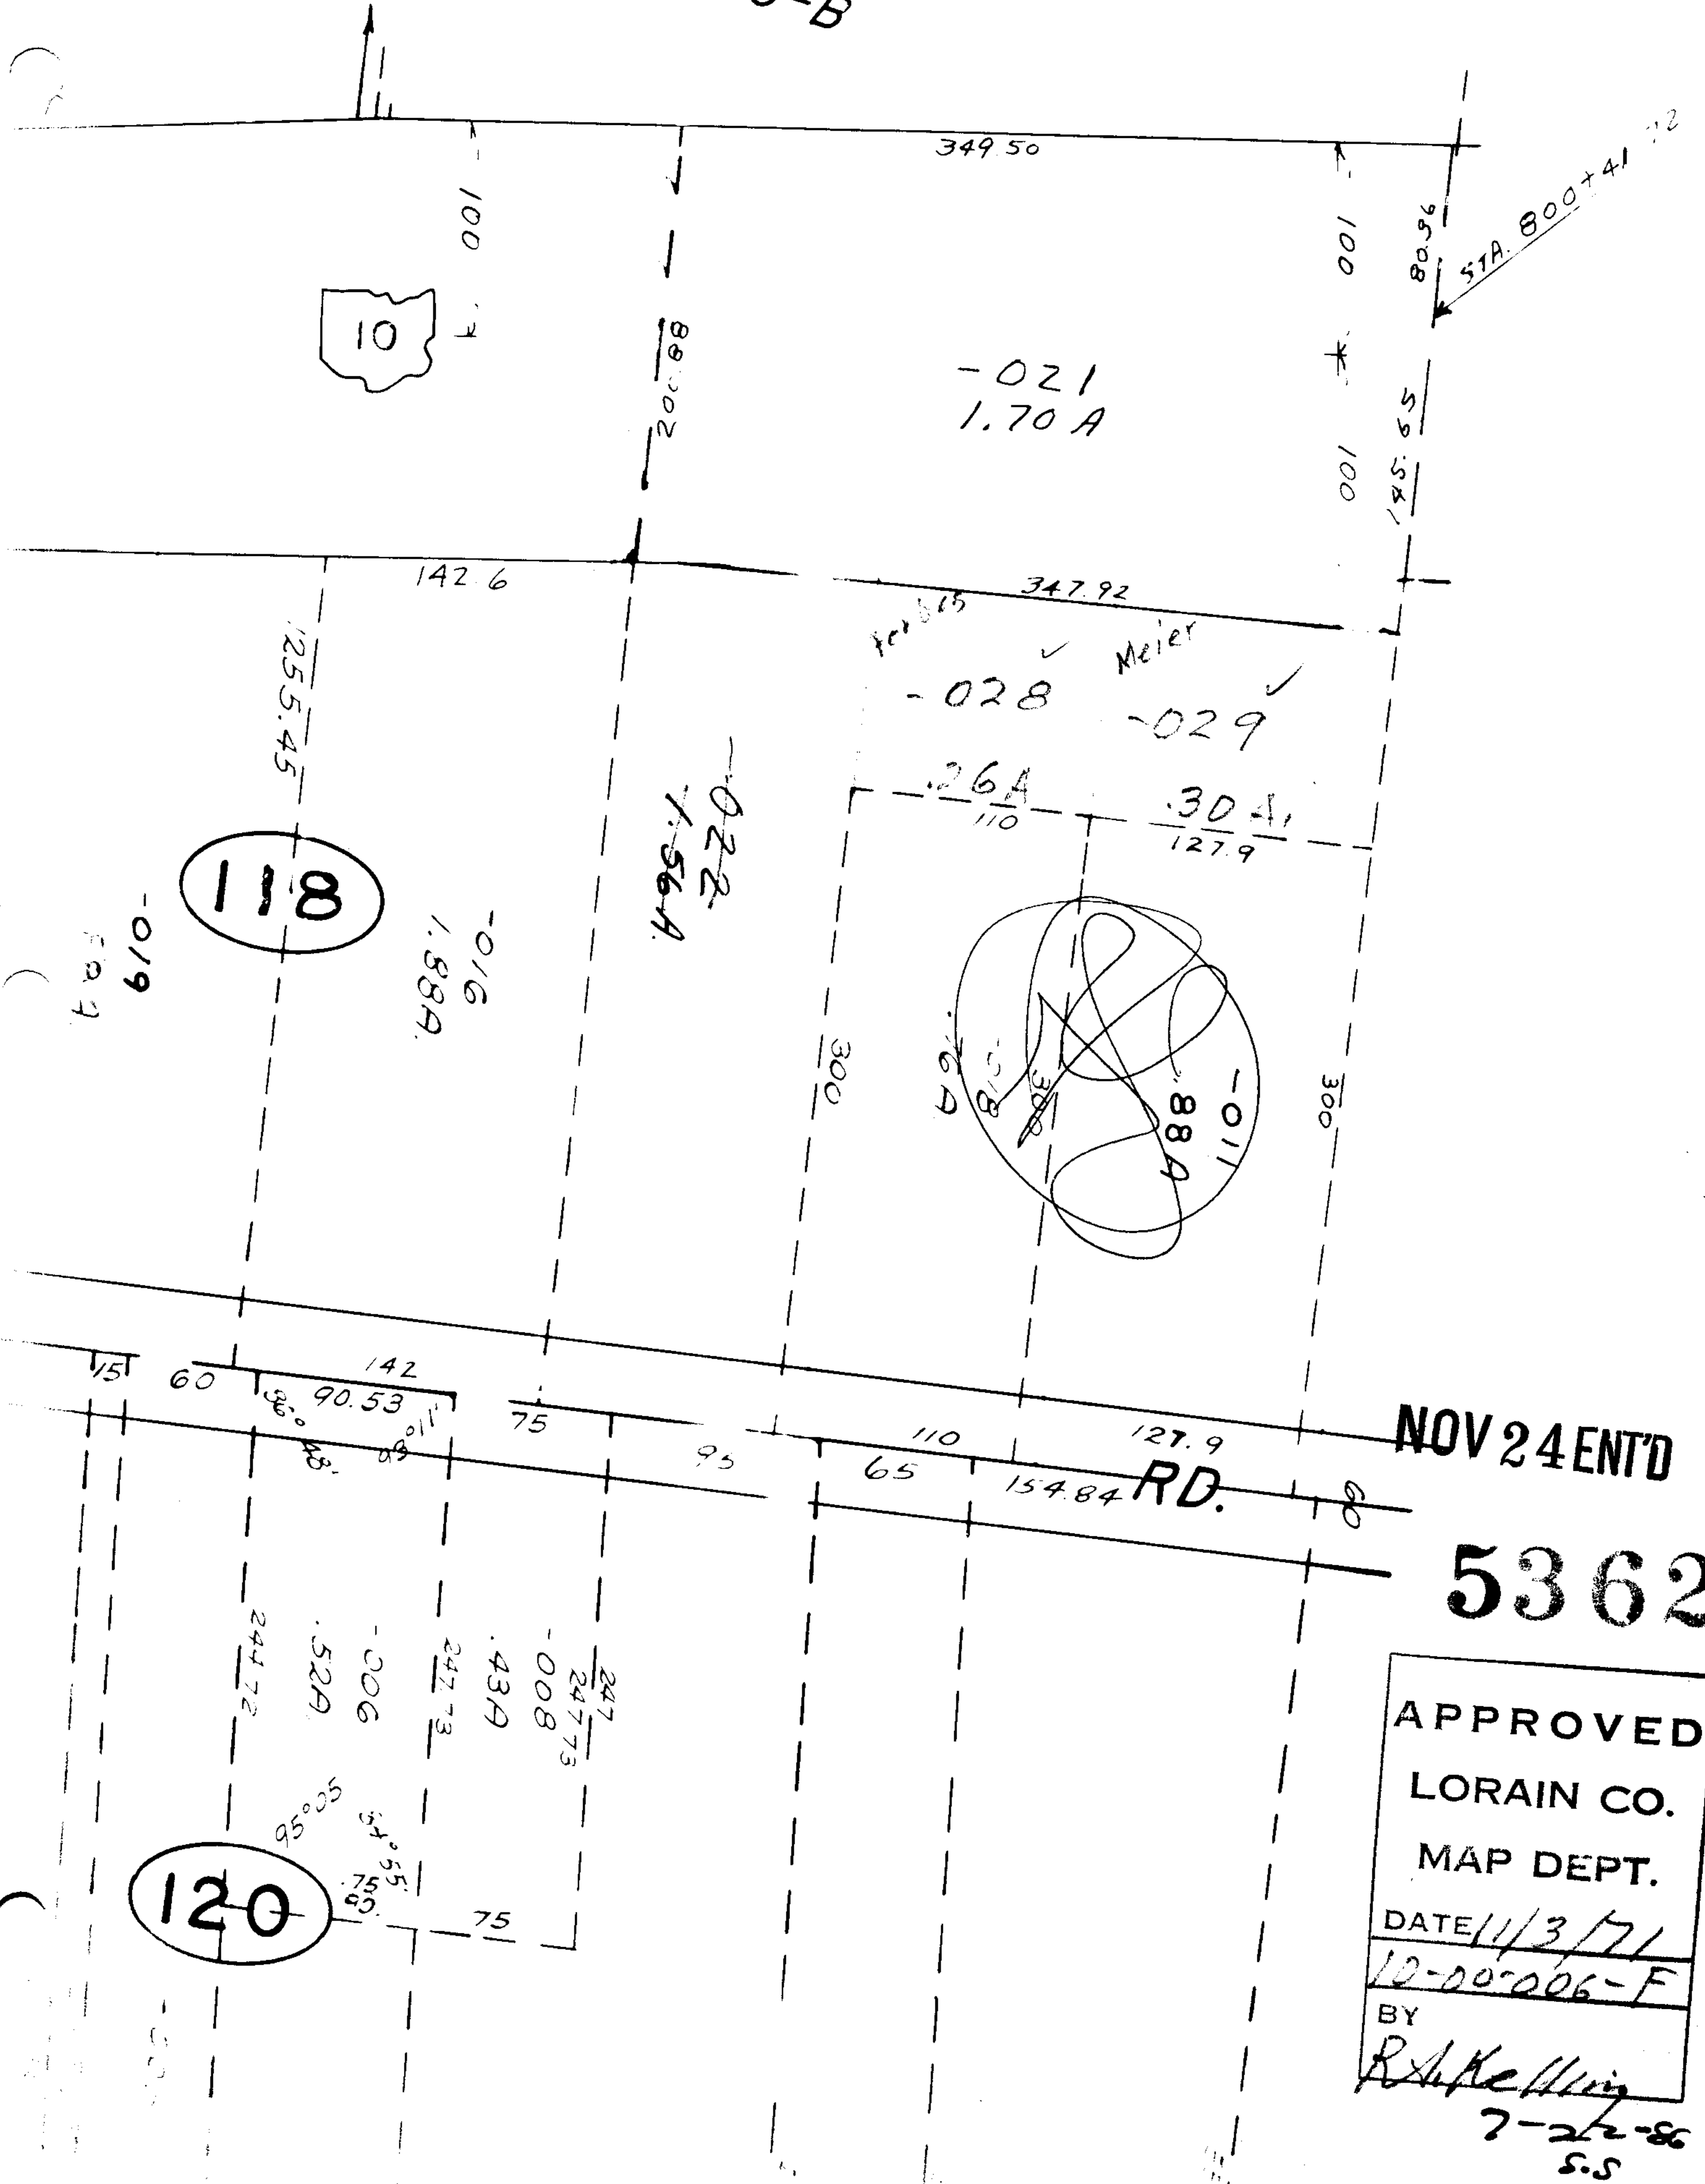

NOV 24 ENT'D

5362

APPROVED
 LORAIN CO.
 MAP DEPT.
 DATE 11/3/71
 10-00-006-F
 BY
 R. A. Kelling

7-22-86
S.S.