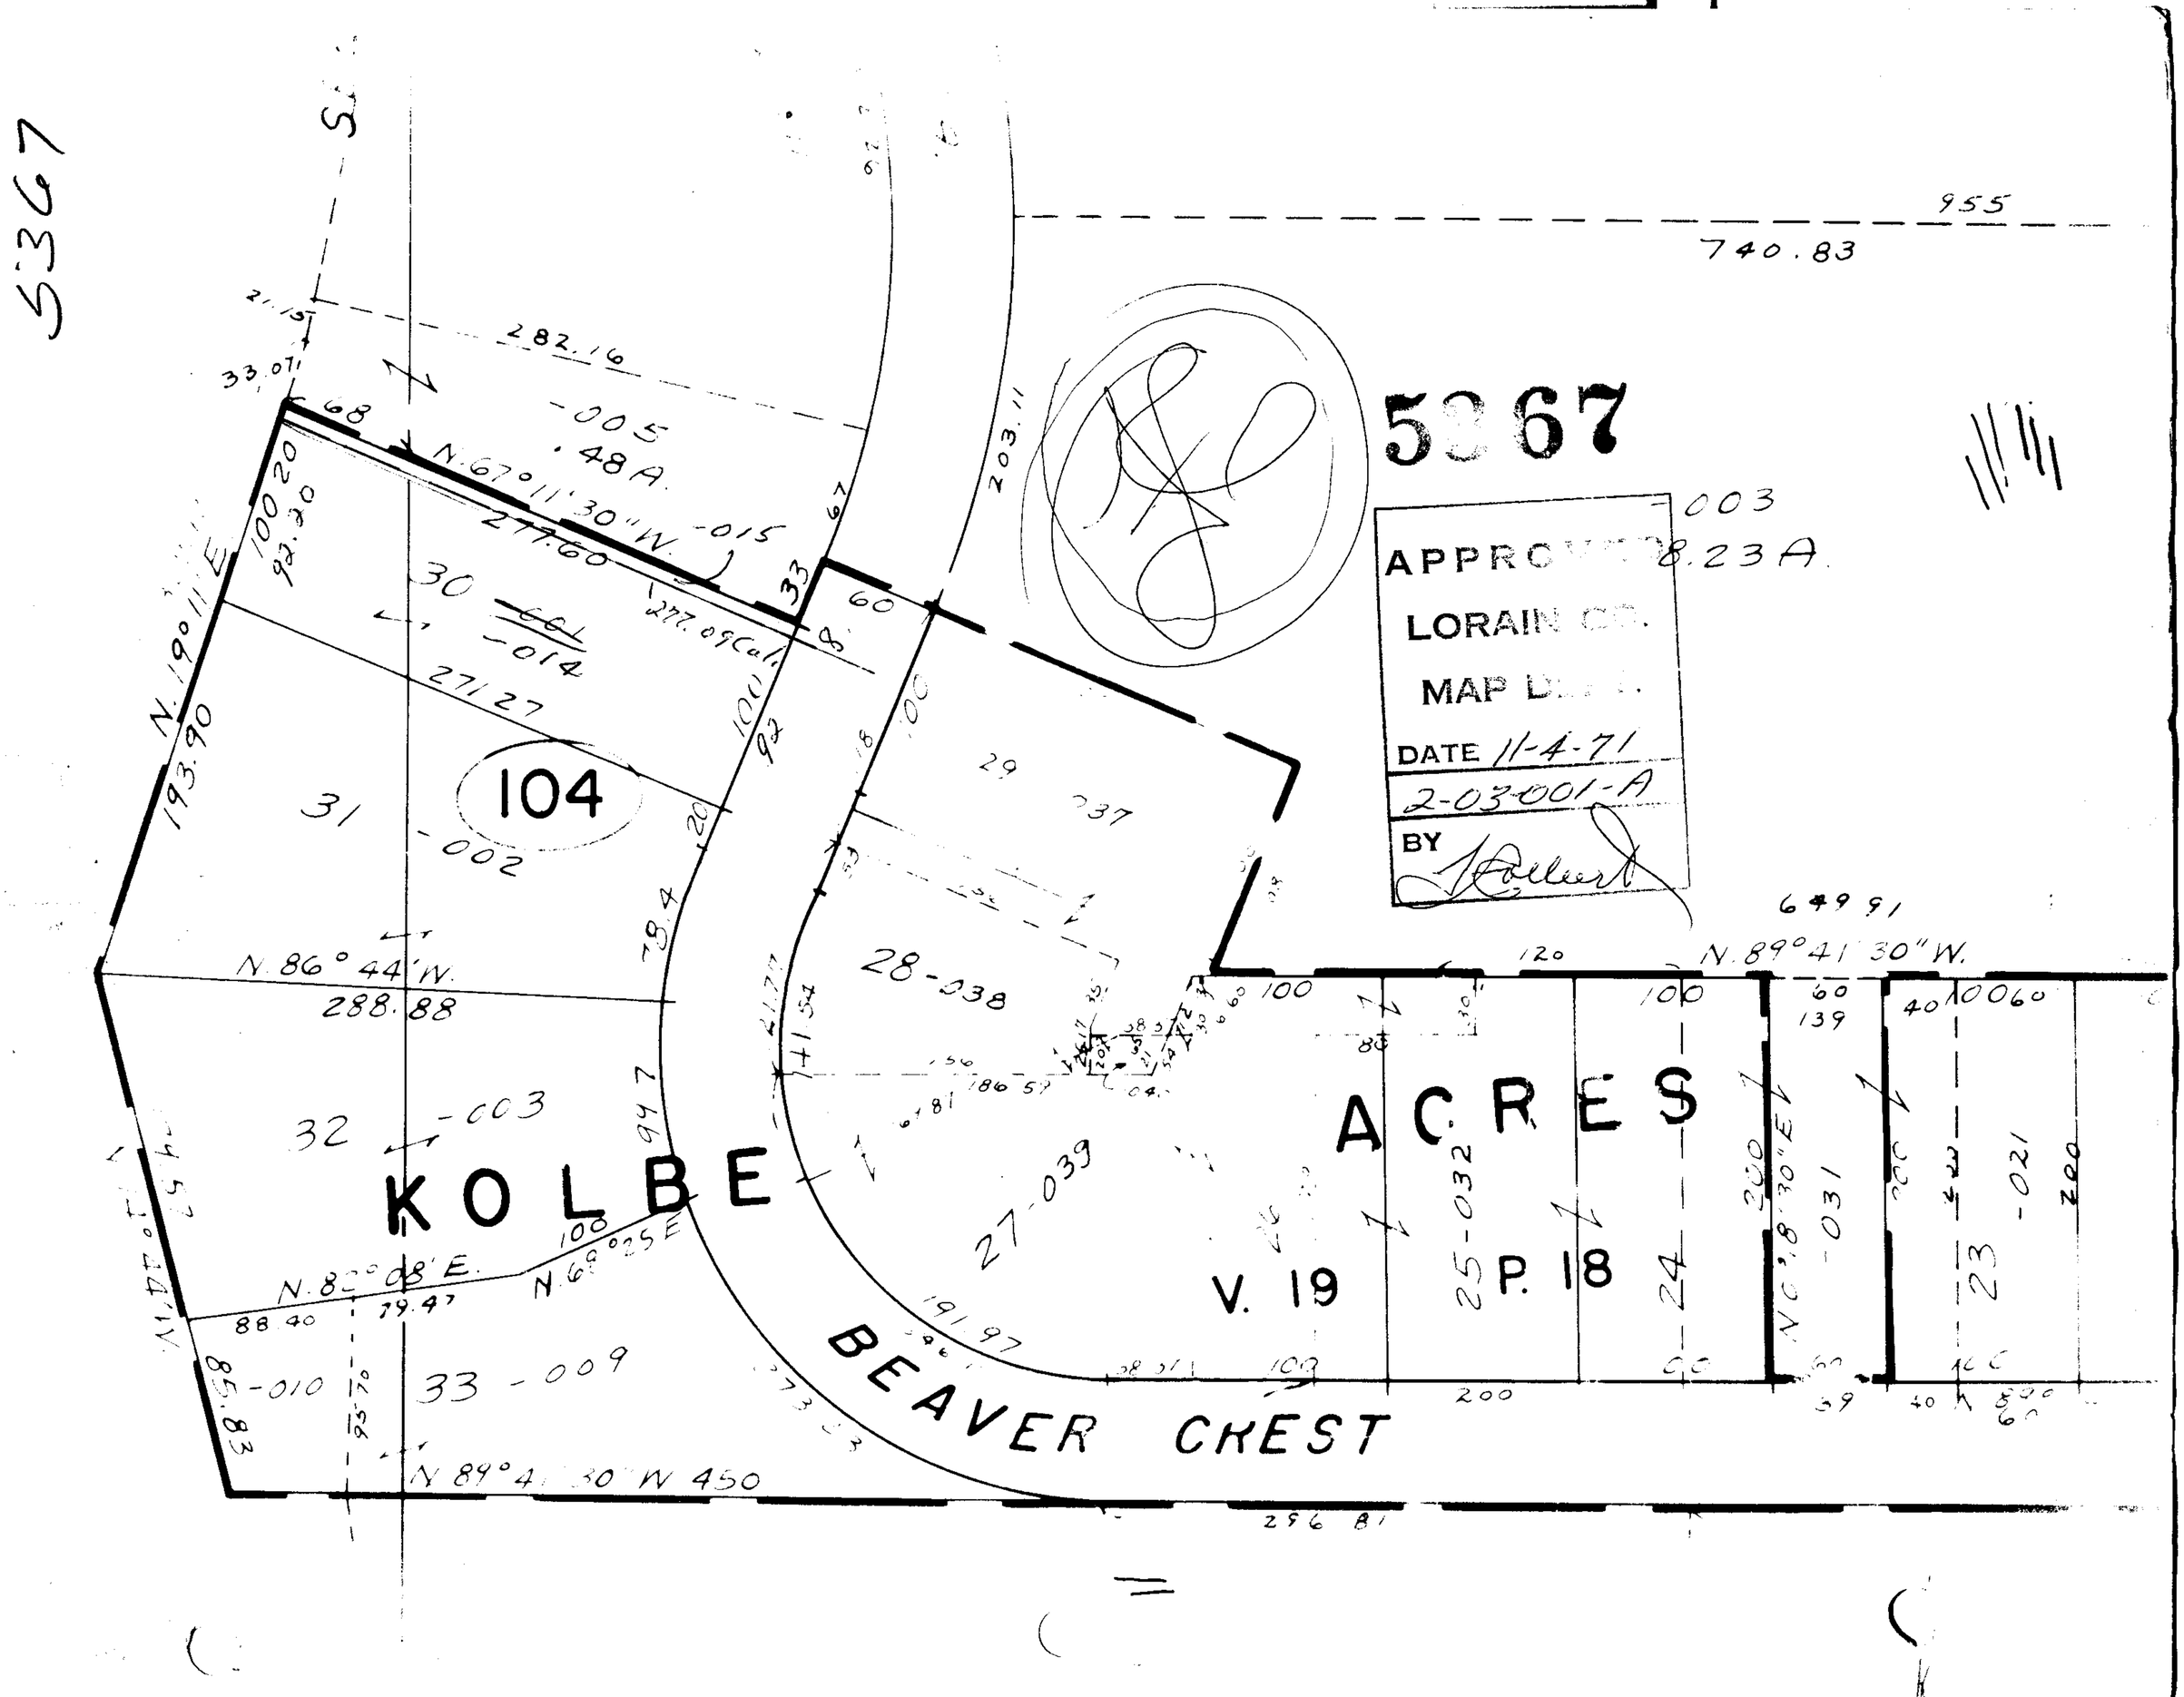
5367
5367
APPROVED
LORAIN CO.
MAP DEPT.
DATE 11-4-71
2-03-001-A
BY
KOLBE
ACRES
BEAVER CREST
V. 19
P. 18
104
N. 67°11'30" W.
N. 86°44' W.
N. 89°41'30" W.
N. 82°08' E.
N. 69°25' E.
N. 19°11' E.
N. 89°41'30" W 450
955
740.83
282.16
277.60
277.09 Cal.
271.27
288.88
193.90
649.91
296.81
28-038
27-039
25-032
24
23
32
33
31
30
29
-005
-015
-014
-002
-003
-010
-009
-031
-021
-003
8.23 A.