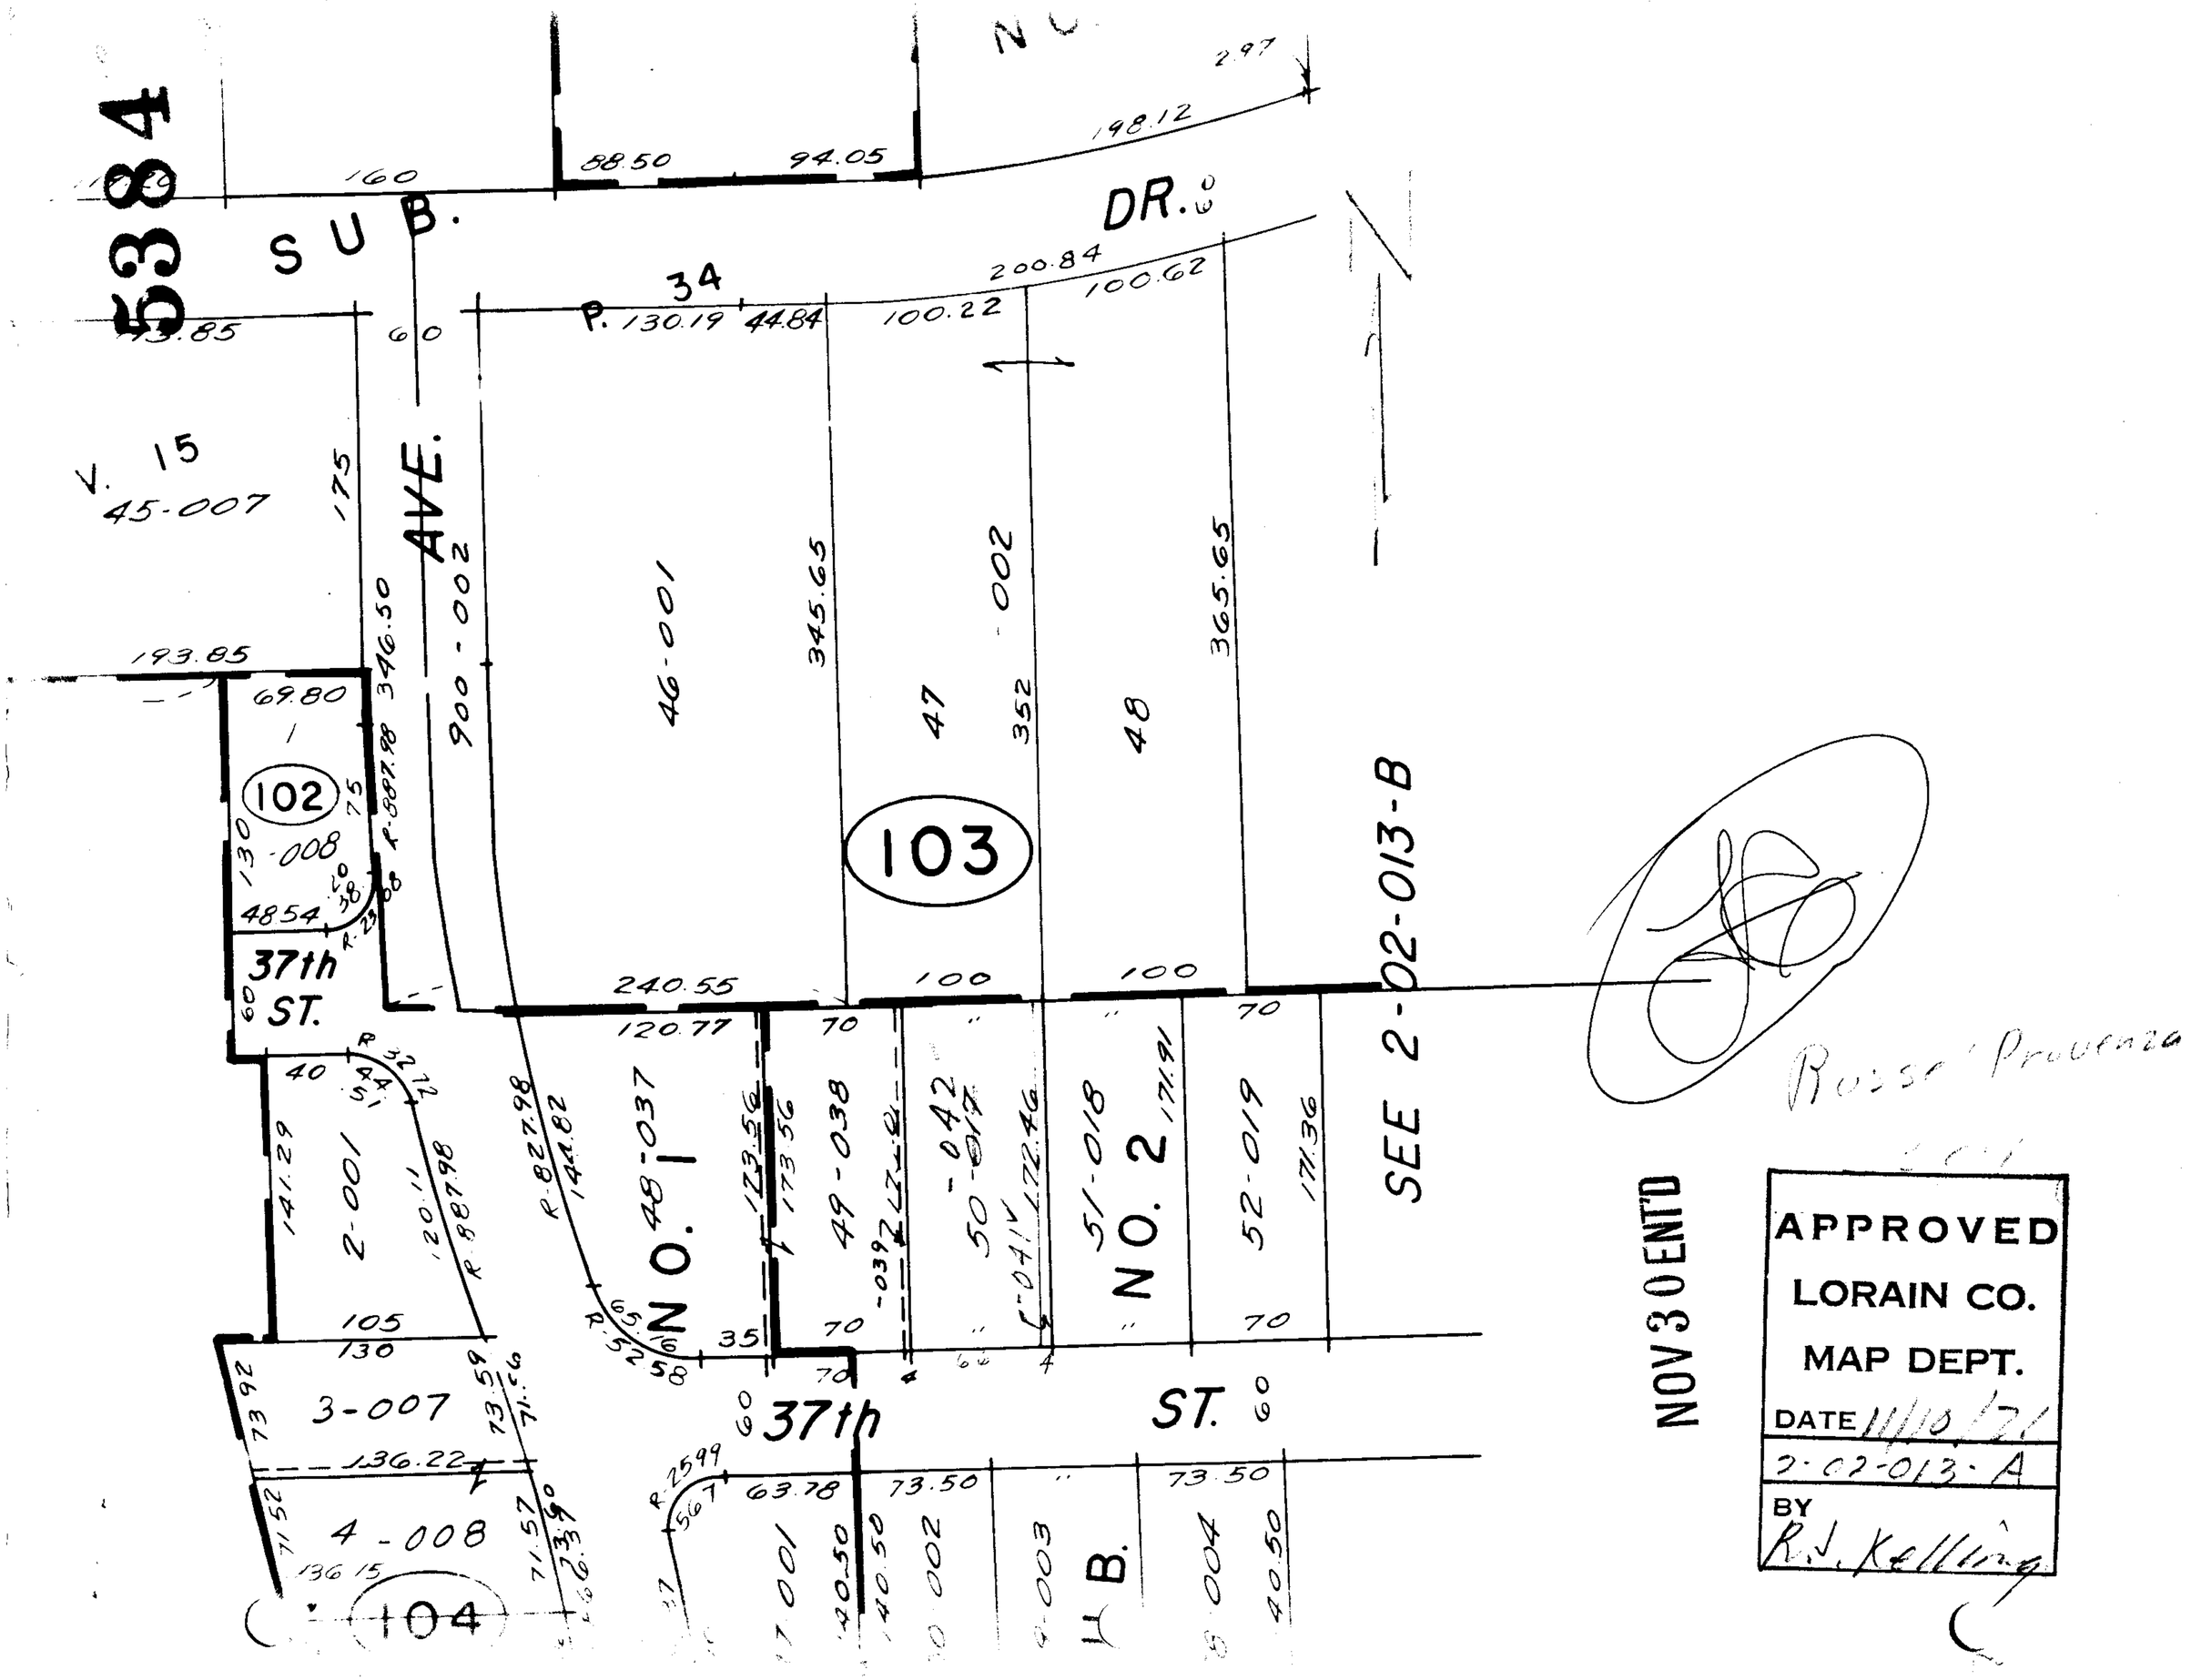
5384
SUB.
DR.
AVE.
37th ST.
37th ST.
NO. 1
NO. 2
SEE 2-02-013-B
102
103
104
V. 15
45-007
46-001
47
48-037
49-038
50-042
51-018
52-019
2-001
3-007
4-008
Russel Provenza
NOV 30 ENT'D
APPROVED
LORAIN CO.
MAP DEPT.
DATE 11/10/71
2-02-013-A
BY
R.J. Kelling