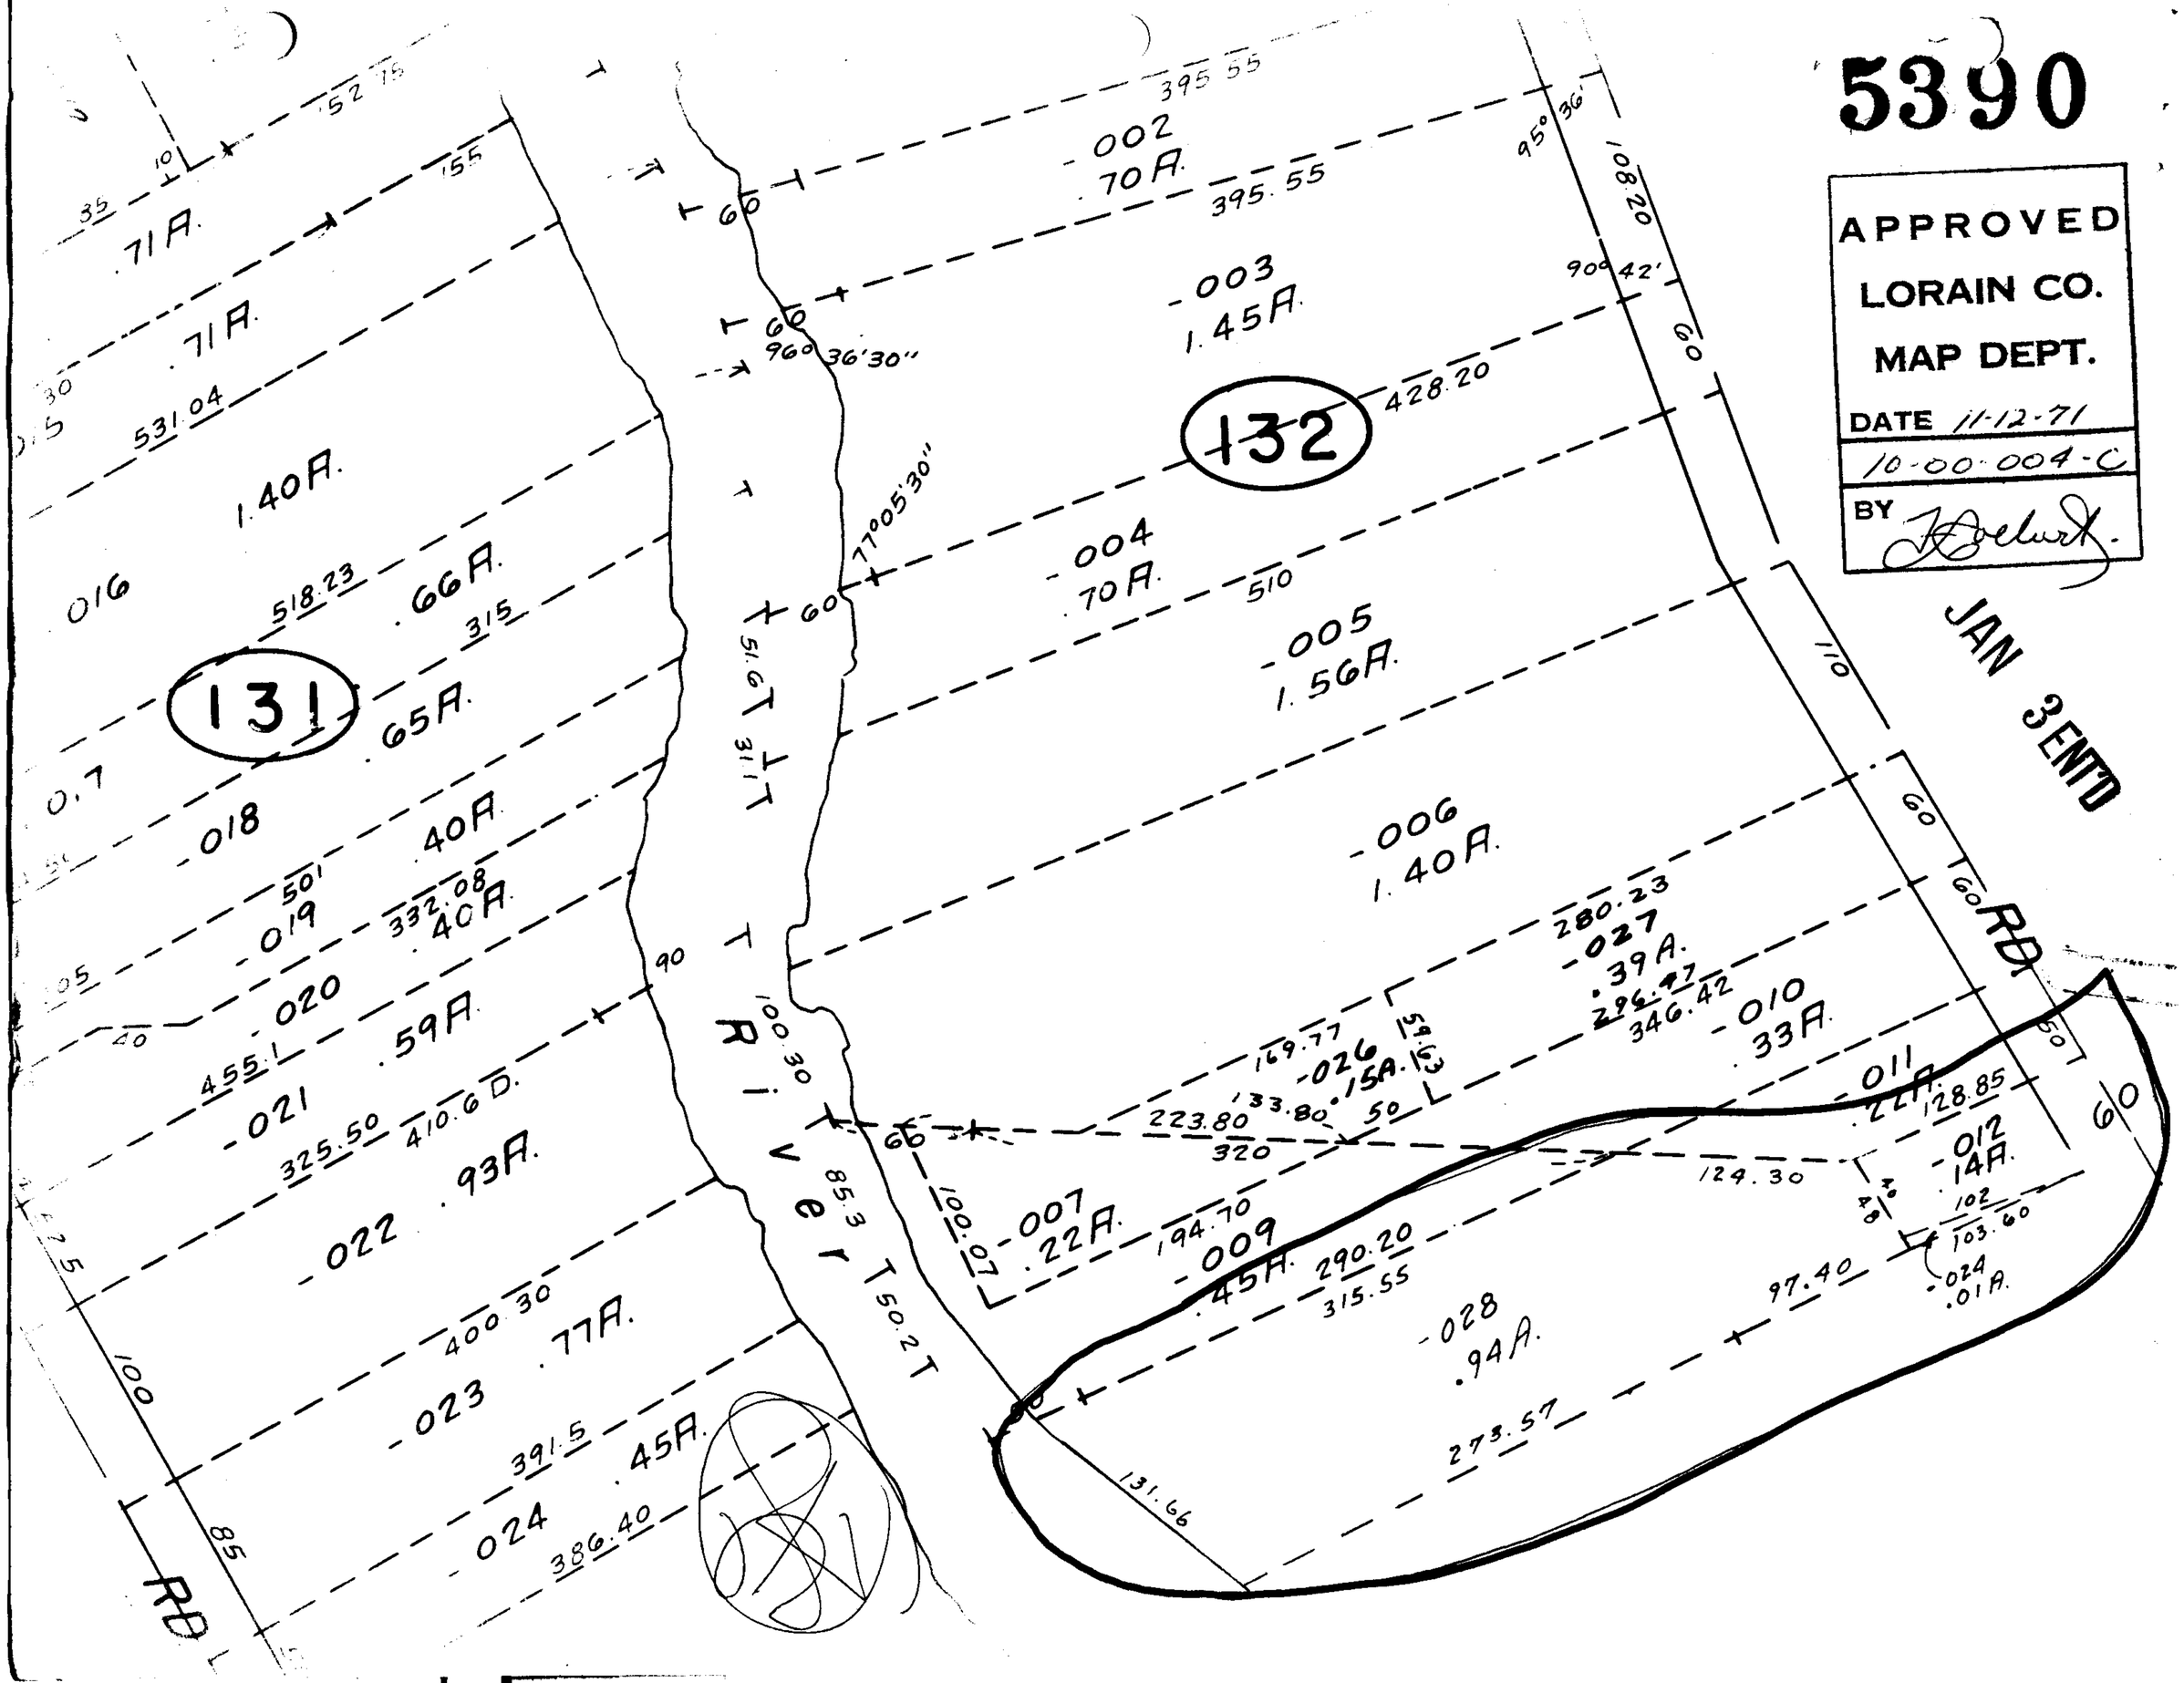
5390
APPROVED
LORAIN CO.
MAP DEPT.
DATE 11-12-71
10-00-004-C
BY
JAN 3 ENT'D
131
132
River
RD
RD
-002
.70A.
-003
1.45A.
-004
.70A.
-005
1.56A.
-006
1.40A.
-007
.22A.
-009
.45A.
-010
.33A.
-011
.22A.
-012
.14A.
-018
.66A.
-019
.65A.
-020
.40A.
-021
.59A.
-022
.93A.
-023
.77A.
-024
.45A.
-026
.15A.
-027
.39A.
-028
.94A.
-024
.01A.
.71A.
.71A.
1.40A.
.016
.018
.40A.
.40A.
.59A.
.93A.
.77A.
.45A.
395.55
395.55
428.20
510
280.23
296.47
346.42
169.77
133.80
223.80
320
194.70
290.20
315.55
273.57
131.66
97.40
124.30
128.85
102
103.60
108.20
95° 36'
90° 42'
96° 36'30"
77°05'30"
100.30
85.3
50.2
100.07
51.6
31.1
518.23
315
332.08
455.1
325.50
410.6 D.
400.30
391.5
386.40
531.04
152.75
155
60
110
100
85
90
50