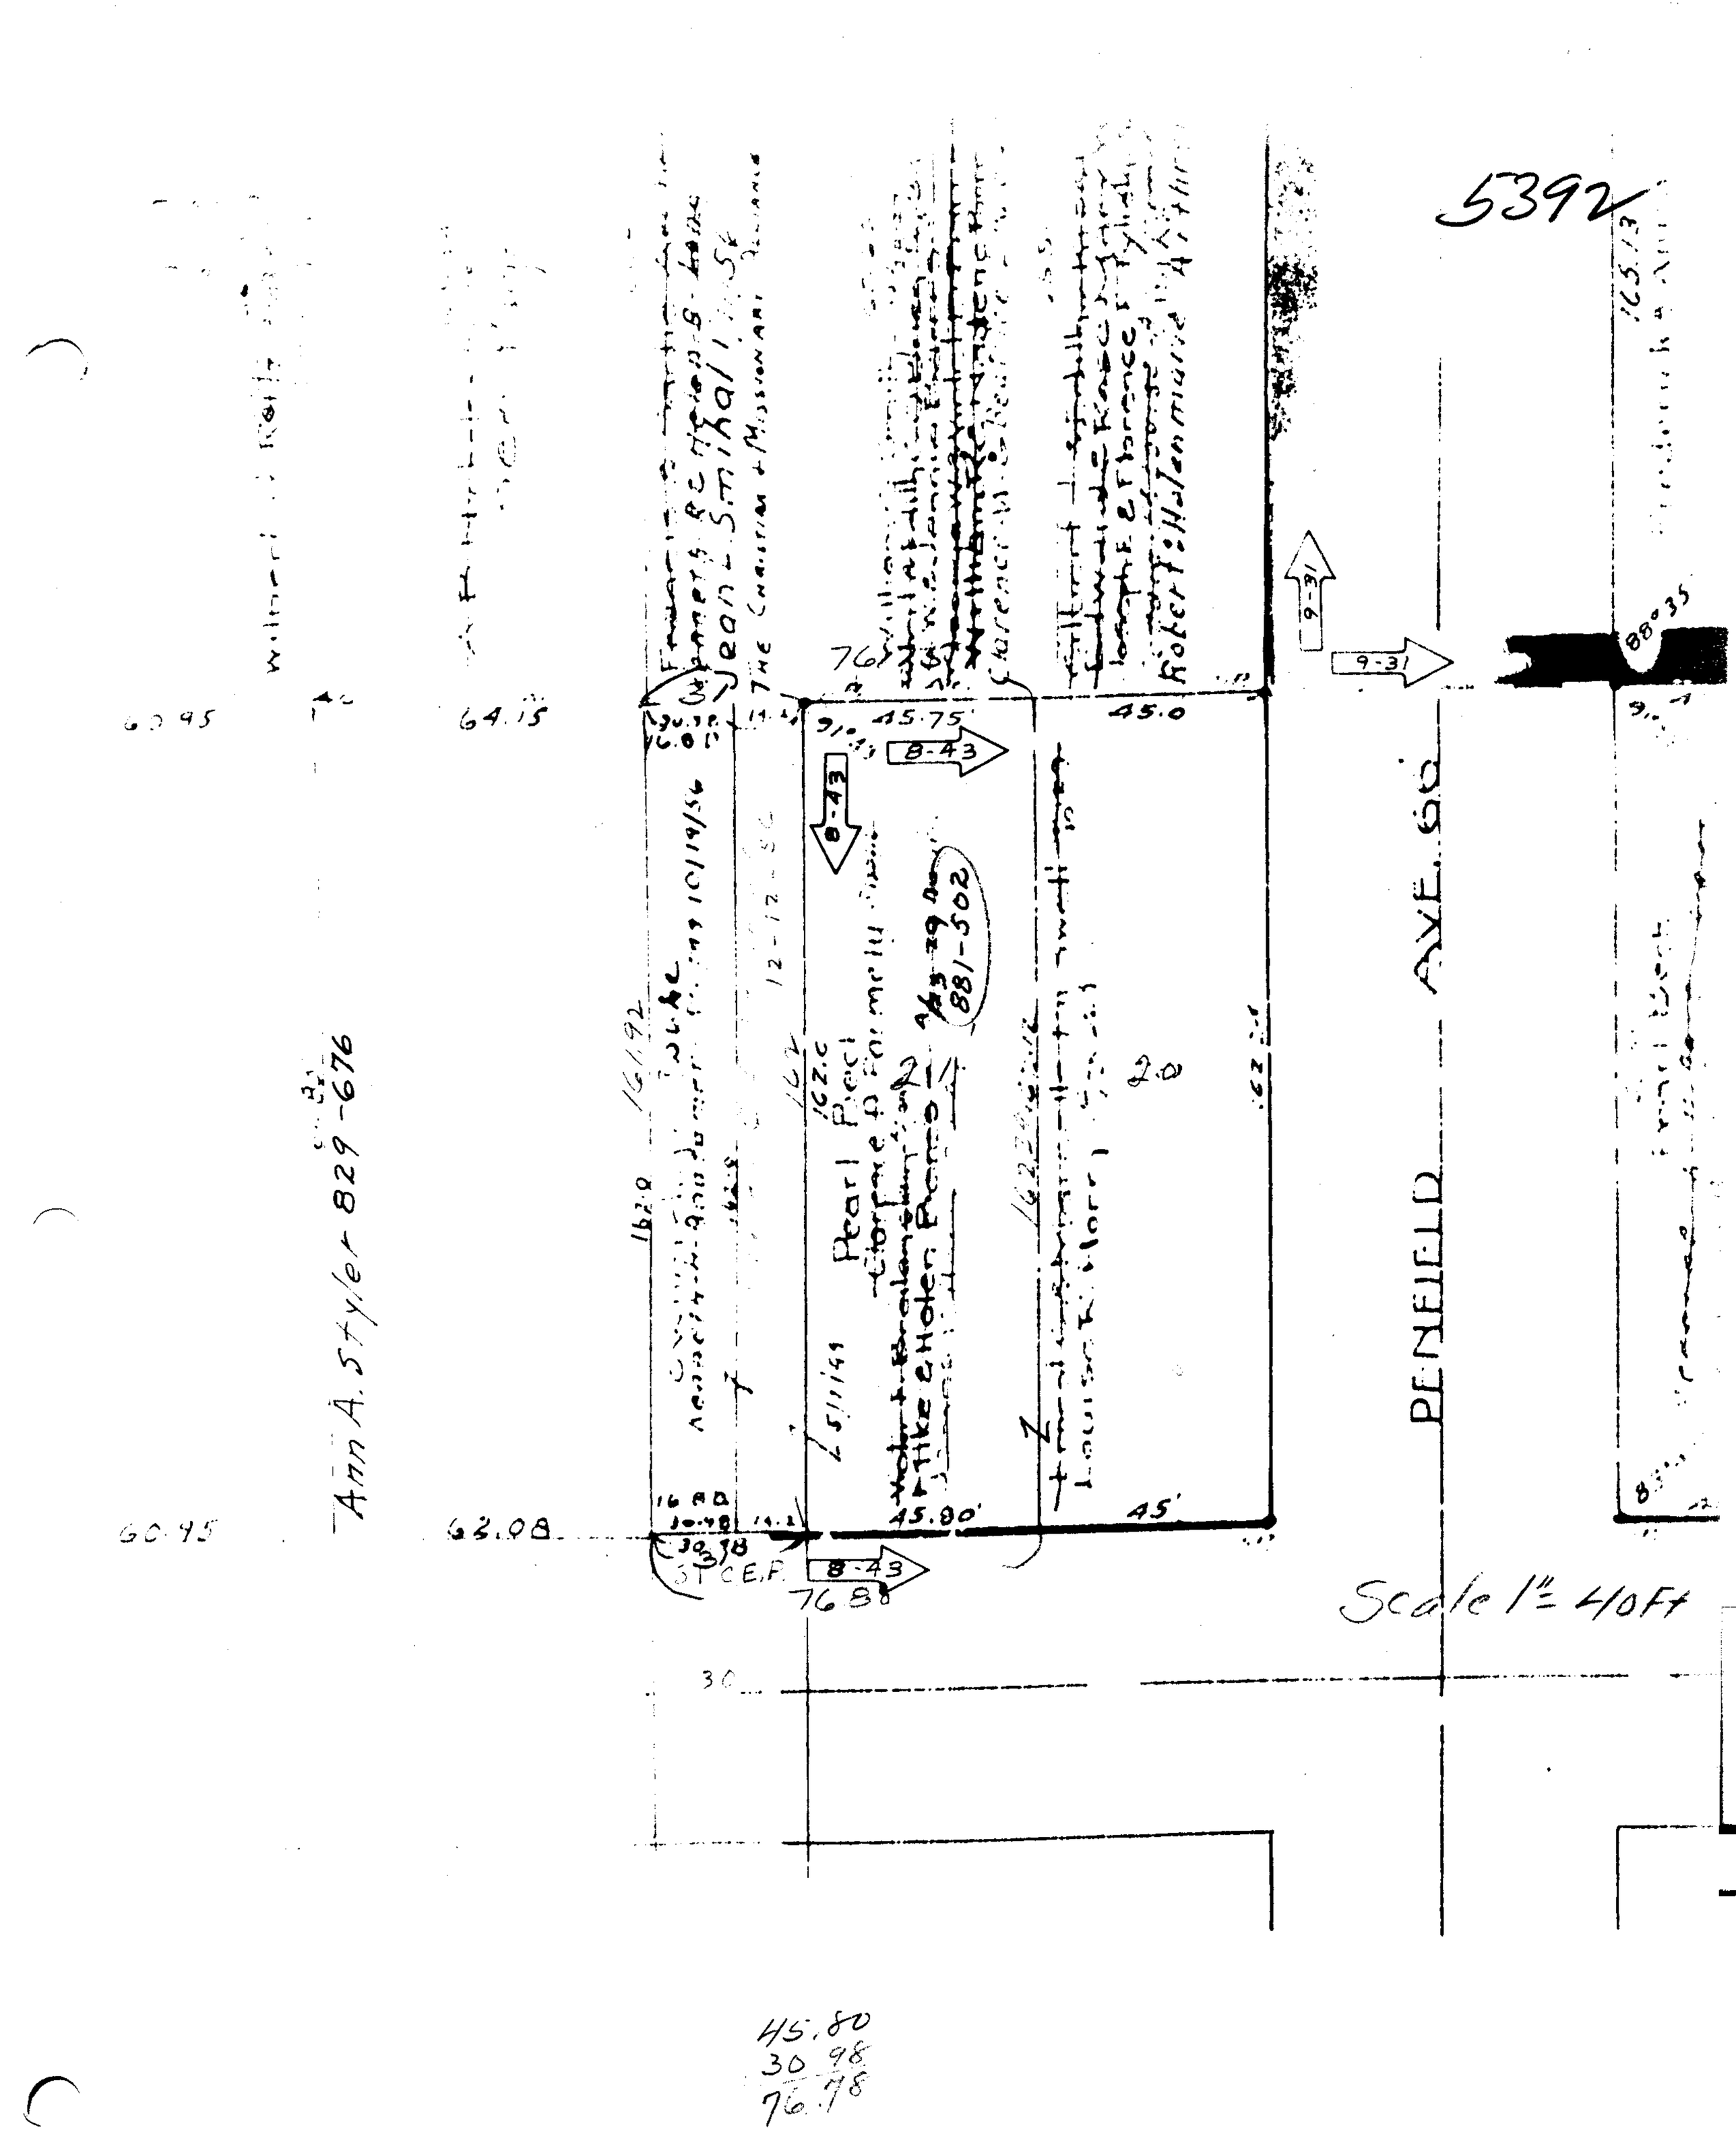
5392
Ann A. Styler 829-676
PENFIELD AVE. 66
Scale 1" = 40 Ft
Pearl Beach
Robert & Helen Marie Arthur
Jean & Smithal
The Christian & Missionary Alliance
Clarence
Louise K. Horn
Mike & Helen Pomes
881-502
45.75
45.0
45.80
45'
64.15
62.08
60.95
8-43
9-31
76.88
30
45.80
30.98
76.78