




DEC 29 ENT'D

APPROVED
LORAIN CO.
MAP DEPT.
 DATE 11/15/71
 3-00-111-B
 BY S. J. [Signature]

50 GLOBE

ROLLING

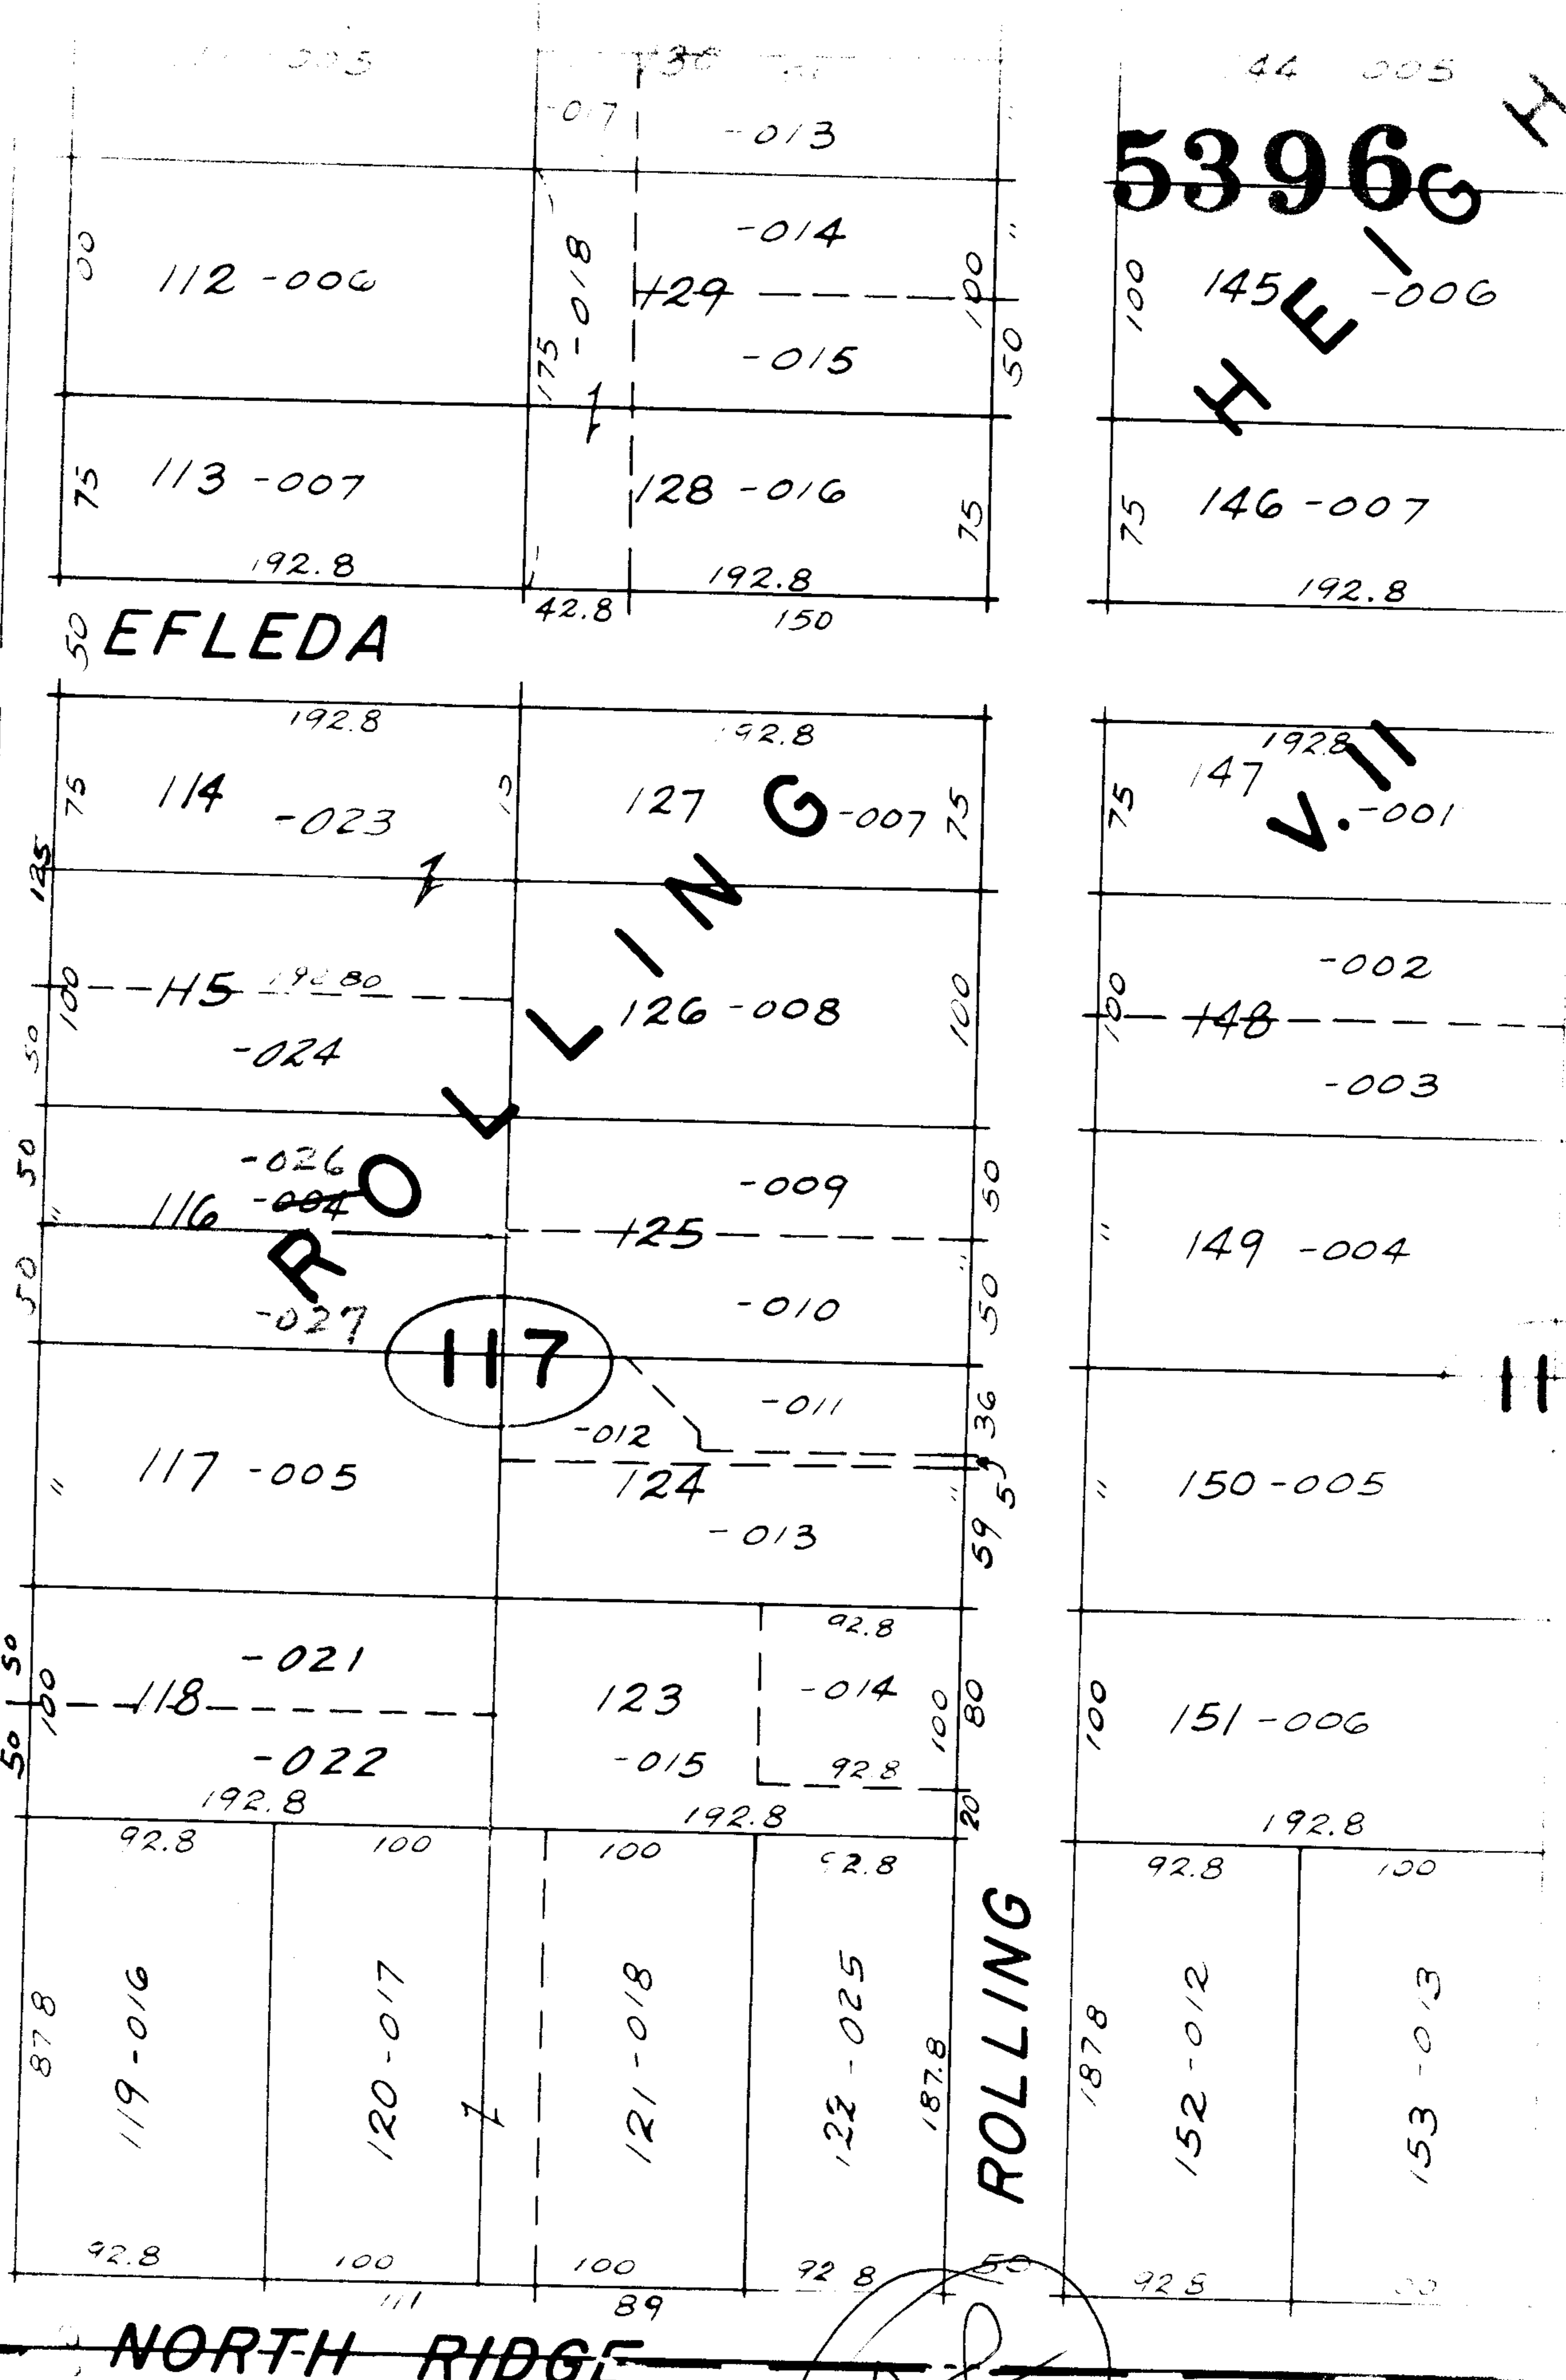

SEE 6-F