

17.56
 3503
 5259
 2
 5459 = 54.54 B-1 Curve

122.10
 54.54
 67.56

E r i e

Maryes
 003
 004
 98.87
 35
 87

35.12
 17.56
 54.68

5409

07

05
A

BEACH

AVE.

ALLEY

103

A

RD. 50

6/2

05
A

A

9ENTD

**APPROVED FOR
 LORAIN CO. MAP DEPT.**

DATE 11-18-71
BY *Keller*


5409

AVE.

AVE.

SEE 3-00-038-A

3-00-039

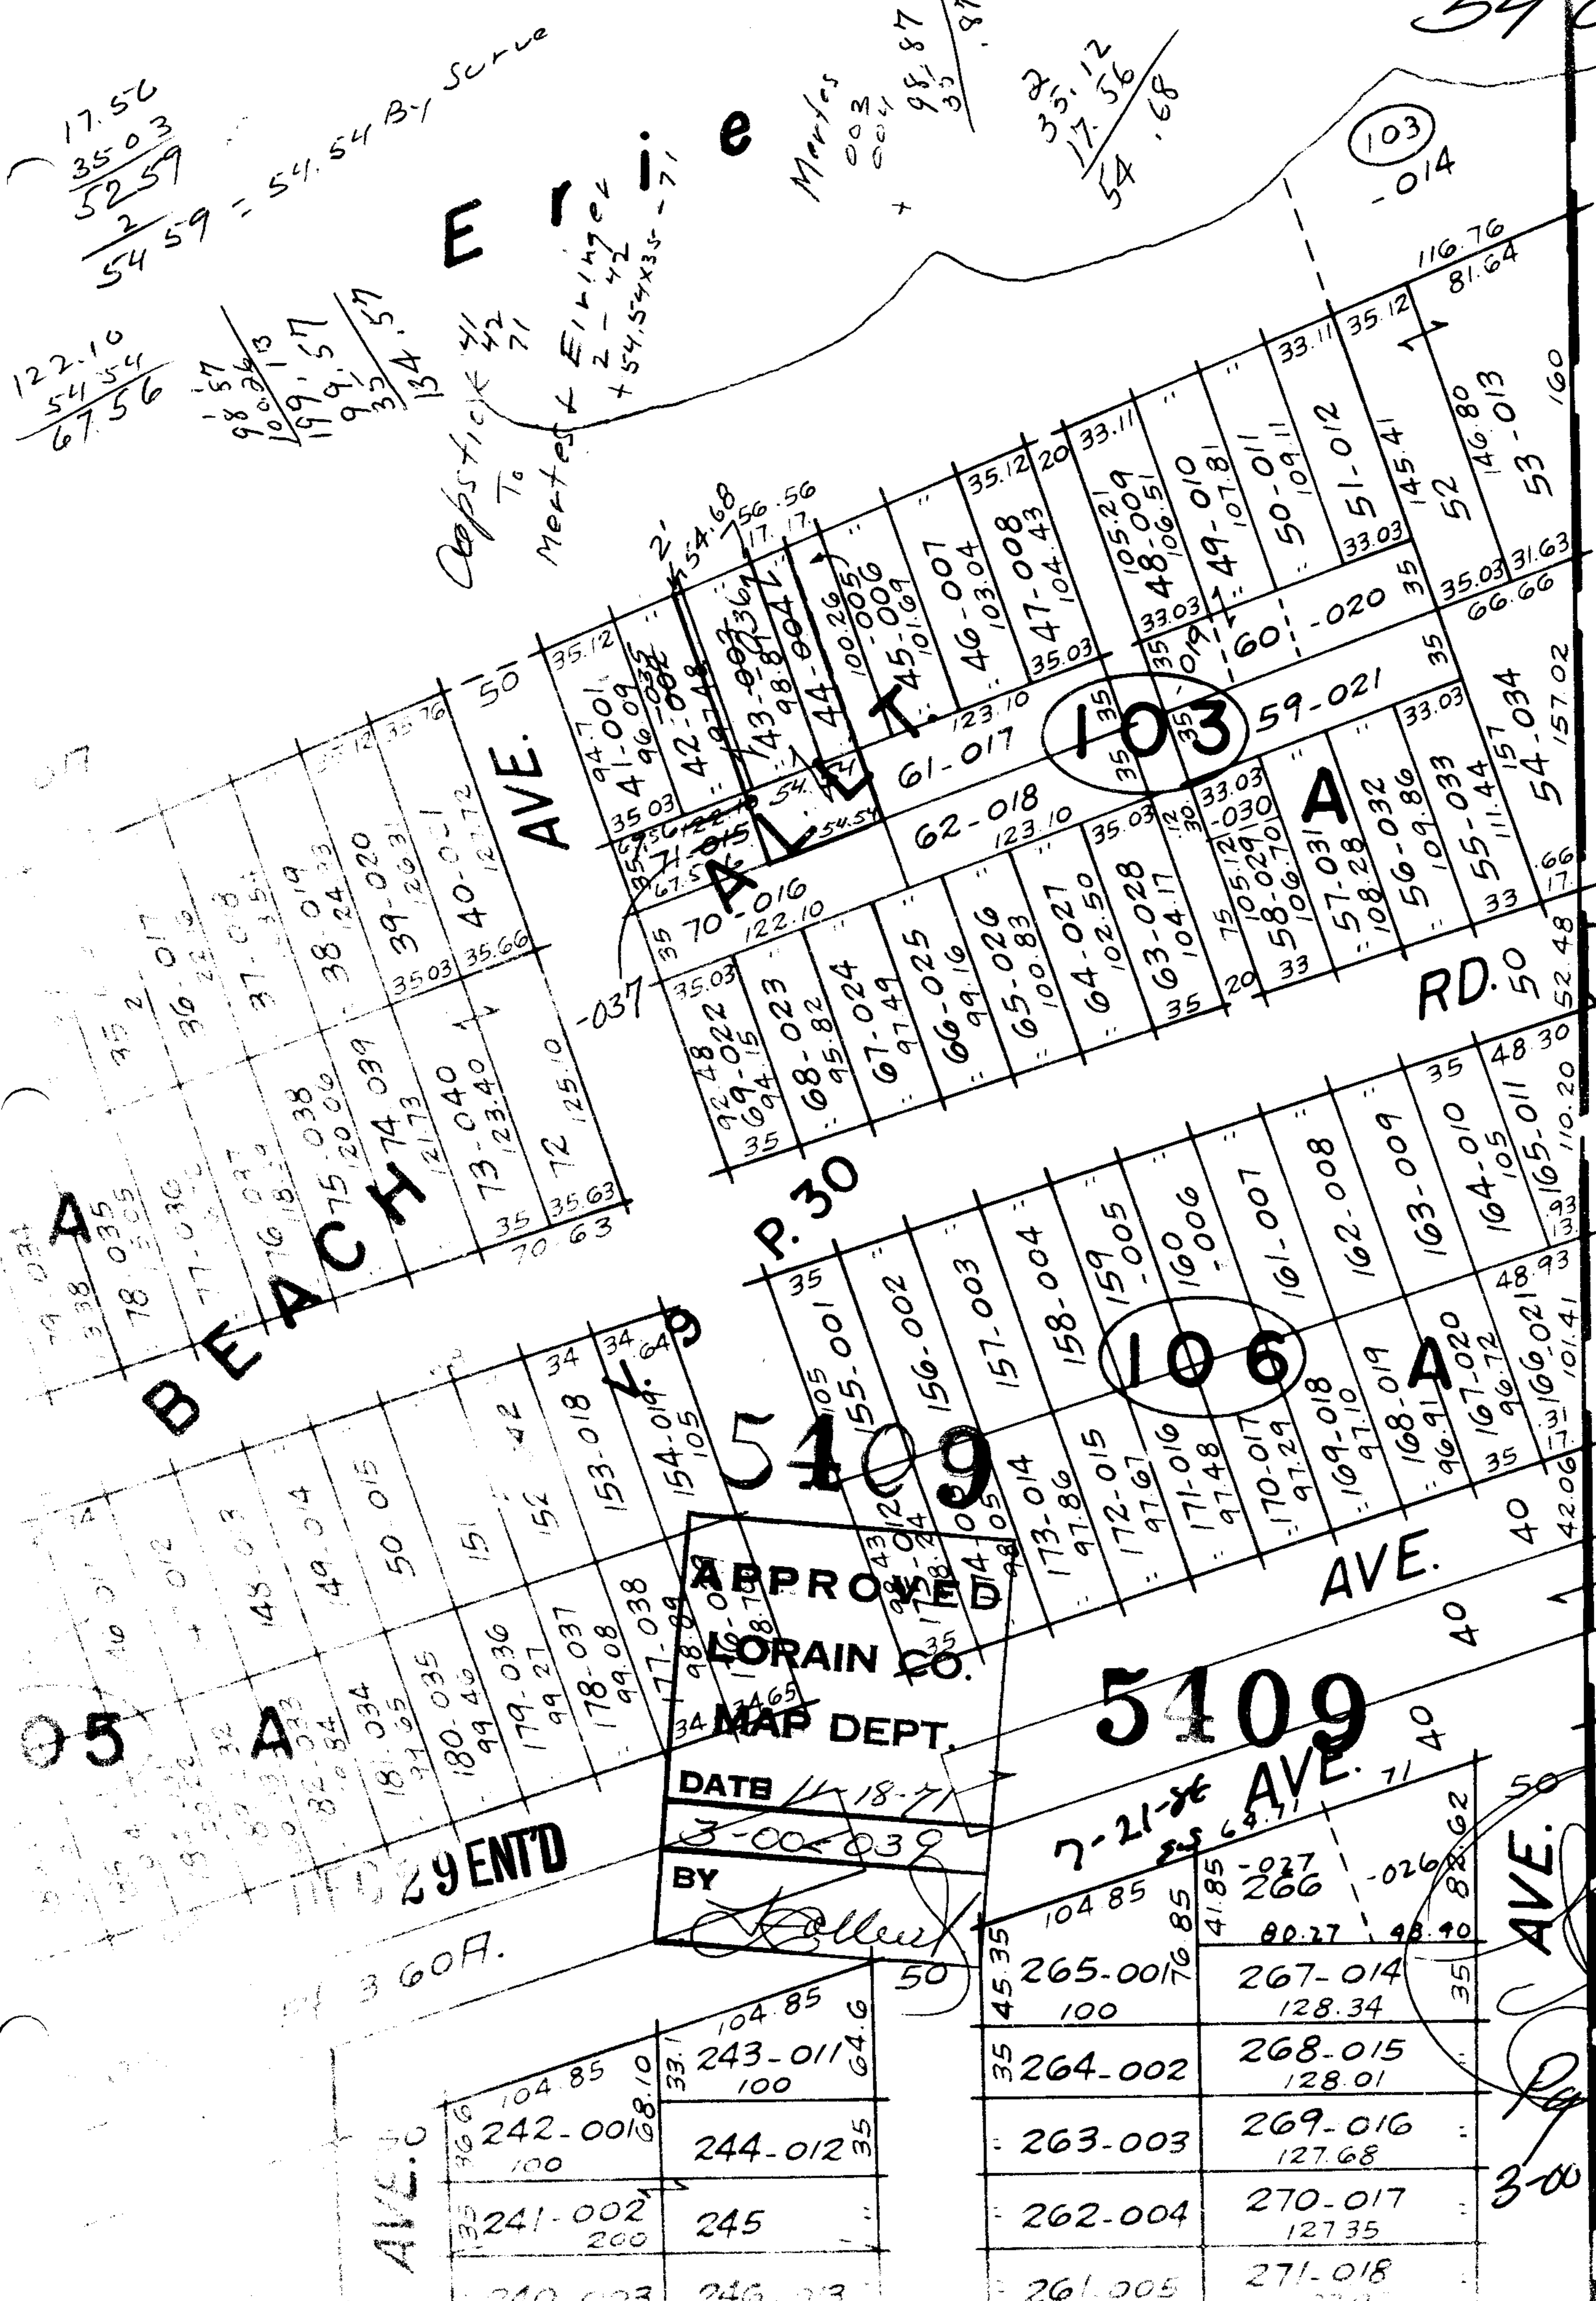

360A.

AVE.

AVE.

3-00-039