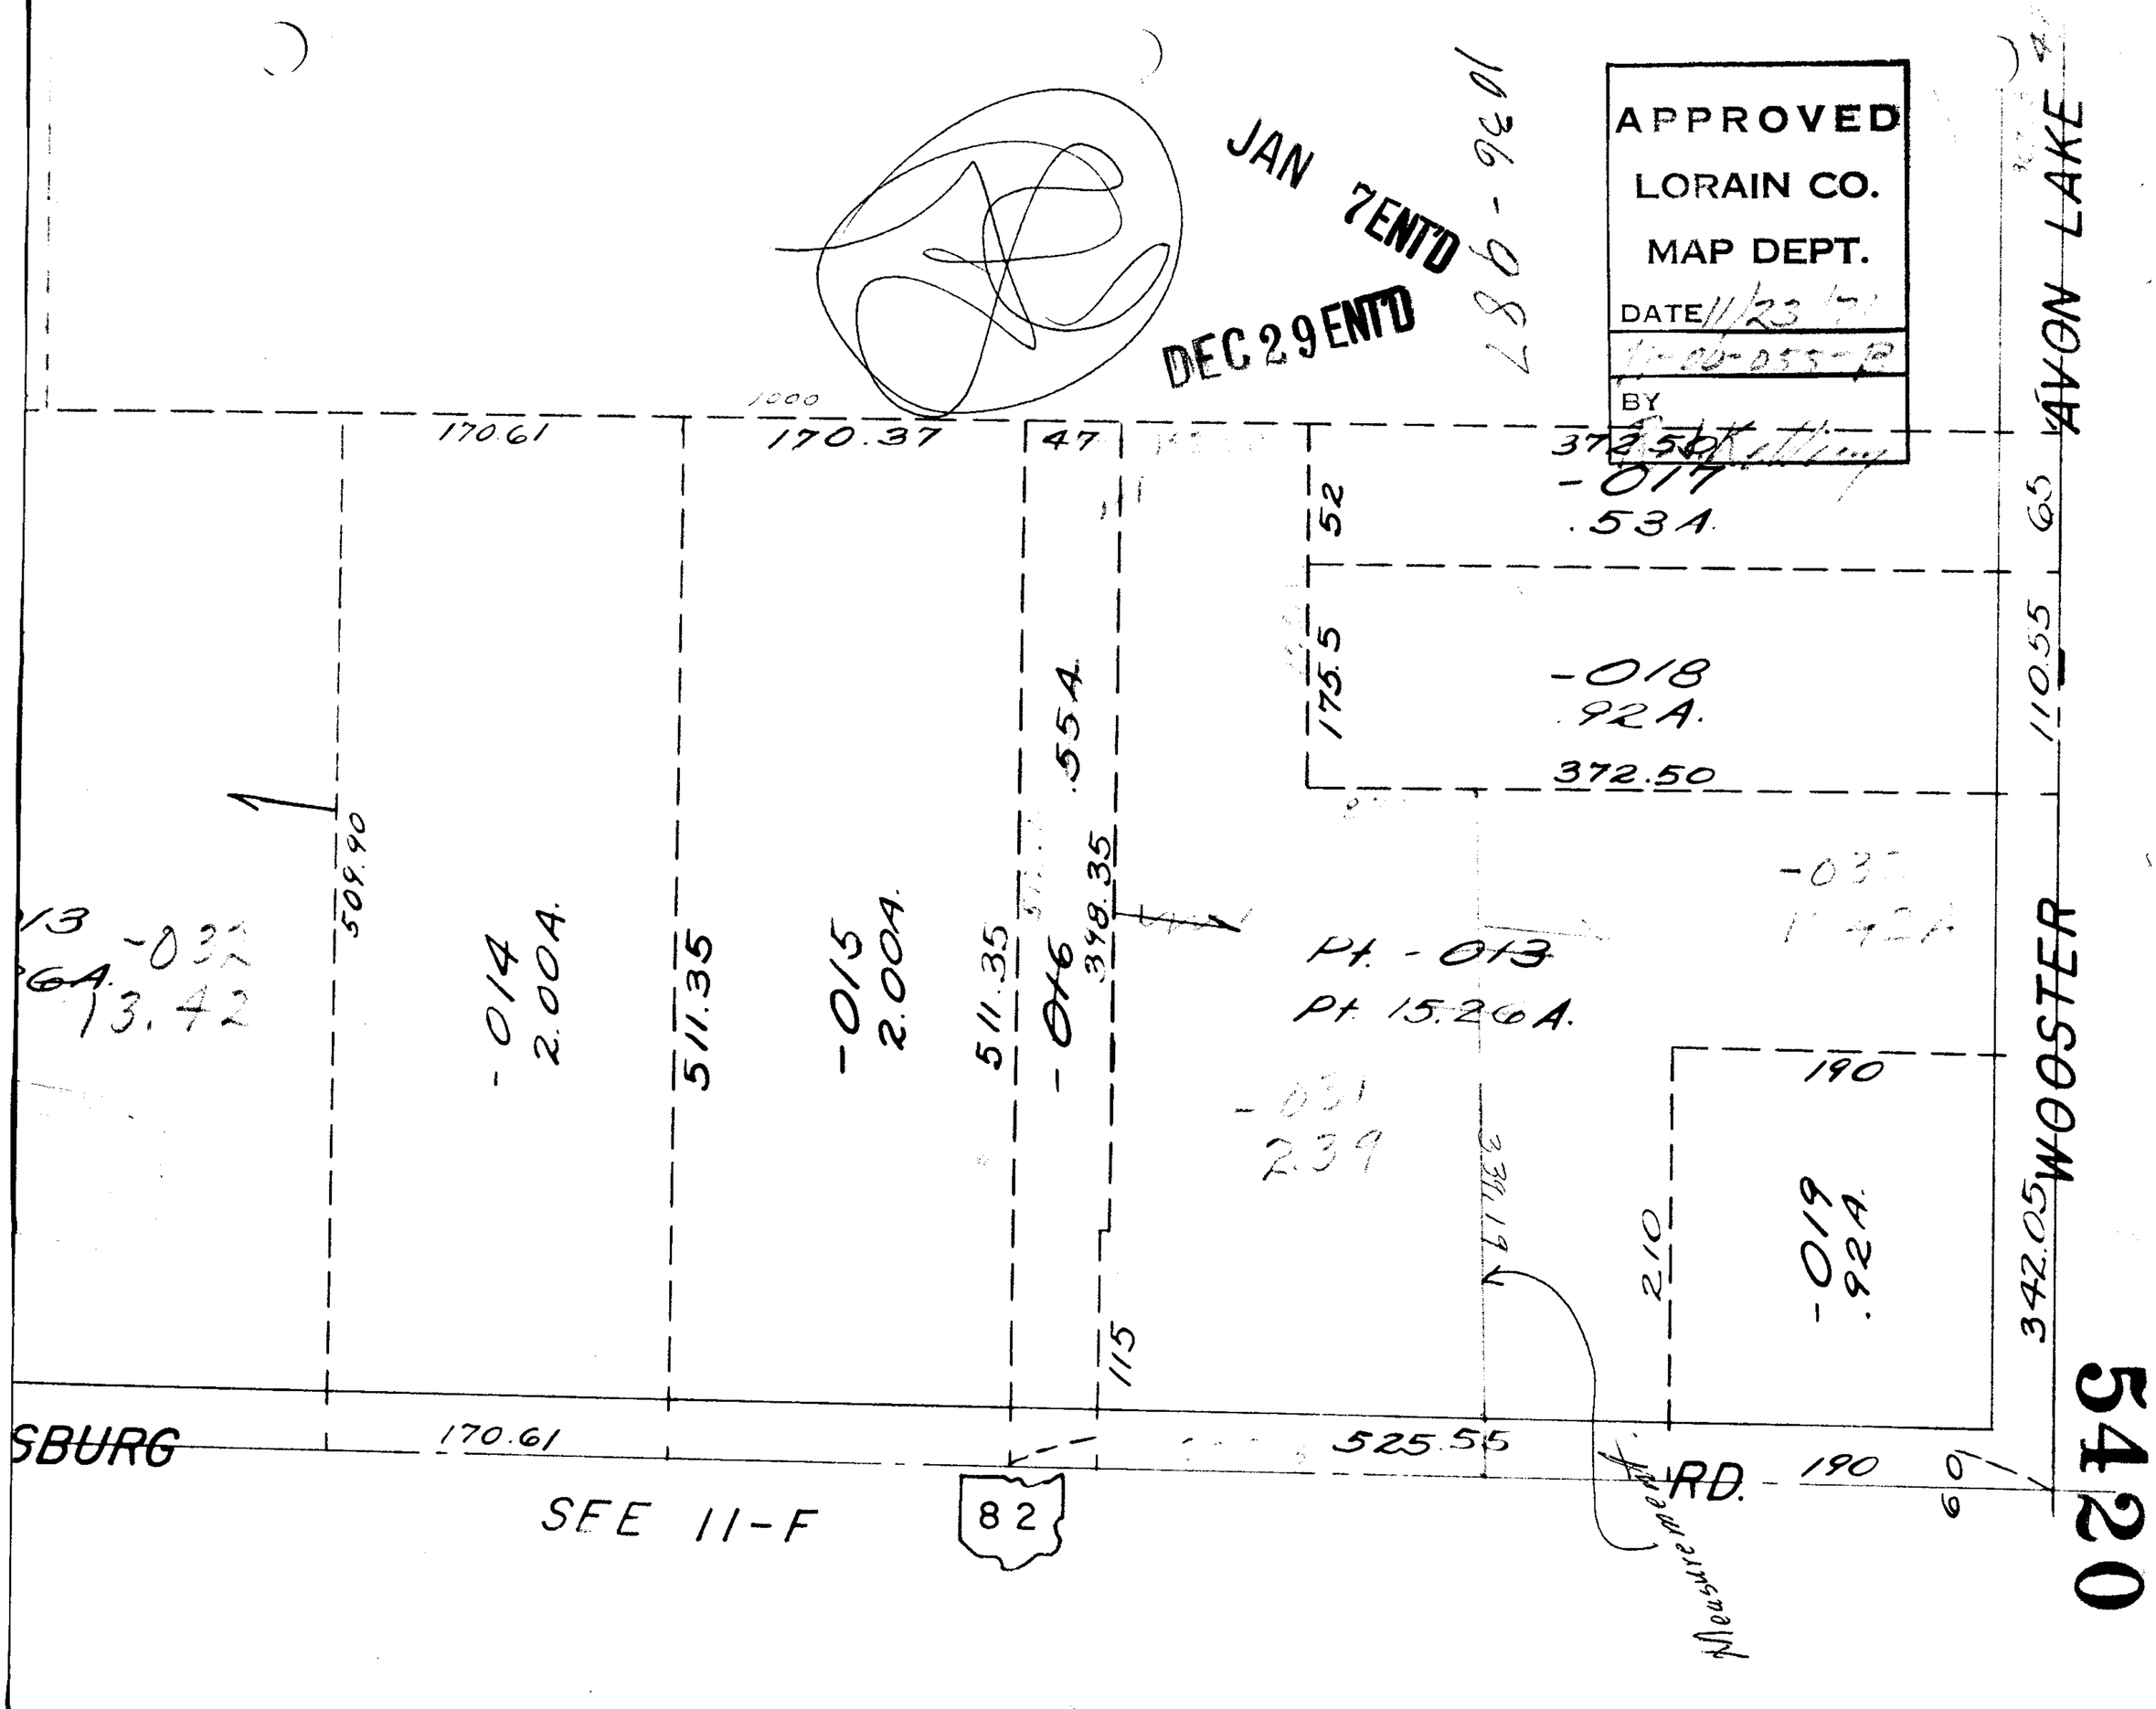

APPROVED
LORAIN CO.
MAP DEPT.
DATE 11/23/71
BY
JAN 7 ENT'D
DEC 29 ENT'D
1036-987
AVON LAKE
WOOSTER
SBURG
RD.
SEE 11-F
82
170.61
170.37
47
372.50
-017
.53A.
52
175.5
-018
.92A.
372.50
65
110.55
509.90
-014
2.00A.
511.35
-015
2.00A.
511.35
-016
.55A.
398.35
Pt. -013
Pt. 15.26A.
-031
2.39
339.19
210
190
-019
.92A.
342.05
115
525.55
190
Measurement

5420