


14-F

5424

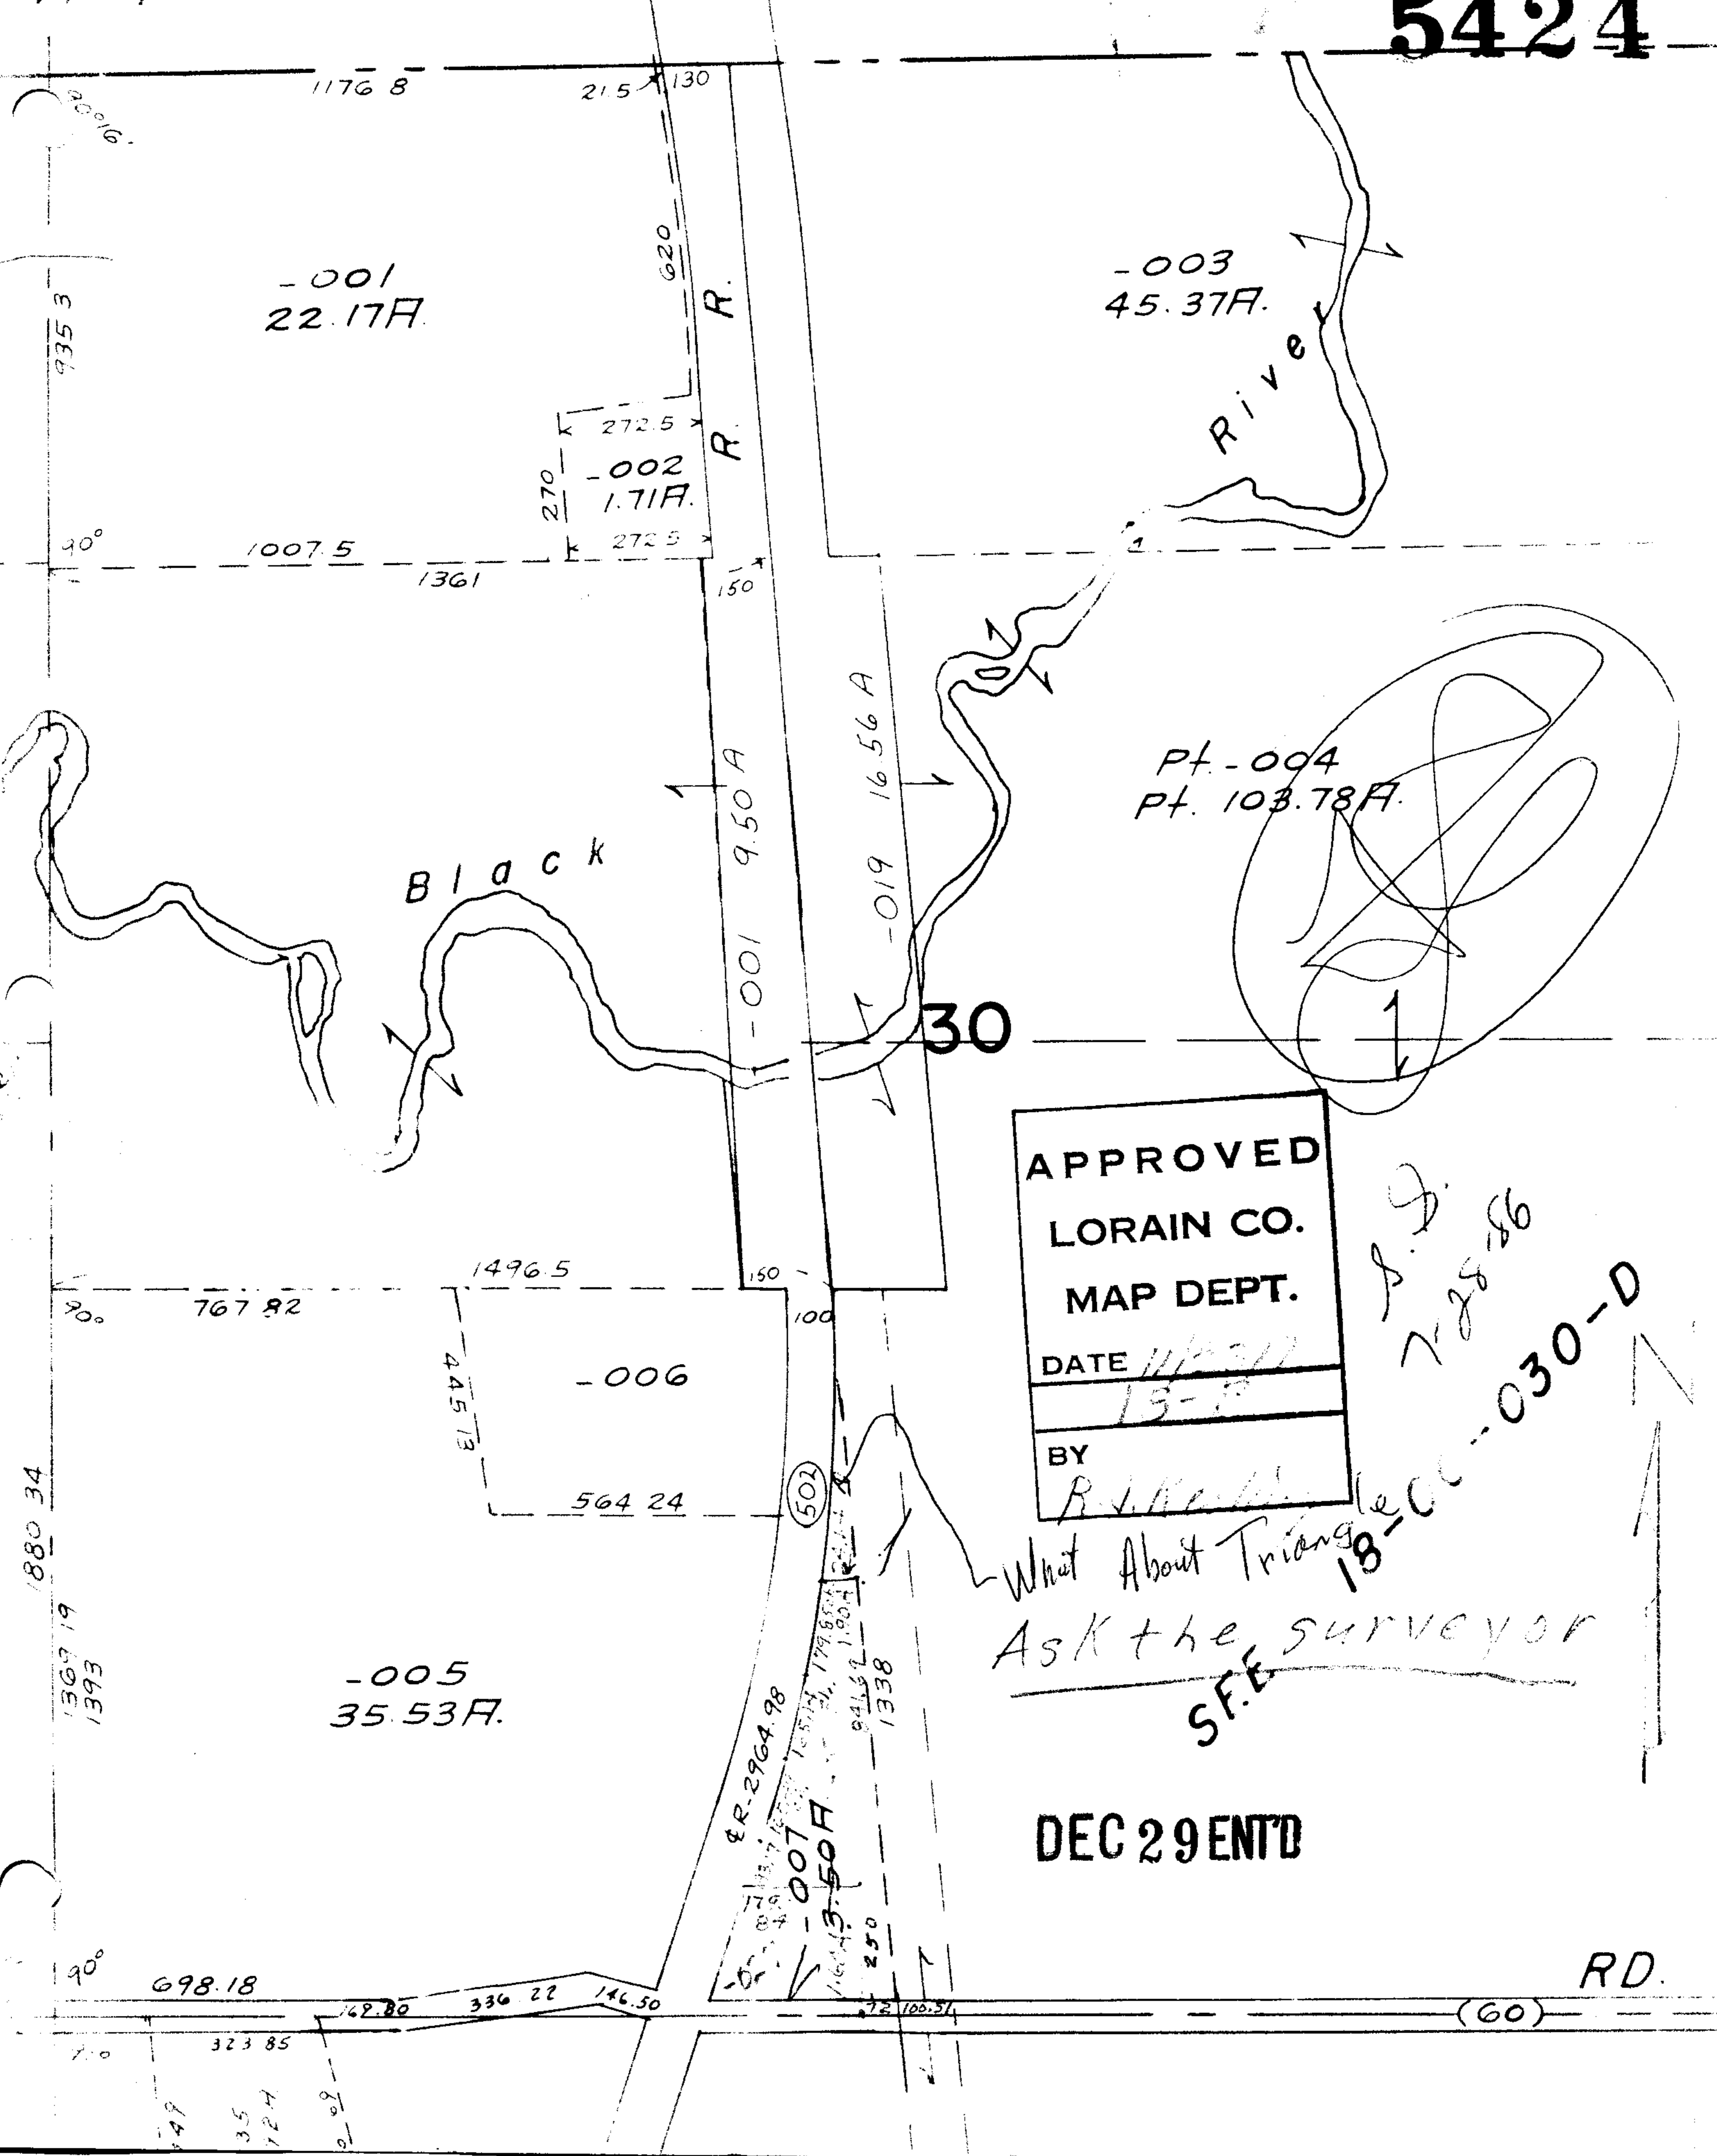

-001
22.17A

-003
45.37A

-002
1.71A

Pt. -004
Pt. 103.78A

Black

30

APPROVED
LORAIN CO.
MAP DEPT.
DATE 11/23/17
15-F
BY R. J. ...

P. J.
7-28-86
18-CC-030-D

What About Triangle
Ask the surveyor
S.F.E.

DEC 29 ENT'D

RD.

(60)

-005
35.53A

-006

(50)

-007
13.50A

ER-2964.98

323.85

149
35
124
0.09

698.18

29.80

336.22

146.50

72 100.57

250

1338

1804

179.88

10574

100

150

150

1007.5

1361

270

272.5

272.5

-001 9.50A

-019 16.56A

1176.8

21.5 130

620

935.3

90°

90°

90°

7.0



































