



5428

pt. 02-01-004-501-045
Pt. 21.27A.

APPROVED
LORAIN CO.
MAP DEPT.
DATE 11/24/71
2-01-004-B
BY
R. J. Kelling

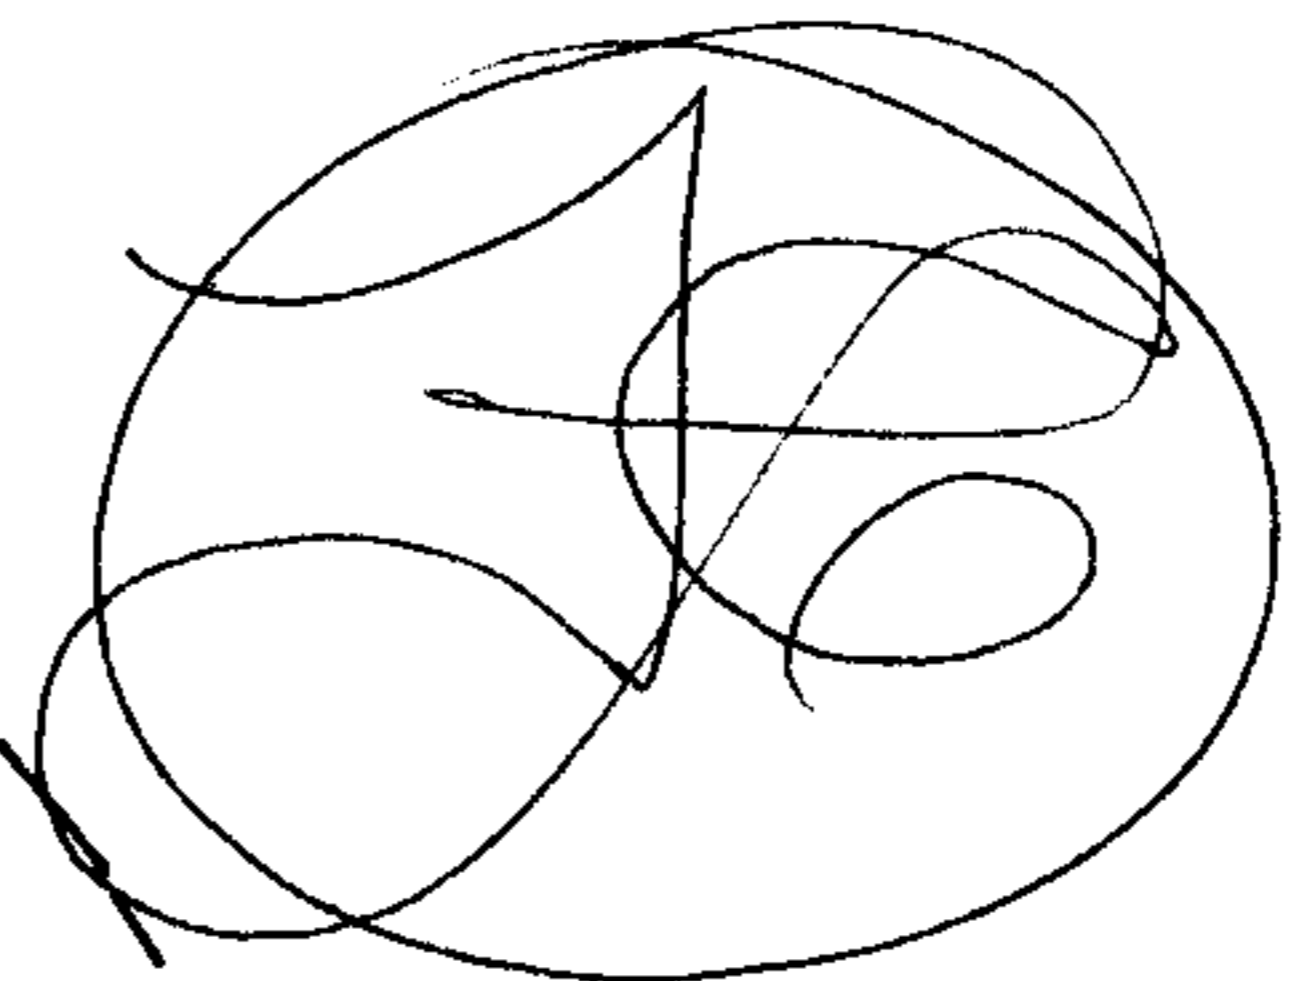

DEC 29 ENT'D

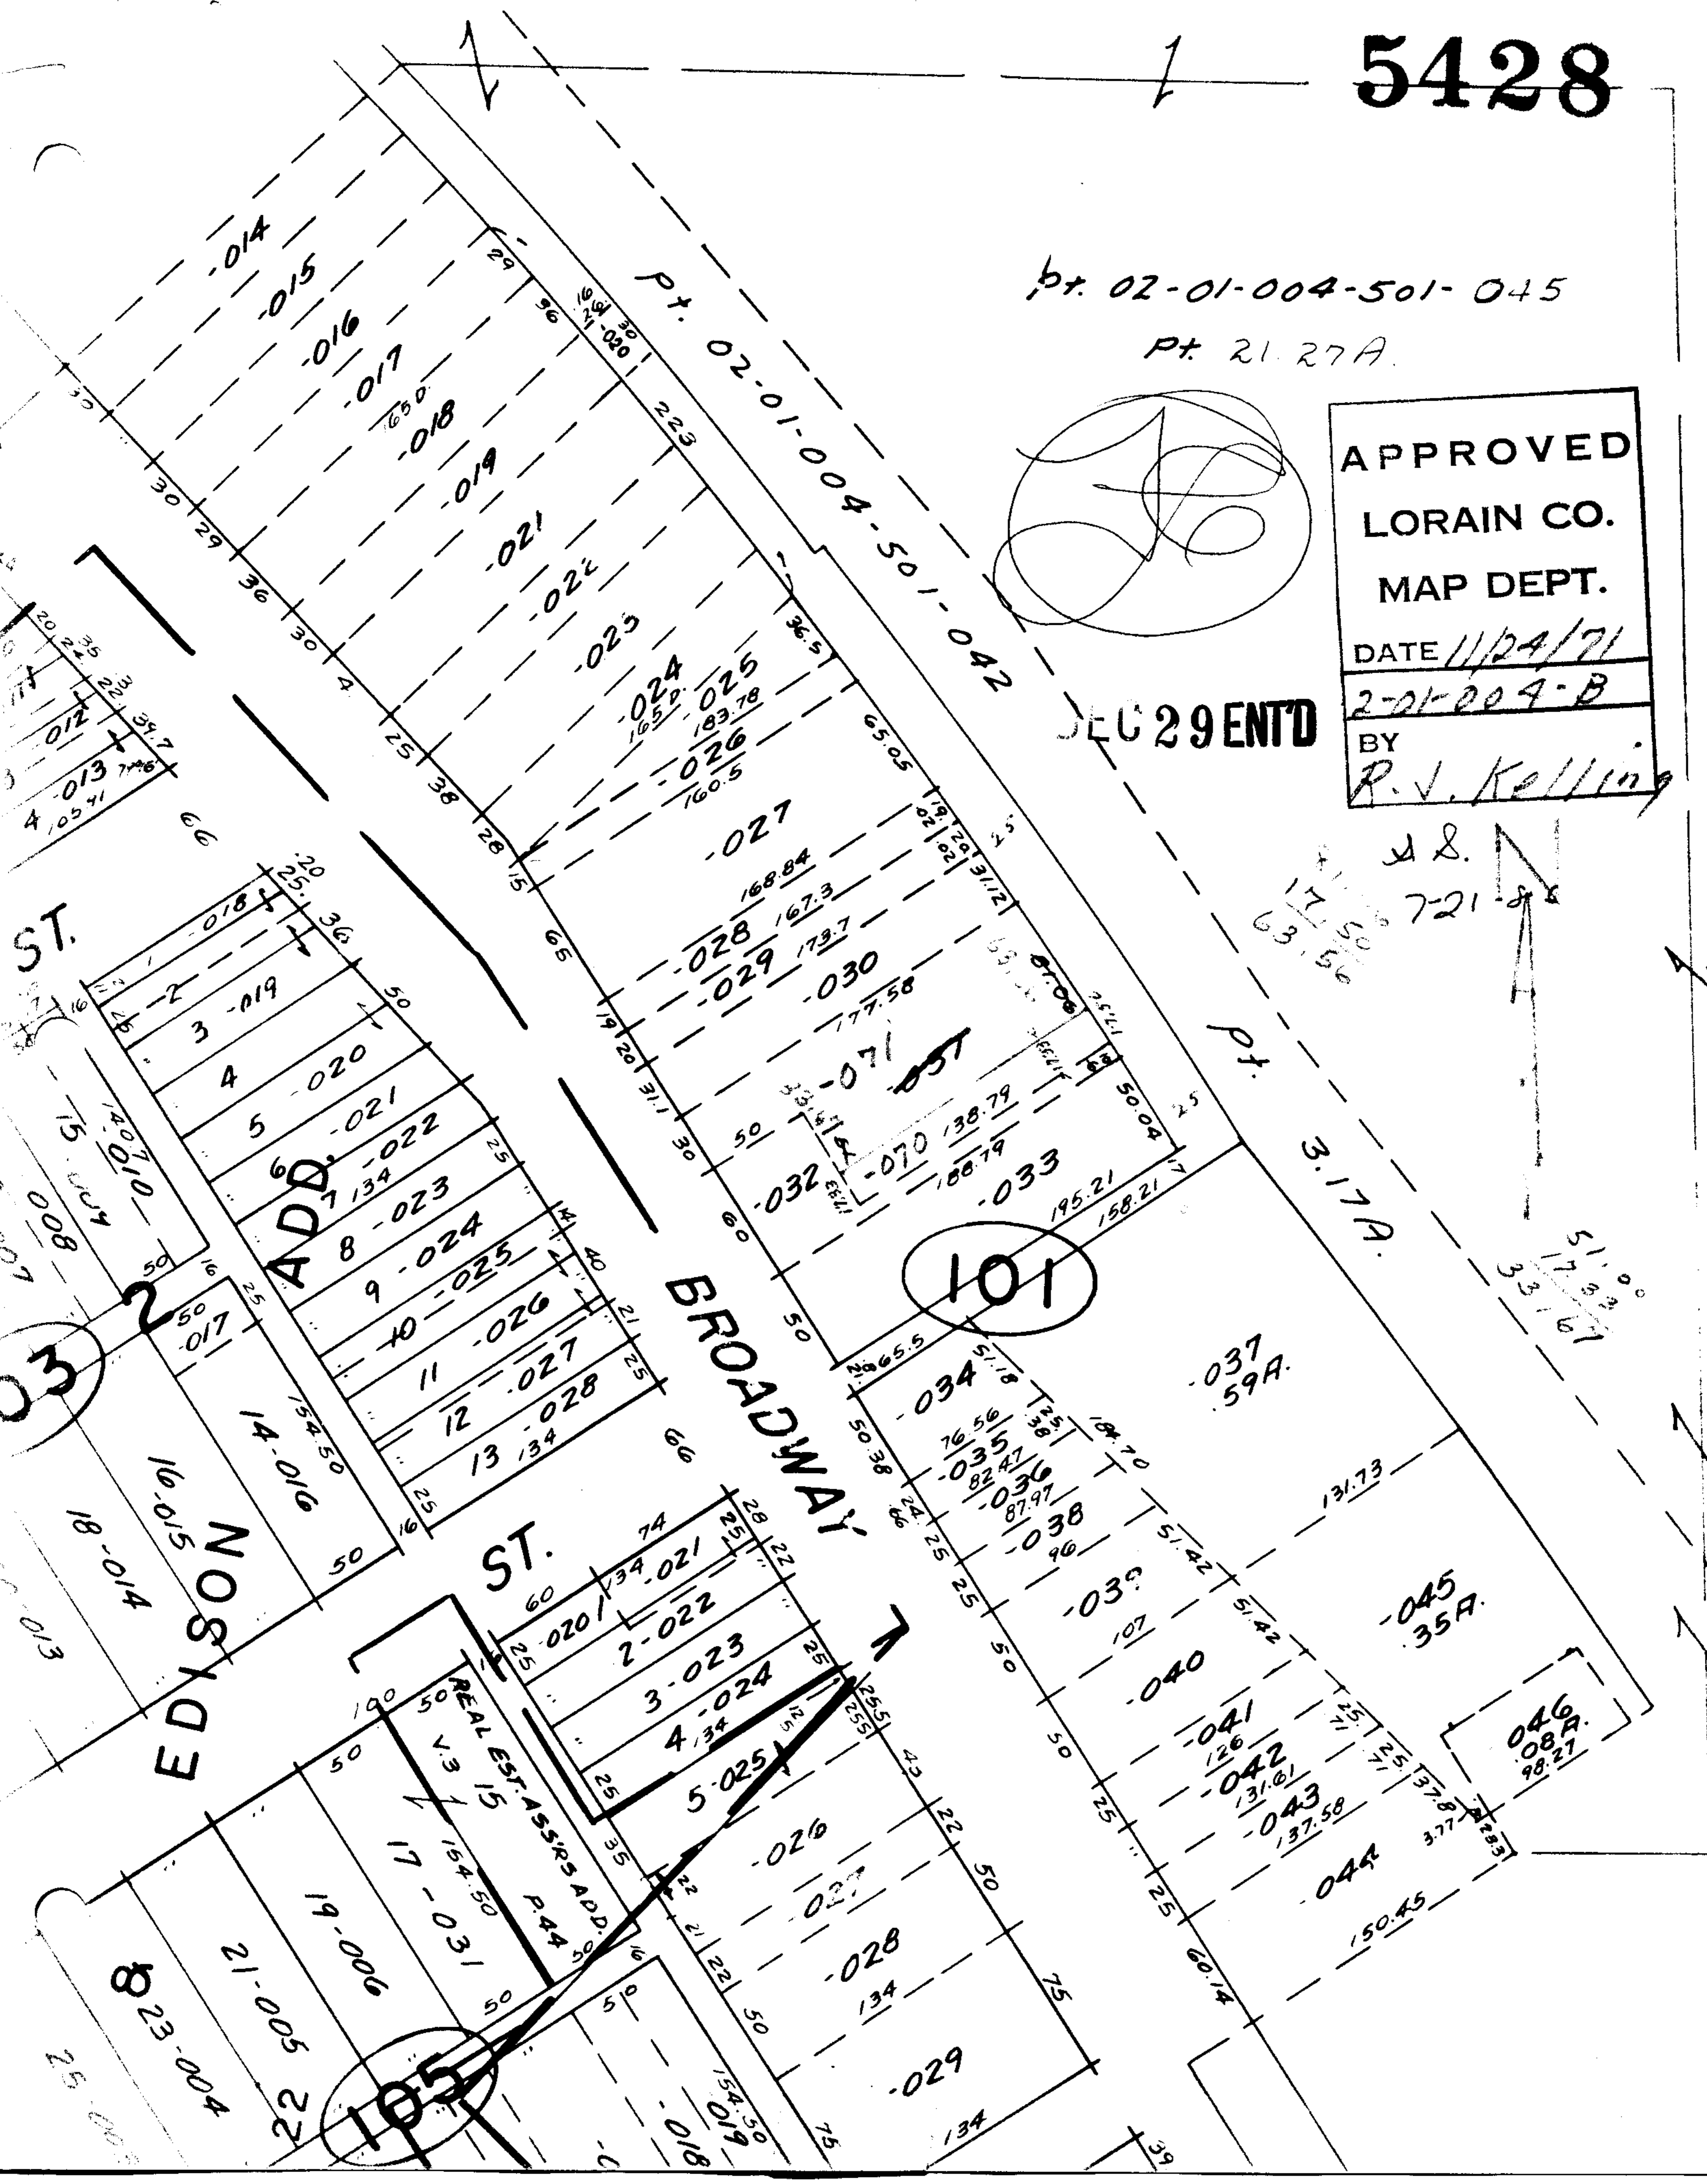

EDISON ST.
18-014
16-015
14-016

BROADWAY ST.
17-031

101
101
037 59A
045 35A
046 08A 98.27
044 37.7
043 137.58
042 131.61
041 126
039 51.42
038 96
036 87.97
035 82.47
034 76.56
033 195.21
032 177.58
031 188.79
030 173.7
029 167.3
028 168.84
027 160.5
026 183.78
025 165.9
