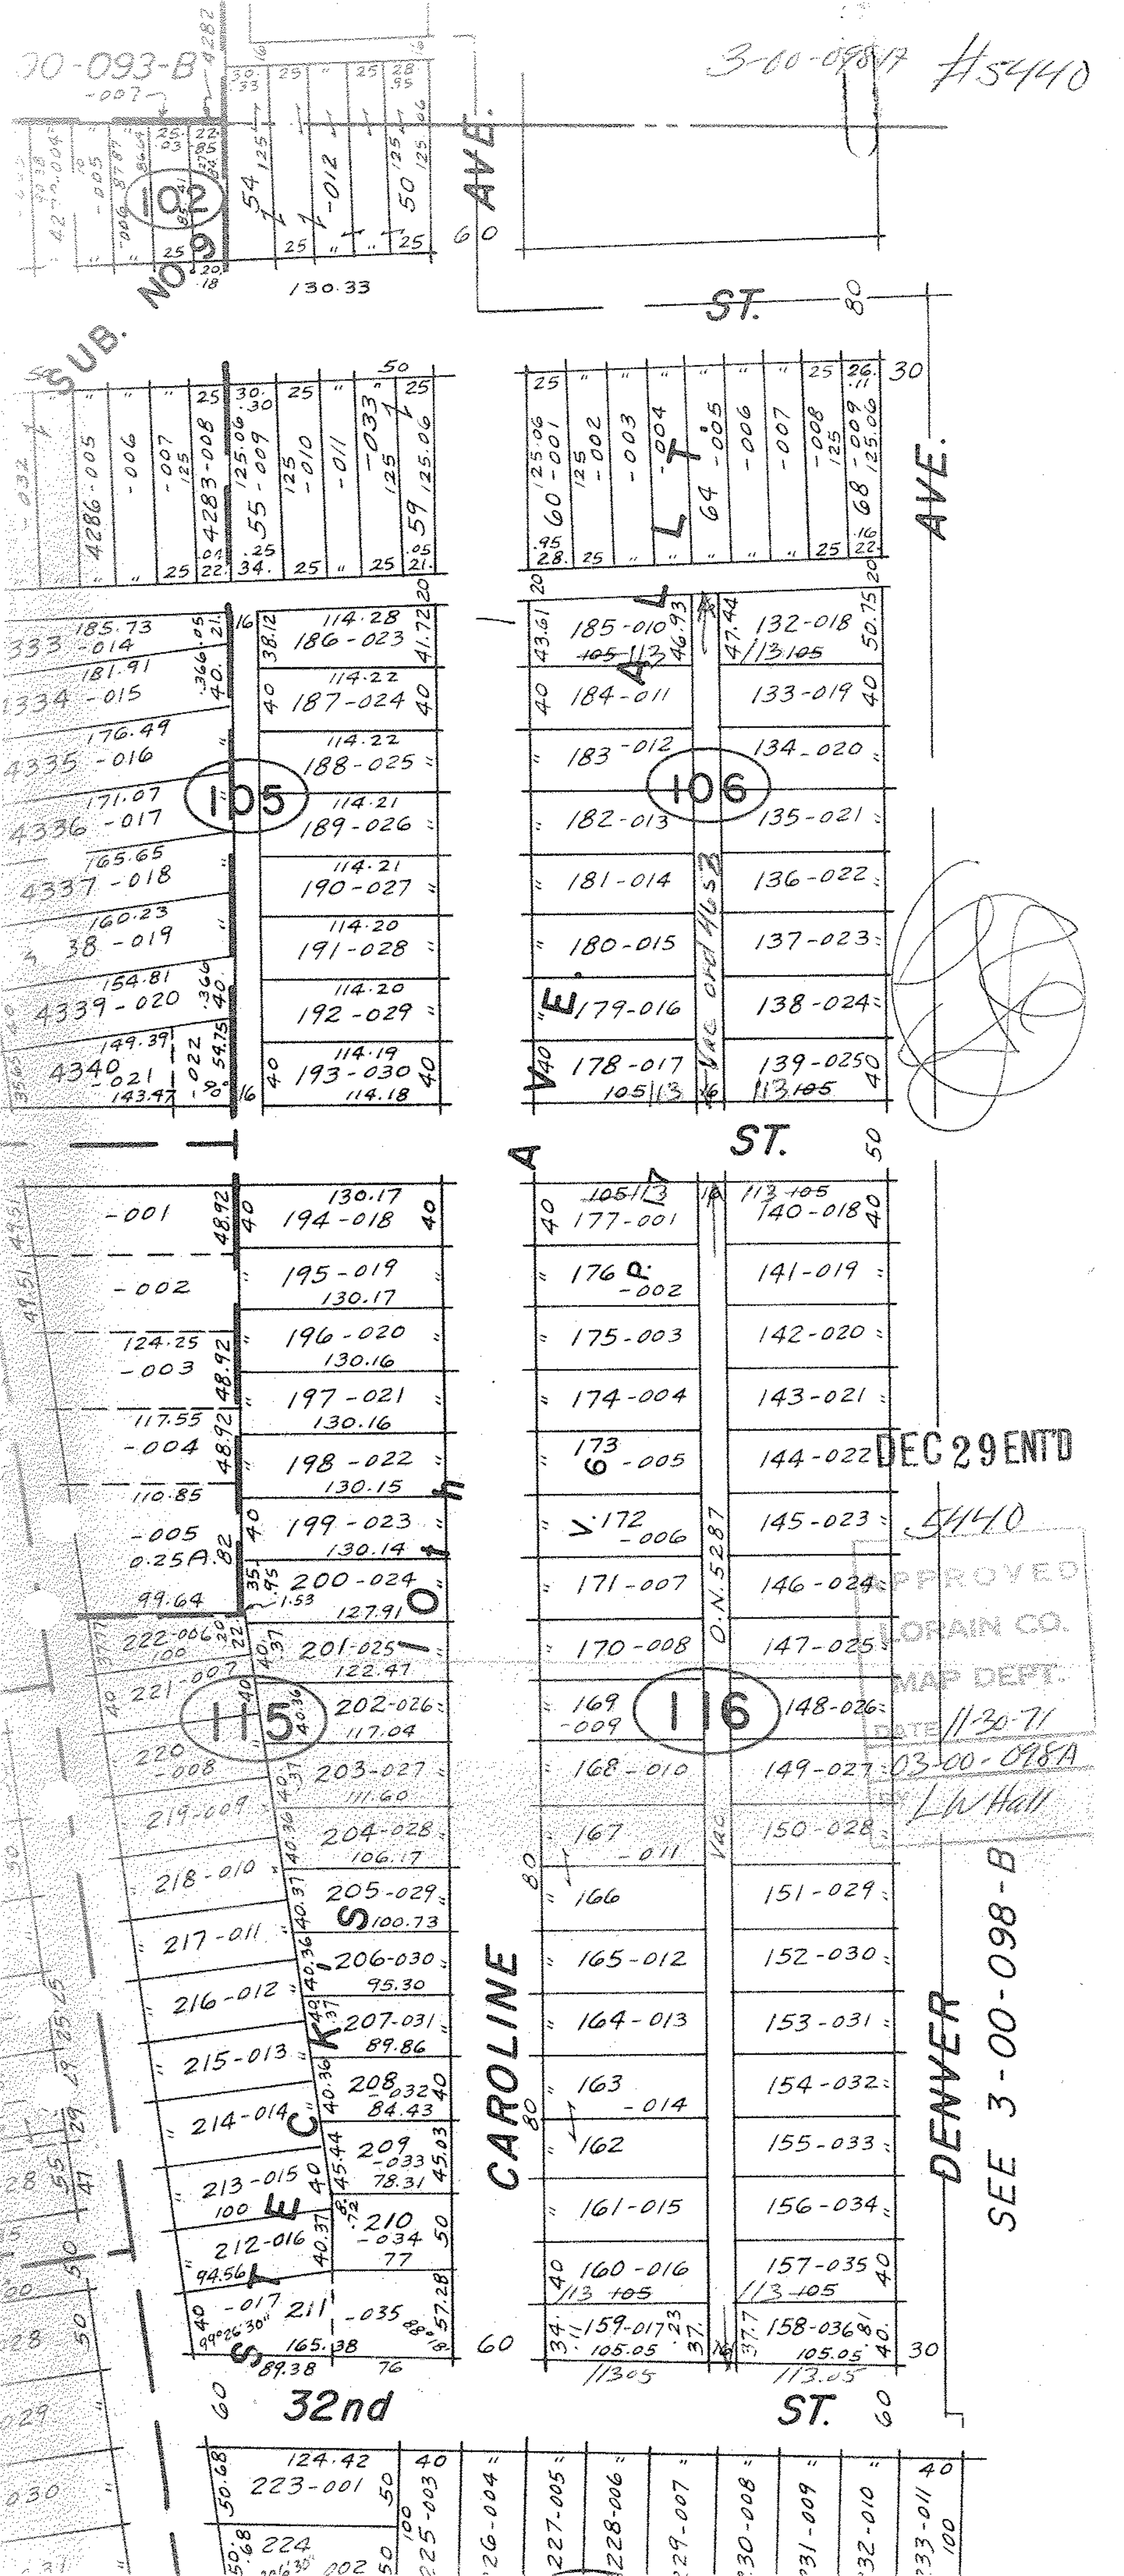
3-00-098A #5440
SUB. NO. 9
102
105
106
115
116
AVE.
ST.
CAROLINE
DENVER
32nd
ST.
Vac ord 4653
O.N. 5287
Vac
DEC 29 ENT'D
5440
APPROVED
LORAIN CO.
MAP DEPT.
DATE 11-30-71
03-00-098A
BY LW Hall
SEE 3-00-098-B