

5448  
5448

SUNNYSIDE

-002  
12.80F.

-001  
53.80F.

NORTH RIDGE

44

-020  
20.01A

-004  
12.98F.

CLAUS

-015  
4.20A.

-013  
6.00A.

-011  
10.69F.

9.62F.

-010

-005  
6.62F.

-007  
3.92F.

-008  
2.00F.

-002  
2.00F.

-003  
1.83F.

-005  
50F.

-009  
7.54F.

5448


APPROVED

LORAIN CO.


MAP DEPT.

DATE

-012  
32.37F.

BY

*[Signature]*

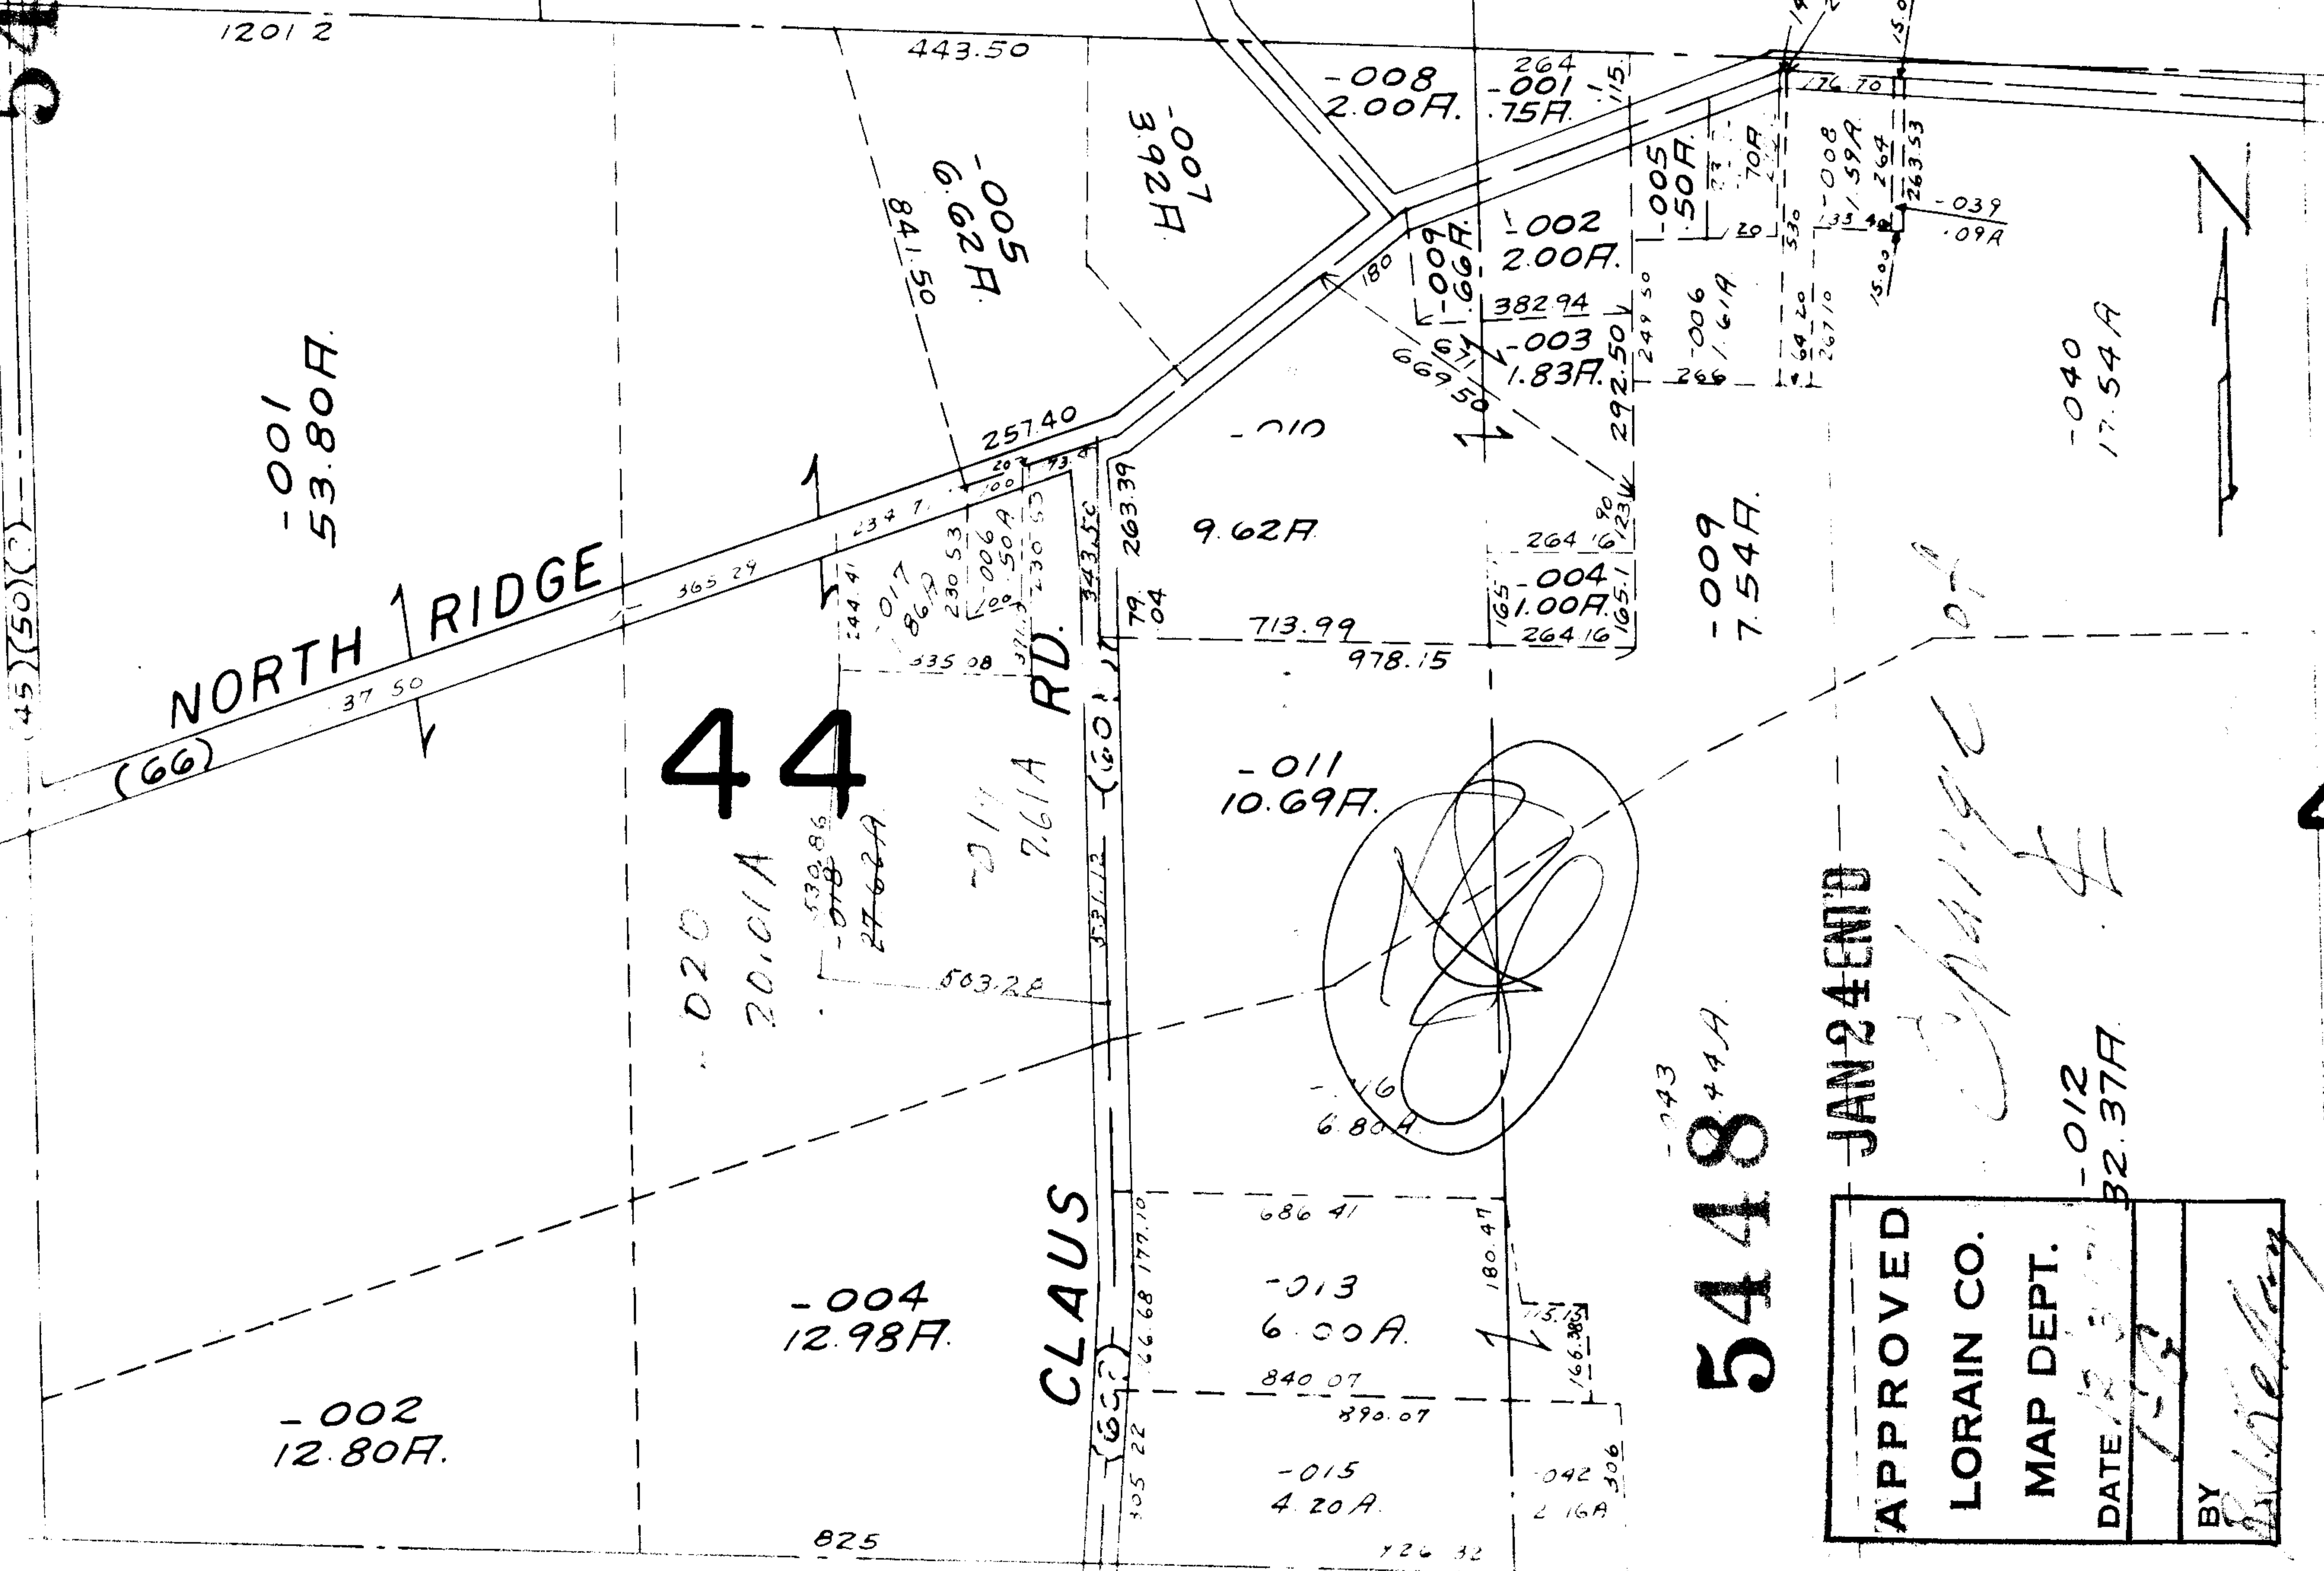

4