


5458

SEE 5-00-036-B

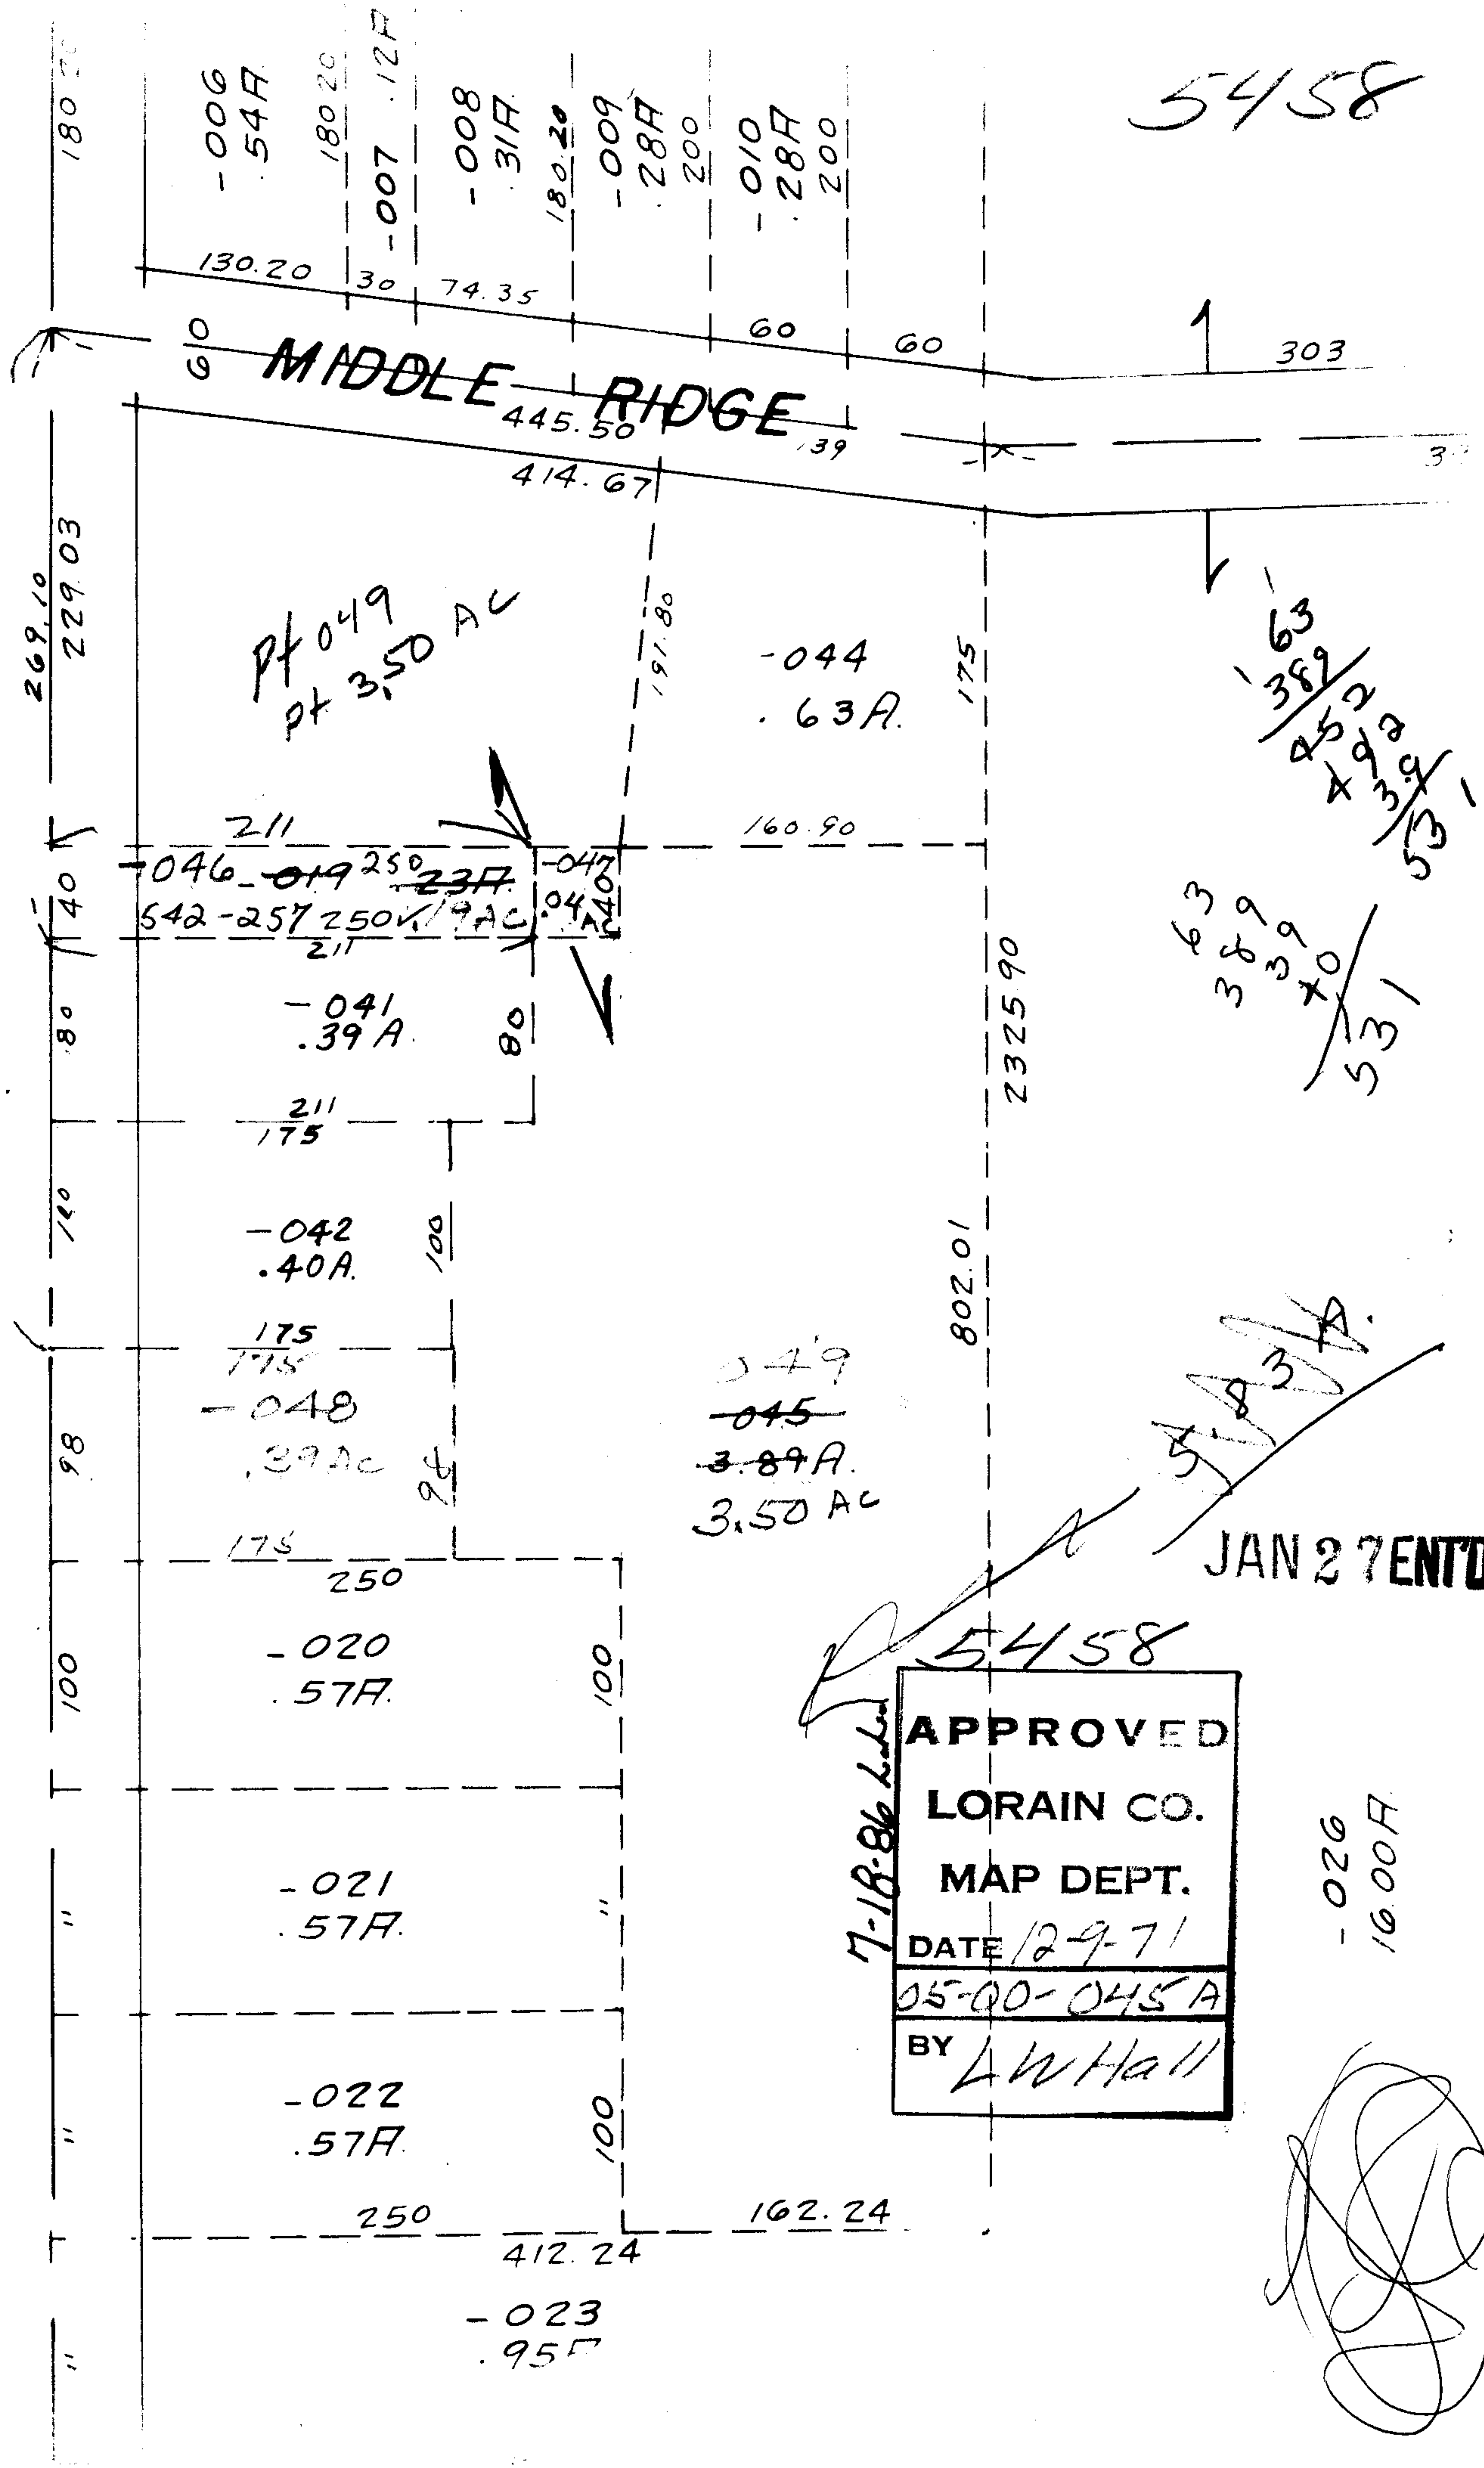

985  
118  
969

2.74

449.10

269.10  
229.03

40

80

140

98

100

"

"

"

Pt 049  
Pt 3.50 AC

211  
-046 -019 250  
542-257 250 AC  
211

-041  
.39 A.

211  
175

-042  
.40 A.

175  
175

-048  
.39 AC

175

250

-020  
.57 A.

-021  
.57 A.

-022  
.57 A.

250

-023  
.95 A.

-044  
.63 A.

049  
045  
3.89 A.  
3.50 AC

63  
389  
399  
+0  
531

63  
389  
399  
+0  
531


JAN 27 ENTD

5458

**APPROVED**

**LORAIN CO.**

**MAP DEPT.**

DATE 12-9-71

05-00-045 A

BY LWHall

7-18-86 L.L.H.

16.00 A.

