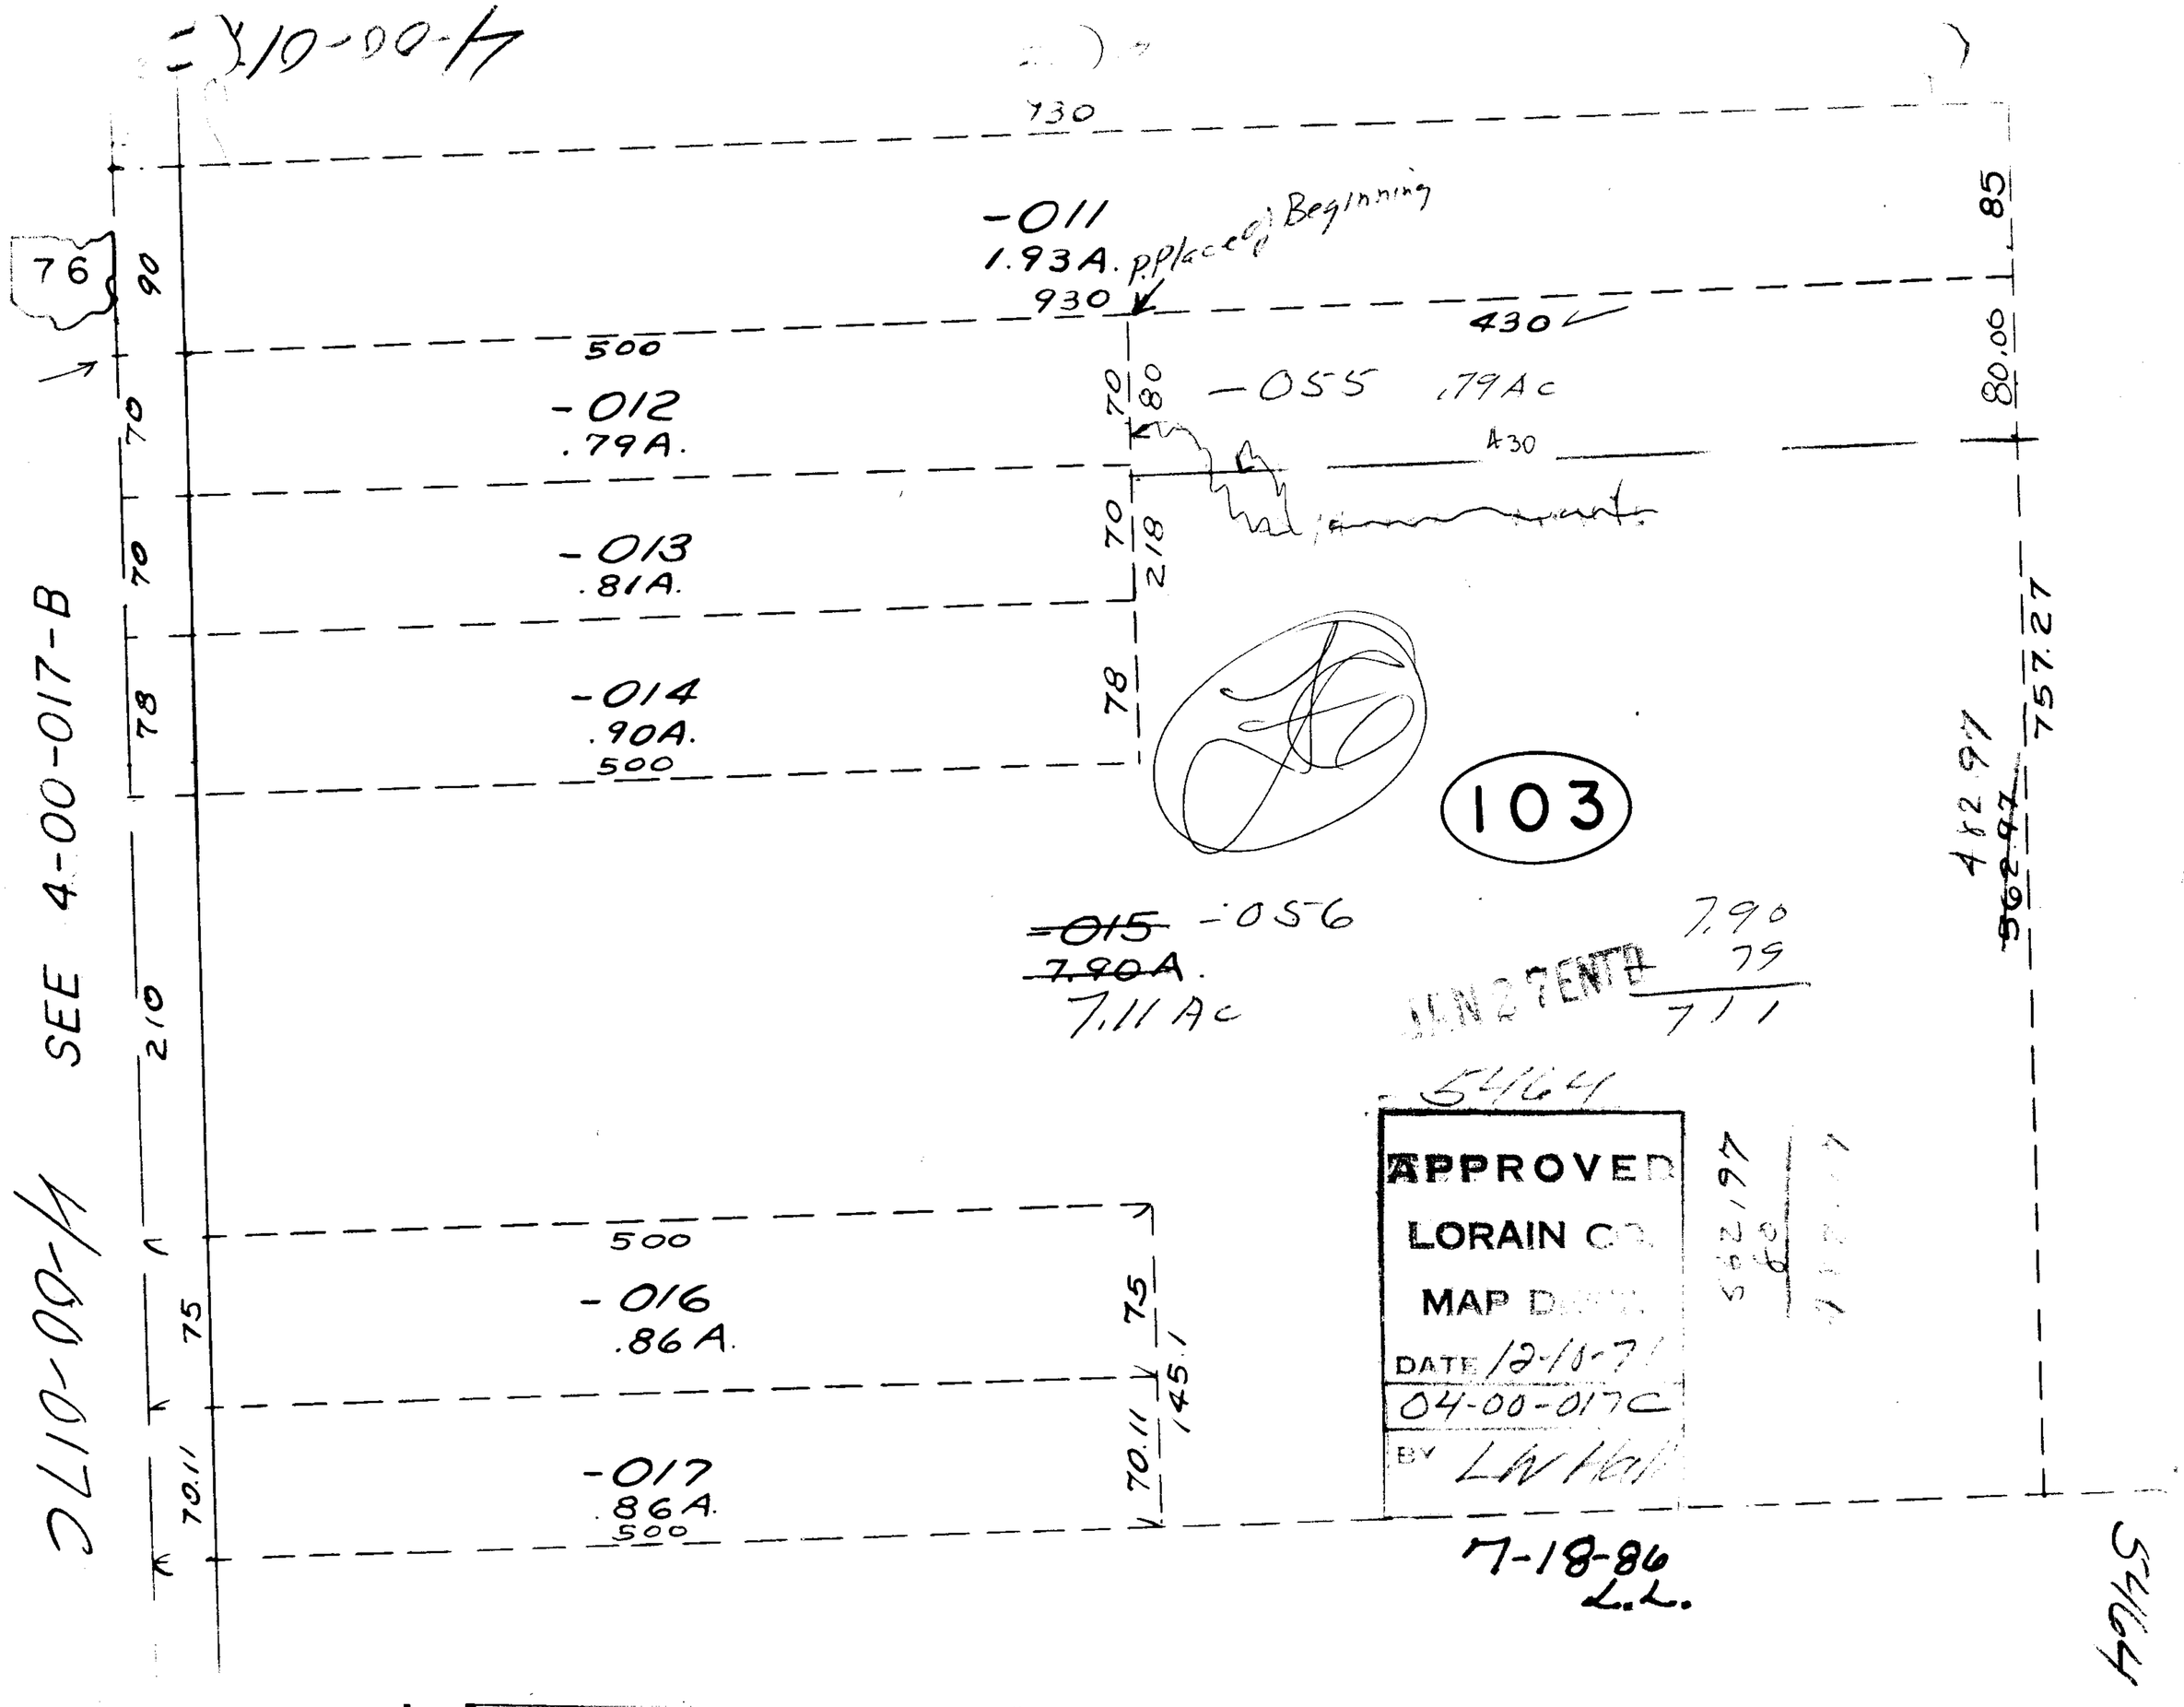

4-00-017-B
SEE 4-00-017-C
76
90
70
70
78
210
75
70.11
730
-011
1.93A. p.place of Beginning
930
430
500
-012
.79A.
70
80
-055 .79Ac
430
-013
.81A.
70
218
-014
.90A.
500
78
103
~~-015~~ -056
~~7.90A.~~
7.11 Ac
7.90
79
711
JAN 27 ENTD
5464
APPROVED
LORAIN CO.
MAP DEPT.
DATE 12-10-71
04-00-017C
BY LW Hall
500
-016
.86A.
75
145.1
70.11
-017
.86A.
500
7-18-86
L.L.
85
80.00
757.27
482.97
562.97
562.97
5464