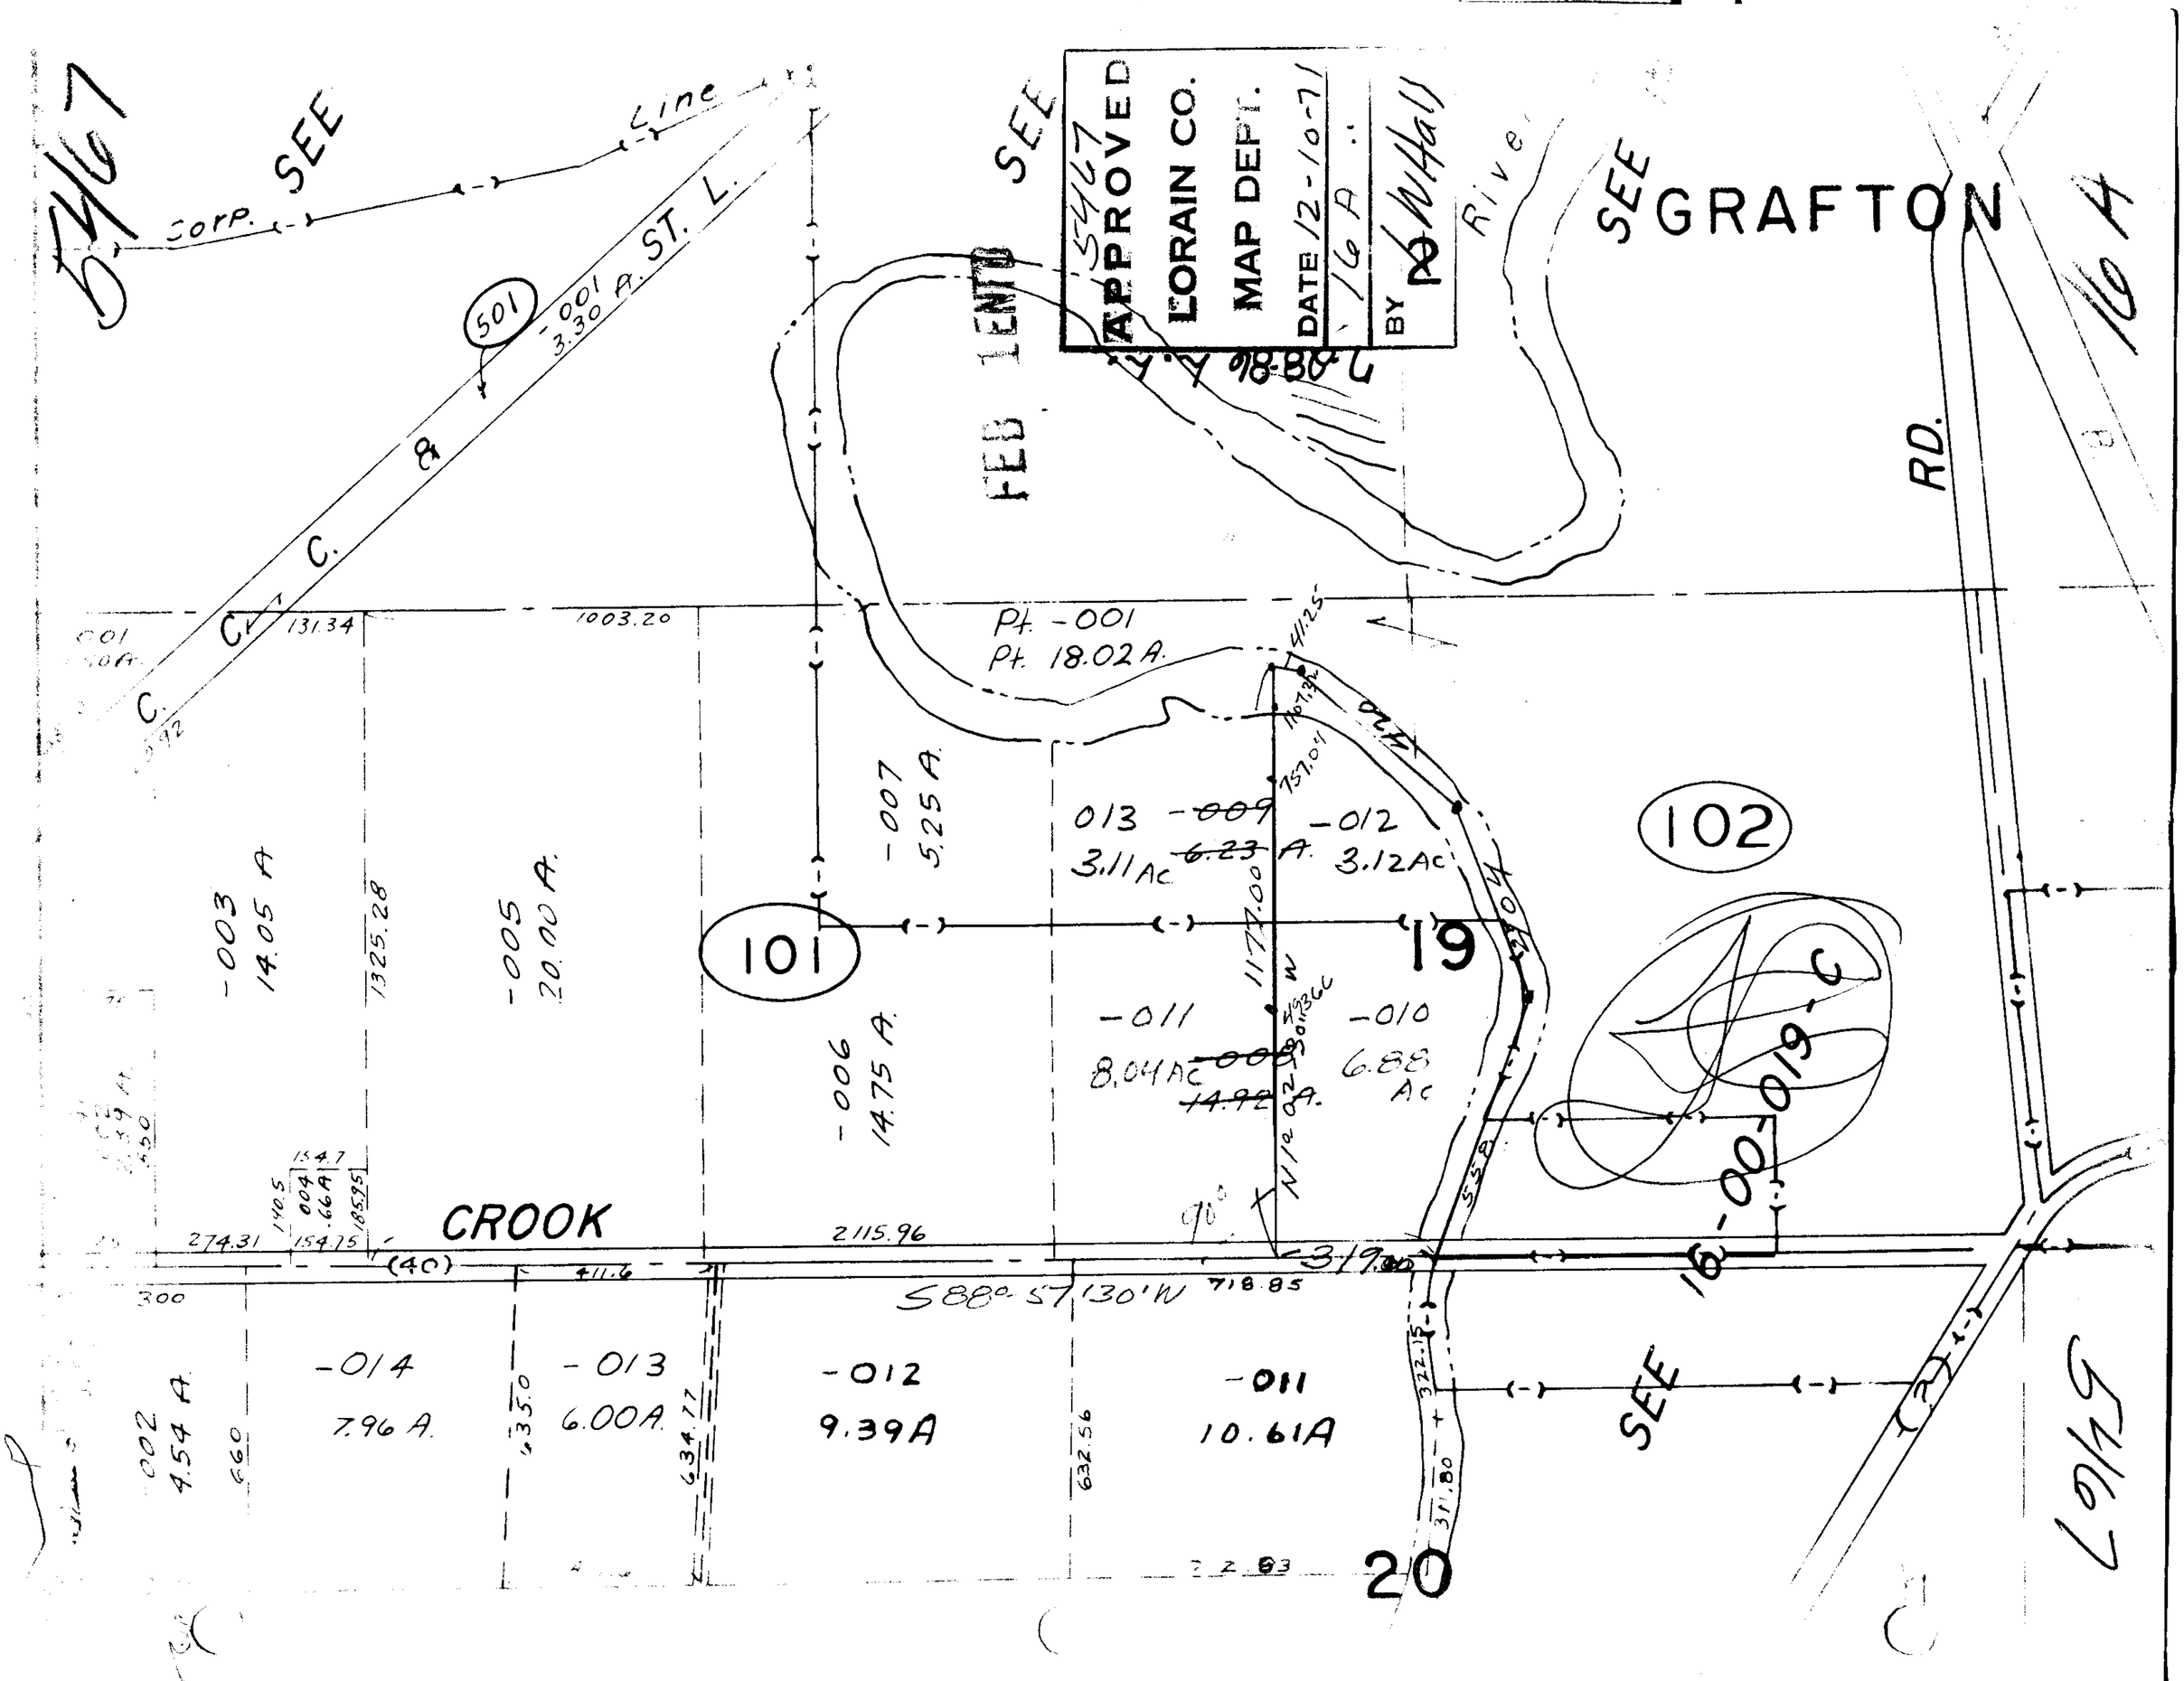

5467
APPROVED
LORAIN CO.
MAP DEPT.
DATE 12-10-71
16 A
BY
SEE
Corp. Line
501
-001
3.30 A.
ST. L.
C. & C.
SEE
FEB 1 ENTD
5467
APPROVED
LORAIN CO.
MAP DEPT.
DATE 12-10-71
16 A
BY
River
SEE
GRAFTON
16 A
RD.
131.34
1003.20
Pt. -001
Pt. 18.02 A.
-007
5.25 A.
013
3.11 Ac
-009
6.23 A.
-012
3.12 Ac
102
-003
14.05 A
1325.28
-005
20.00 A.
101
19
-006
14.75 A.
-011
8.04 Ac
-008
14.92 A.
-010
6.88 Ac
16-00-019-C
CROOK
274.31
2115.96
(40)
411.6
S88°57'30"W
718.85
-014
7.96 A.
-013
6.00 A.
-012
9.39 A
-011
10.61 A
SEE
5467
20