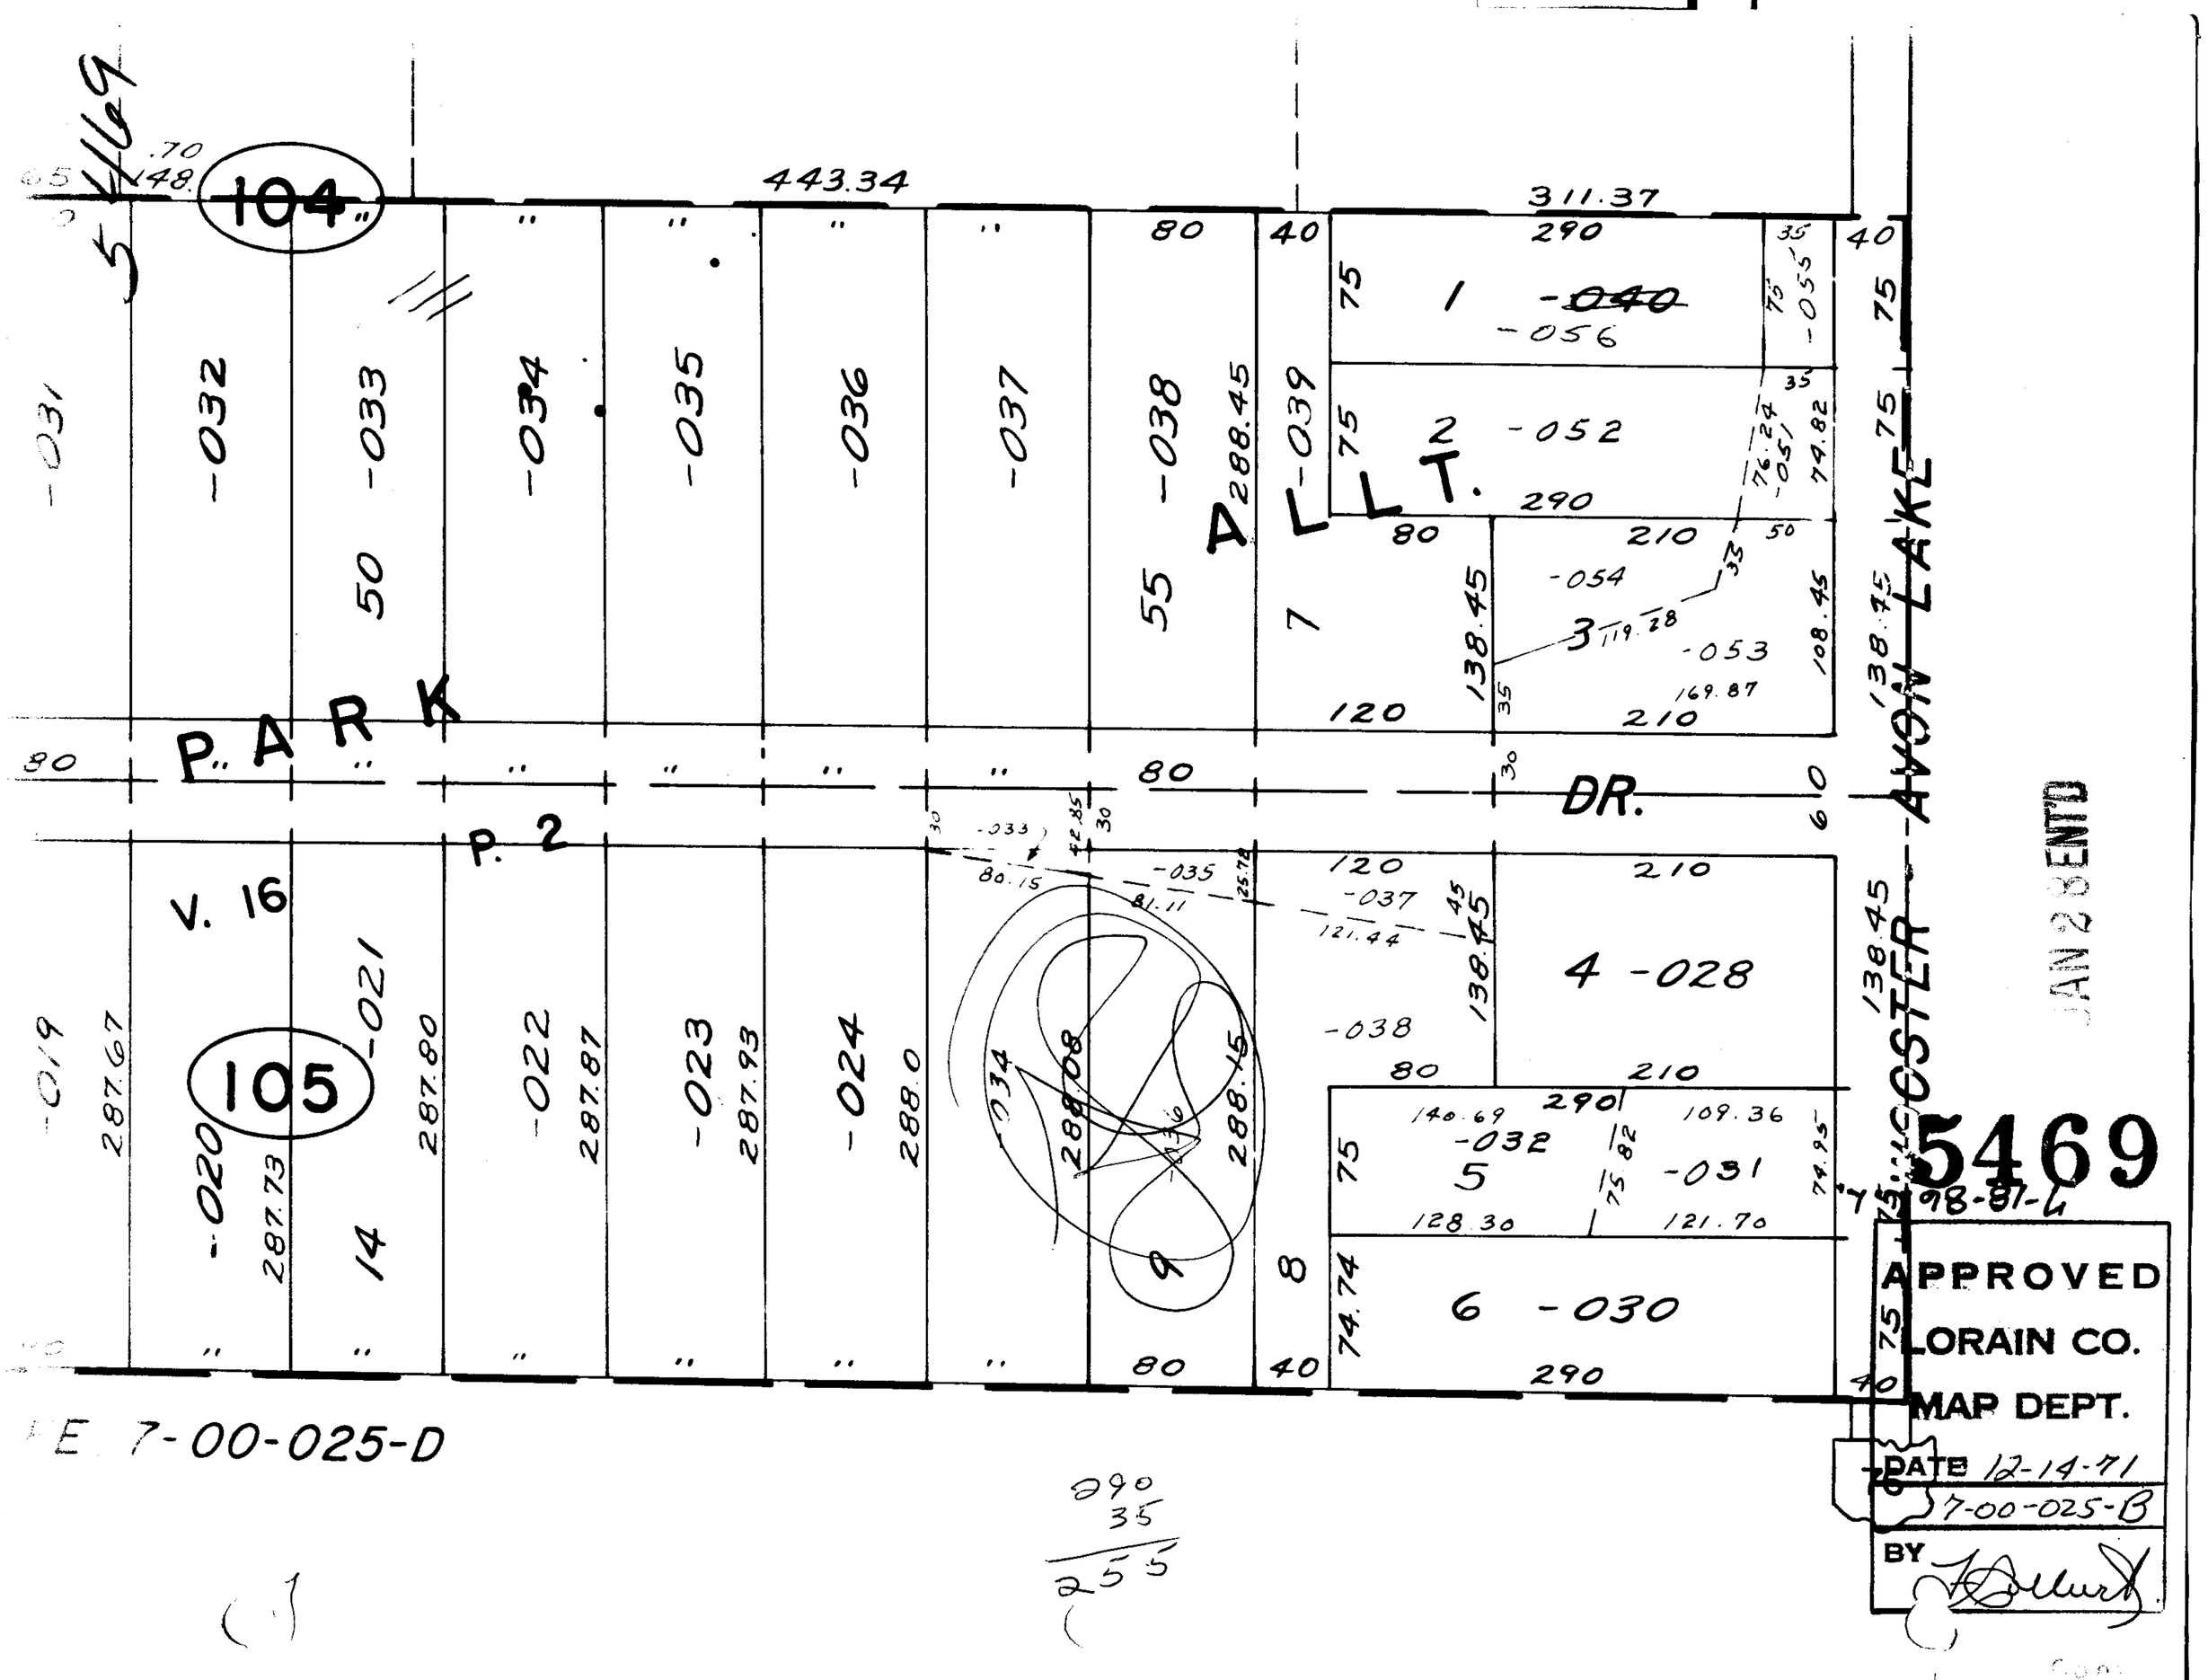

104
105
443.34
311.37
PARK
ALLT.
DR.
AVON LAKE
WOOSTER
V. 16
P. 2
-031
-032
-033
-034
-035
-036
-037
-038
-039
-040
-056
-052
-054
-053
-055
-051
-019
-020
-021
-022
-023
-024
-028
-030
-032
-031
-033
-035
-037
-038
-034
-036
288.45
288.08
288.15
138.45
108.45
119.28
169.87
140.69
109.36
128.30
121.70
74.74
74.95
75.82
76.24
74.82
80.15
81.11
121.44
287.67
287.73
287.80
287.87
287.93
288.0
E 7-00-025-D
5469
98-81-4
APPROVED
LORAIN CO.
MAP DEPT.
DATE 12-14-71
7-00-025-B
BY
JAN 28 ENT'D
290
35
255