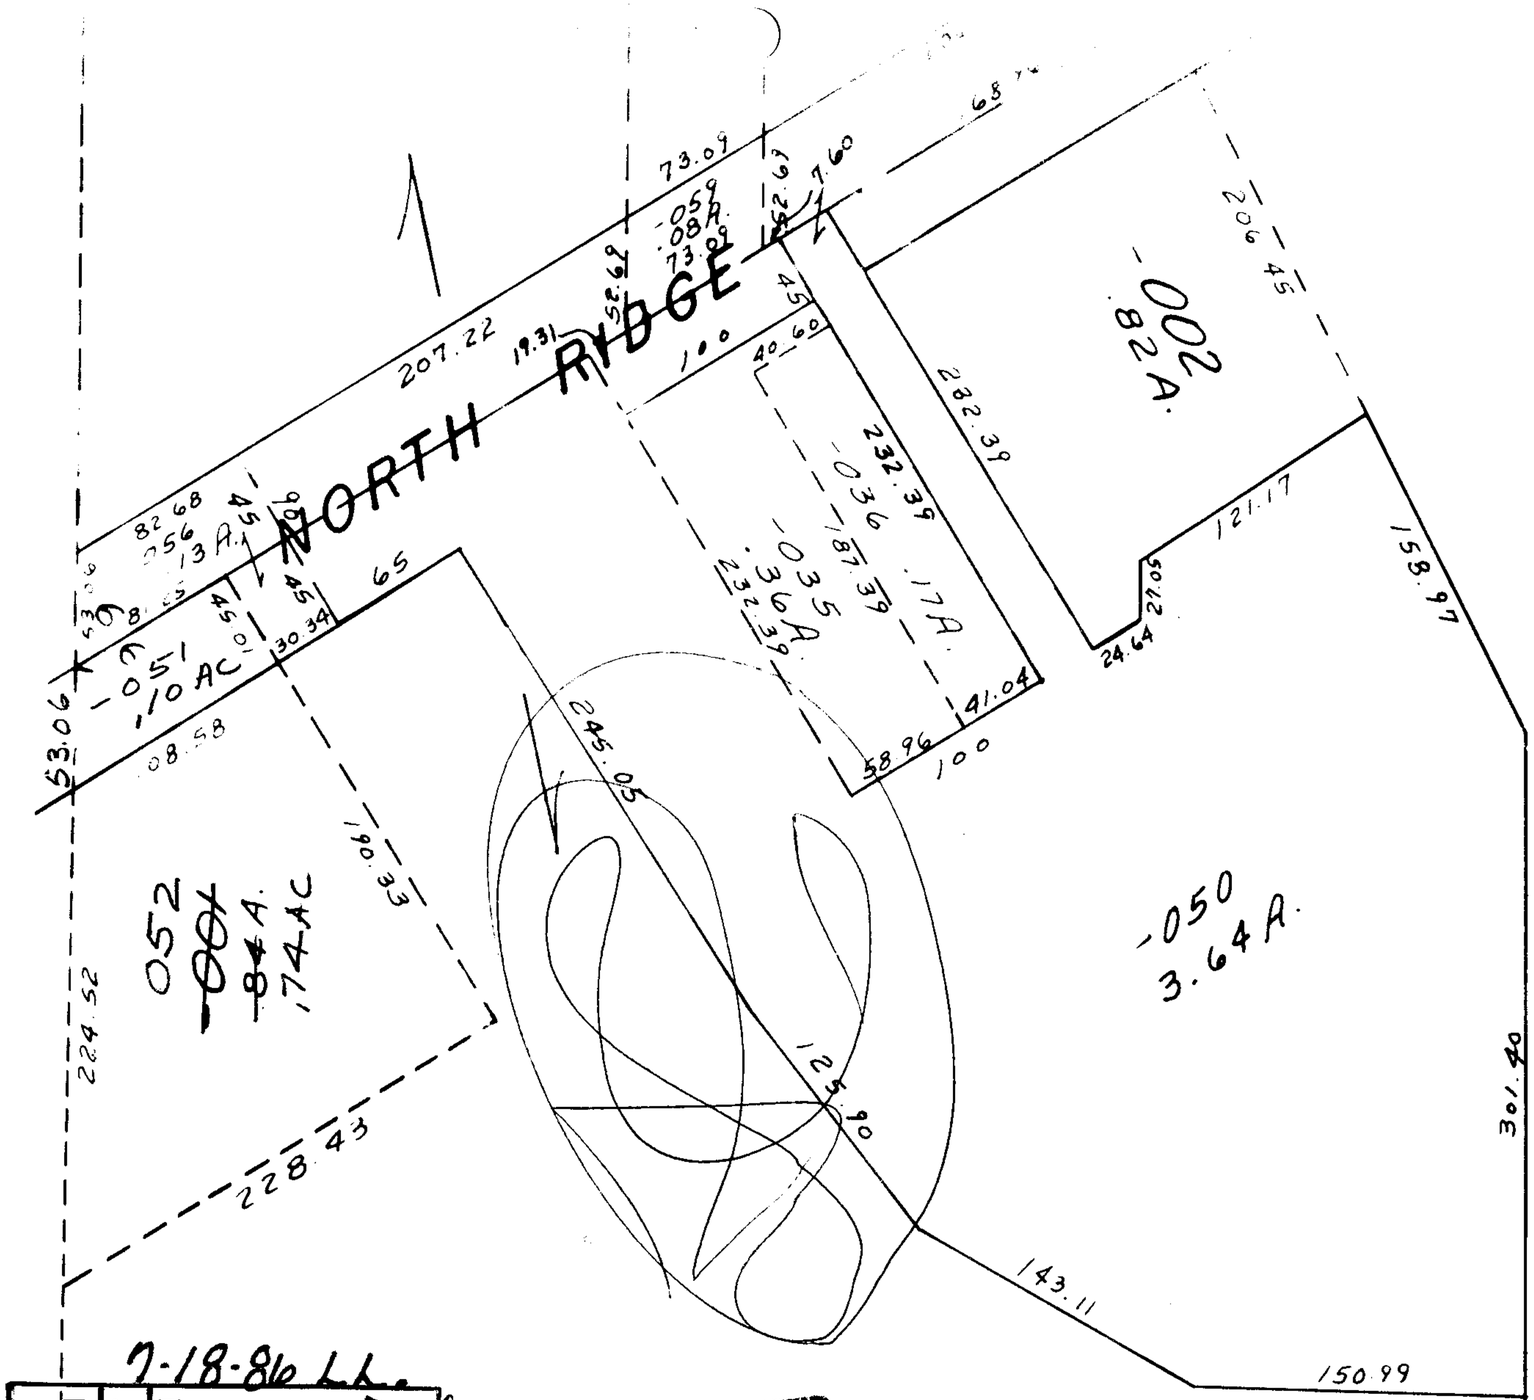

109

Pt - 004
Pt 8.88 A

5475

7-18-86 LL.

APPROVED
LORAIN CO.
MAP DEPT.
DATE 12-16-71
4-00-015-B
BY LMHall

JAN 26 ENT'D

Pt 04-00-015-101-058
Pt. 39.10 A.

4-00-015-B