



5480

Map Correction
Change Location
P.D. No 011 To 011
Red
Change Location
012
3.44 AC To
Authority DV 795-Pg 563
Case 65633

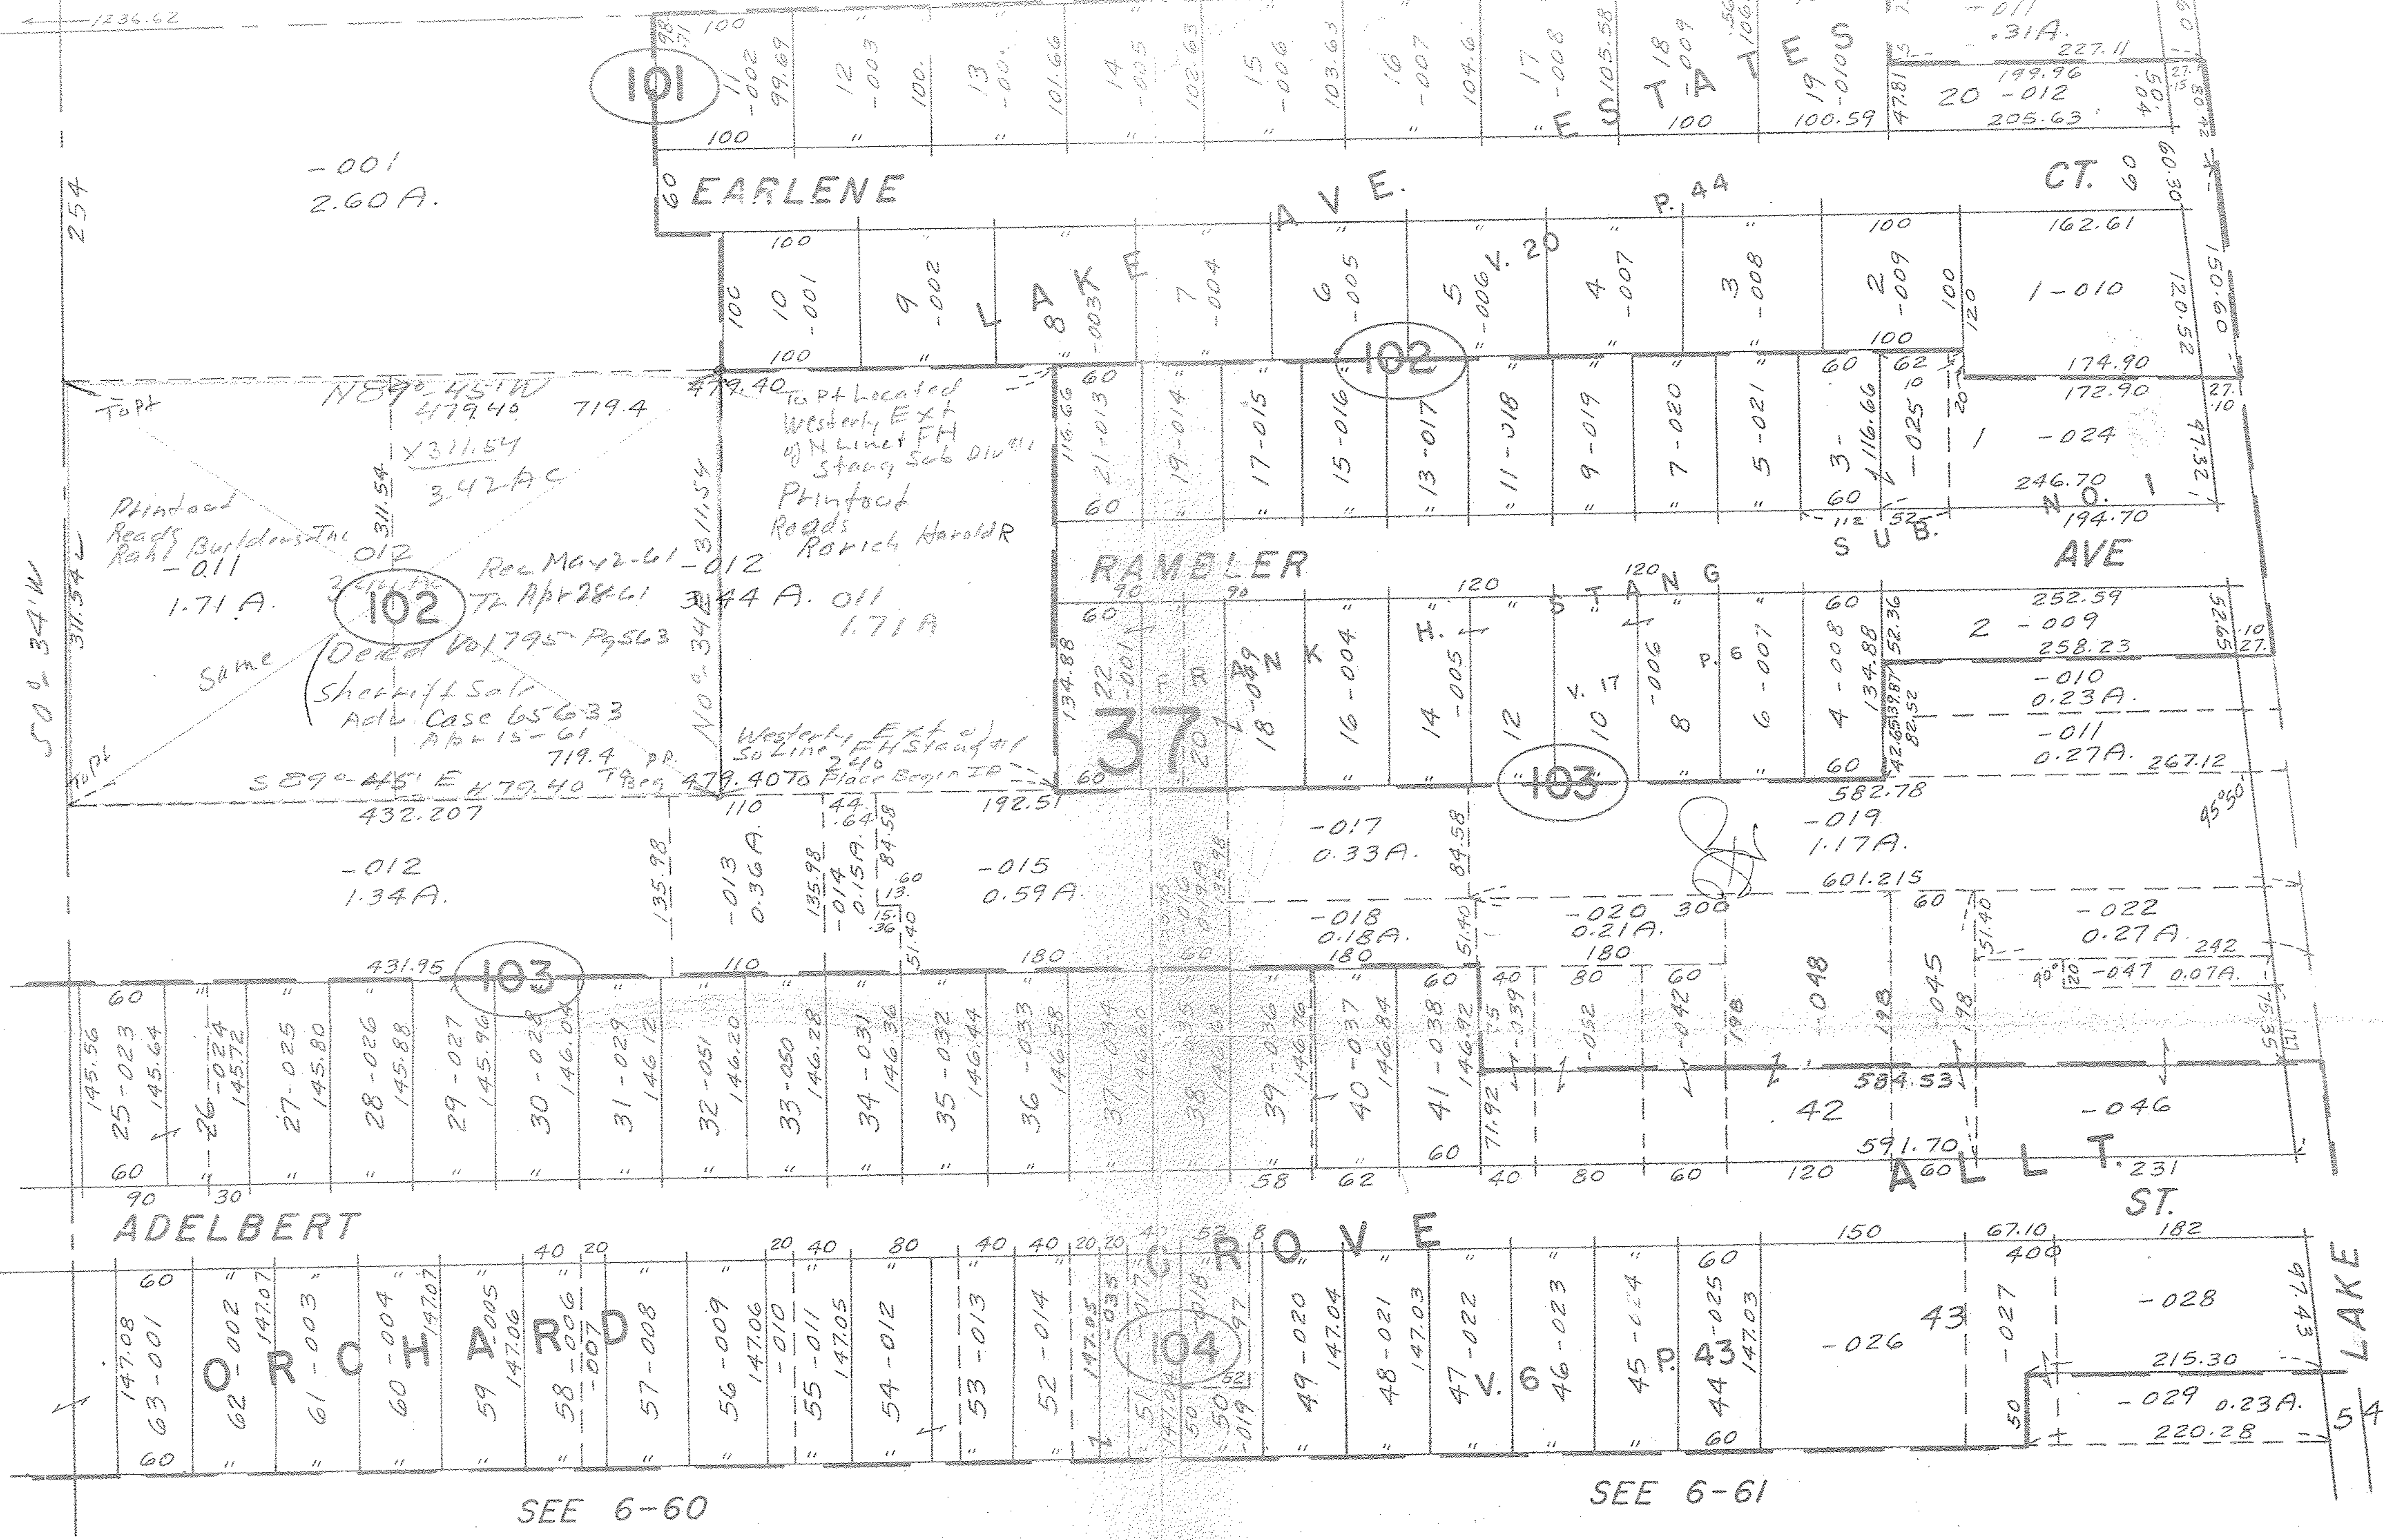

Note Coenter Map
Corrected

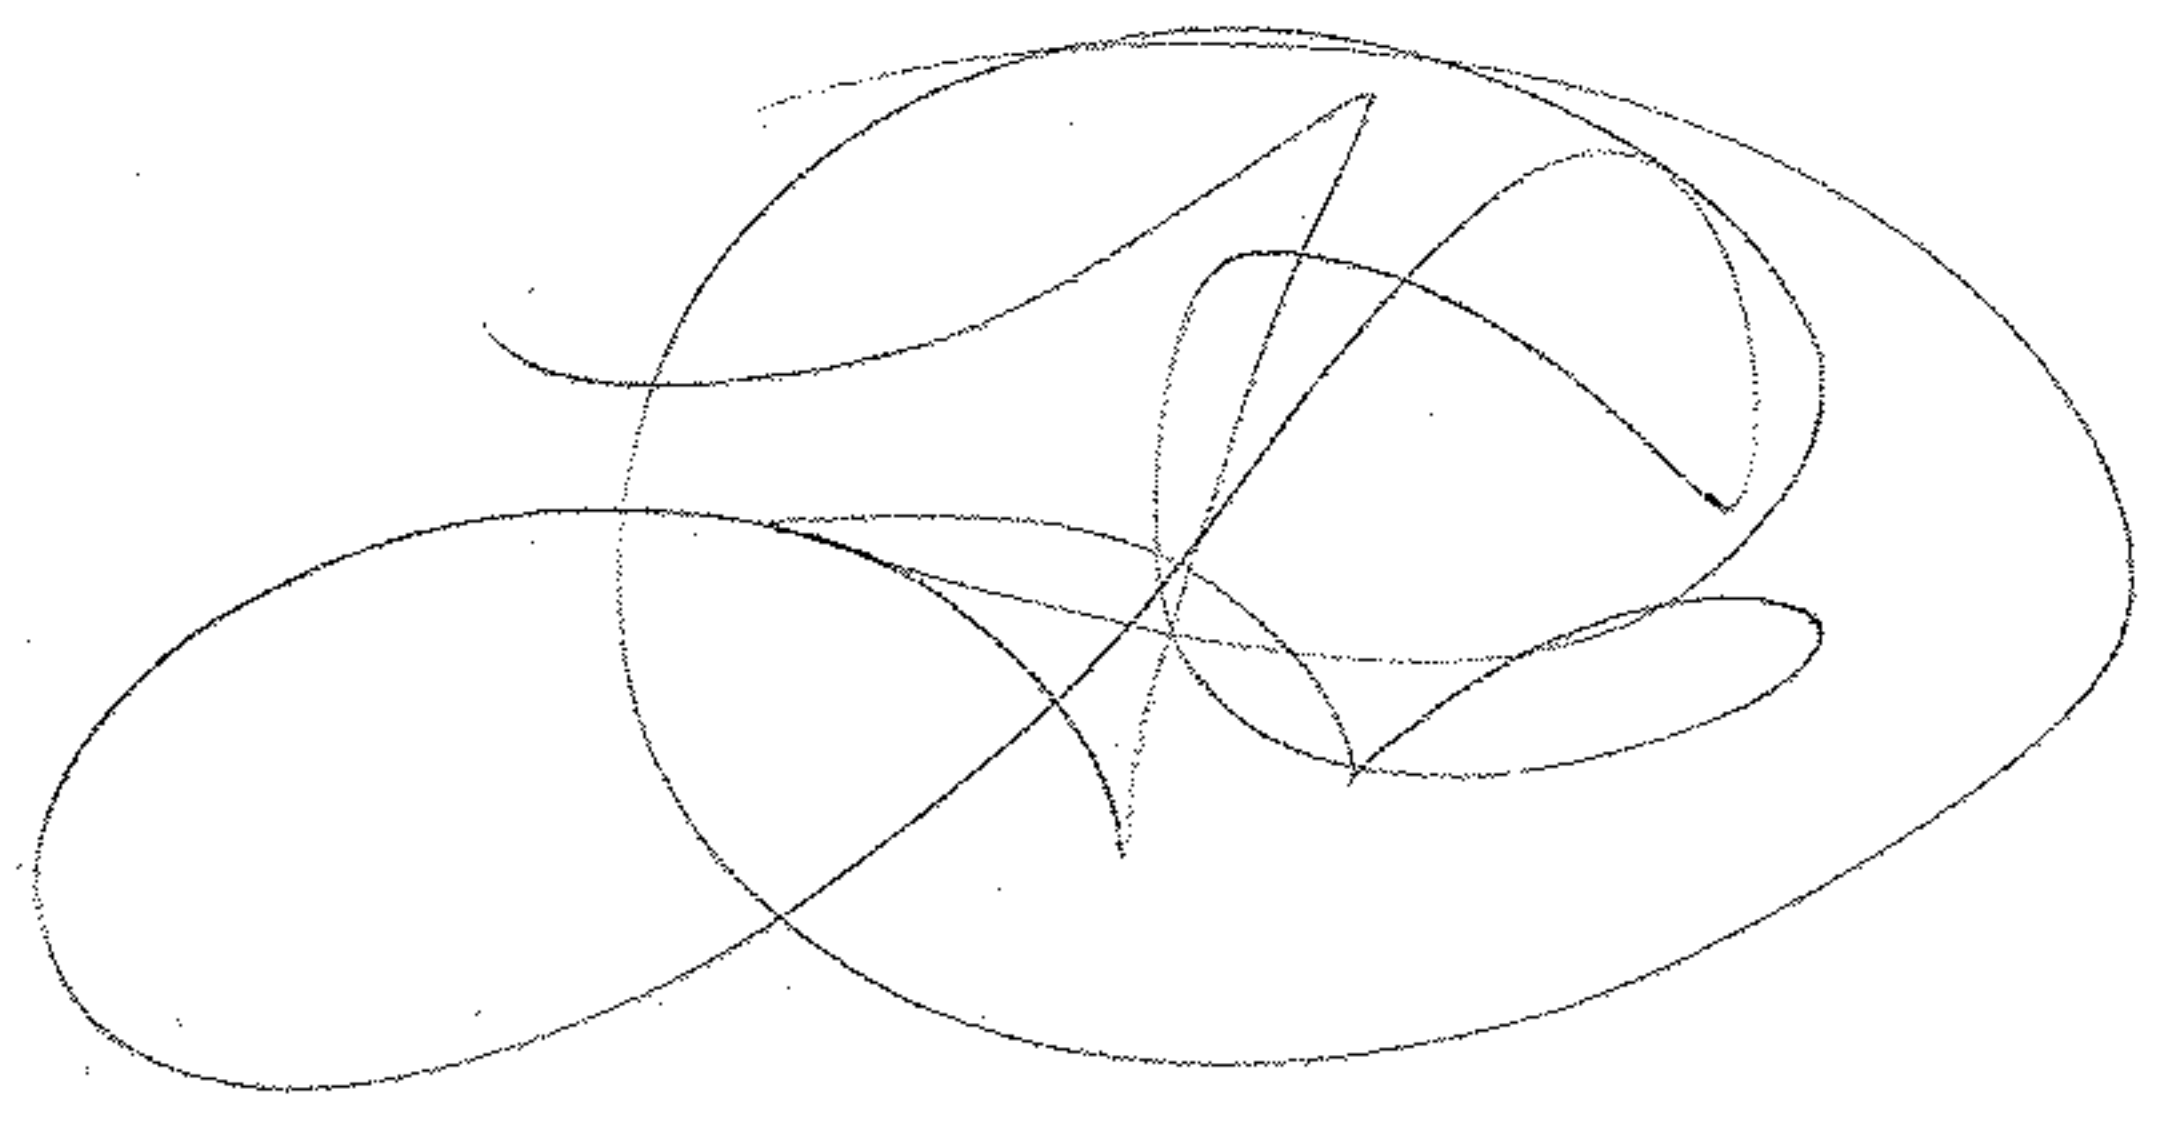

ELYRIA TWP.

SCALE: 1" = 100'

BRACE TRACT
WEST OF RIVER

S. CENTER PT. LOT II
NW ly PT. LOT 37
W ly PT. LOT 38

Copyright 1963
Revised 11-12-71

6-42