5482

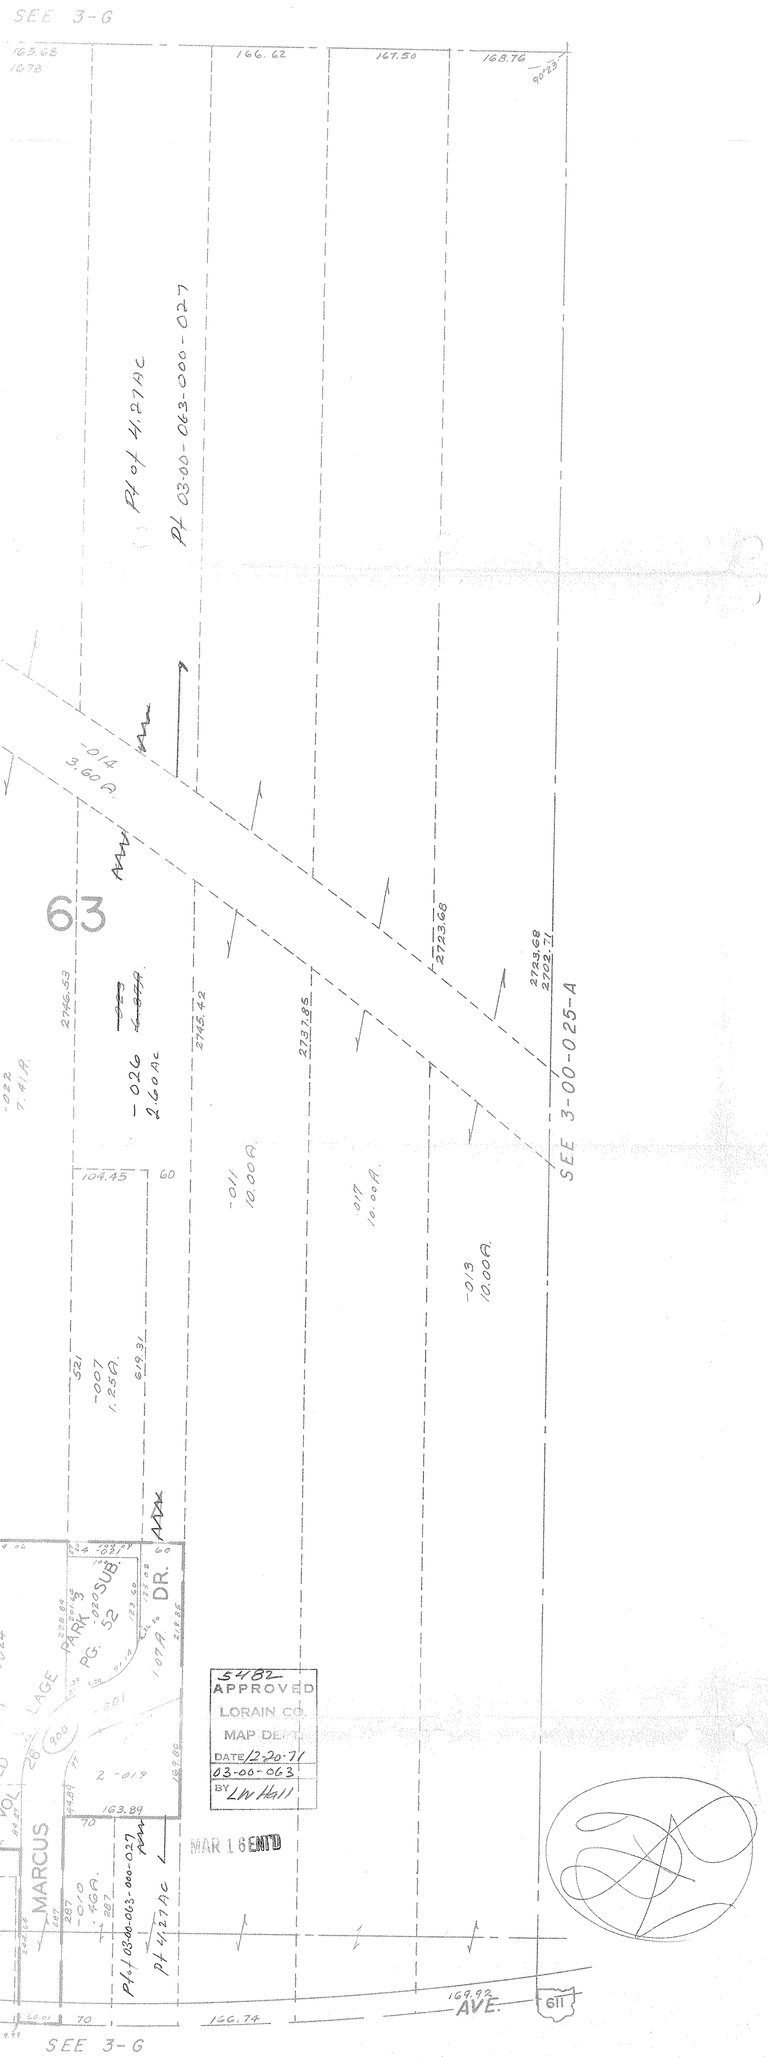

Copyright 1964
REV. 11-12-71

LOT 63

3-00-063