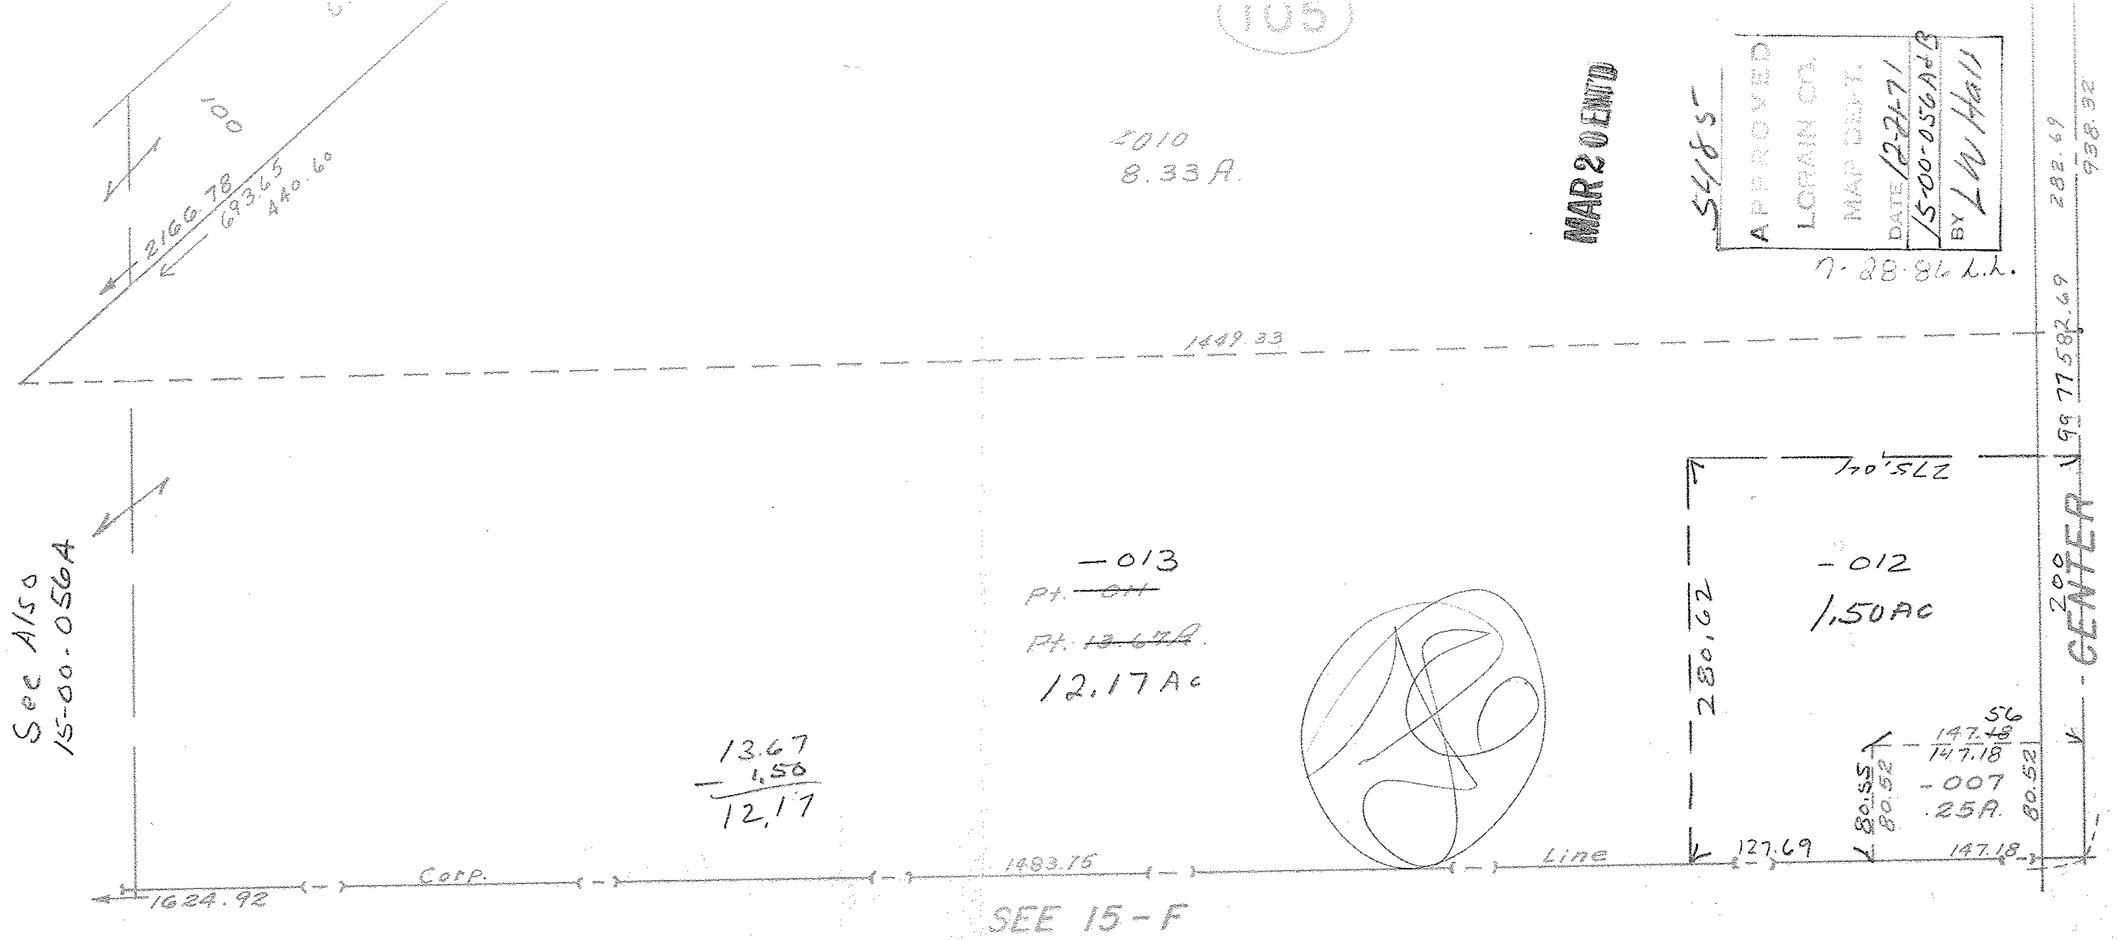

LAGRANGE TWP.

SCALE: 1" = 100'

E. 1/2 LOT 56

15-00-056B

15-