5490

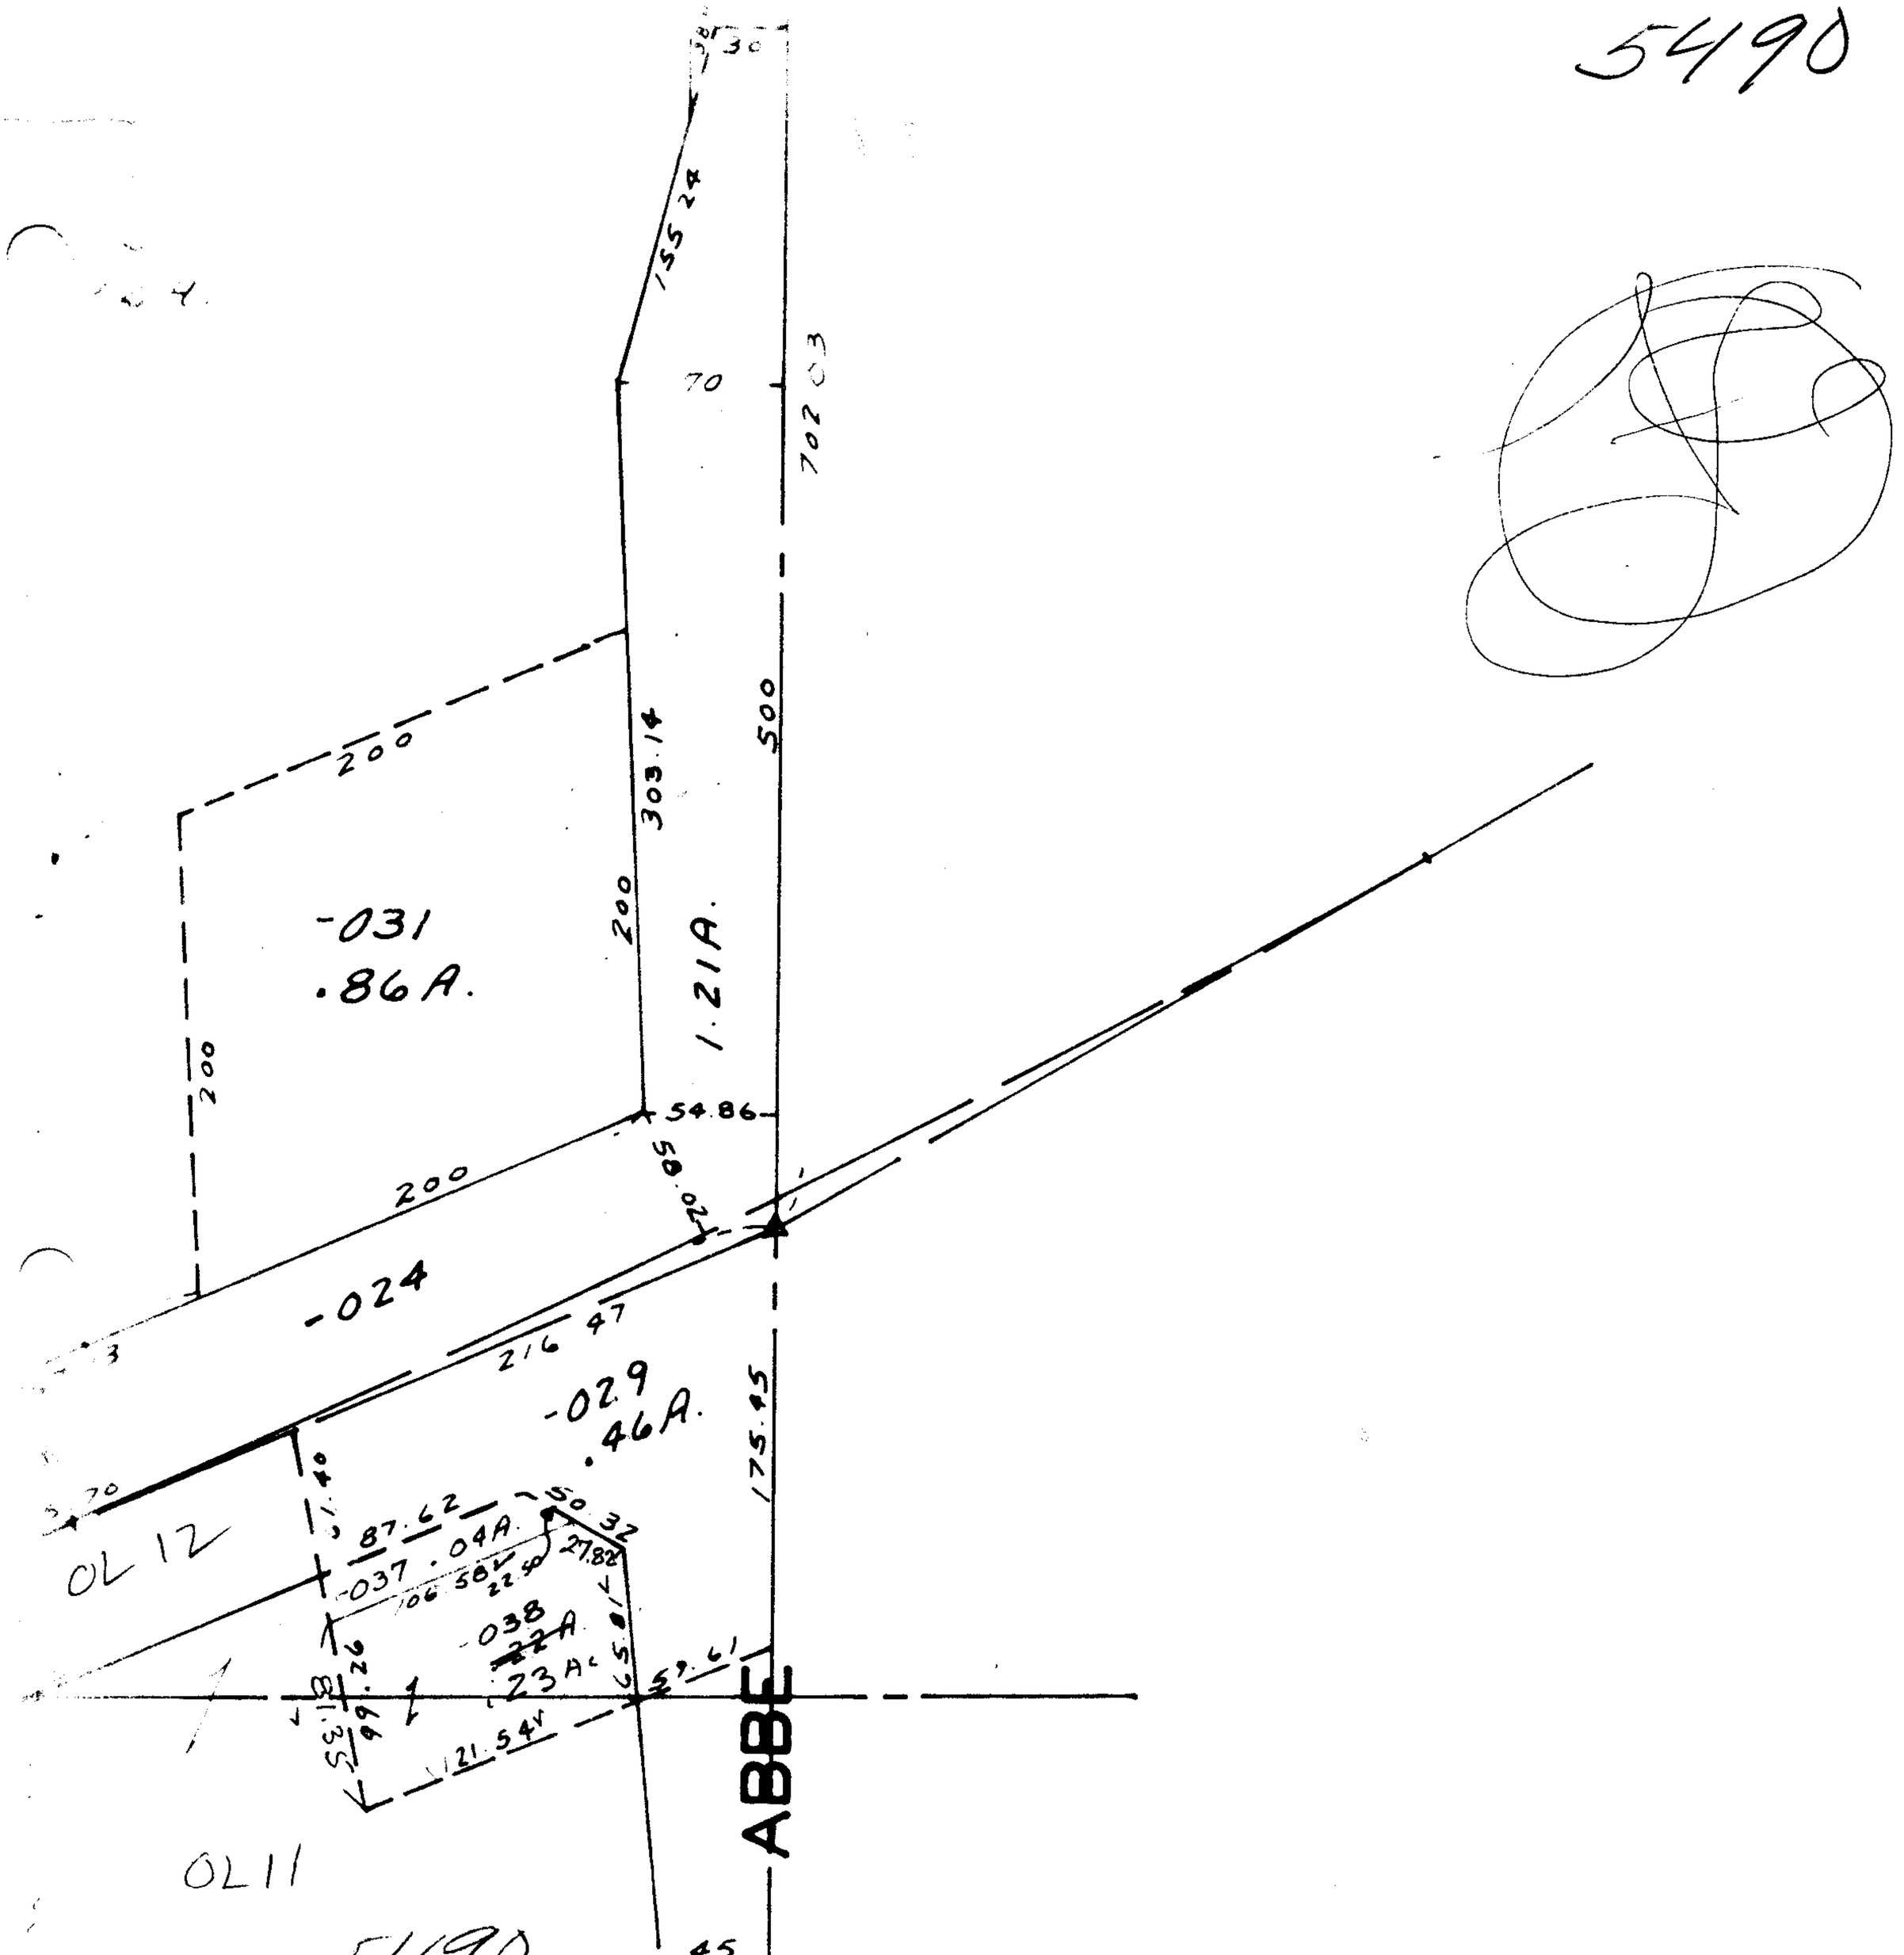

5490

APPROVED
LORAIN CO.
MAP DEPT.
DATE 12-22-71
3-00-012 B
BY LW Hall

12

JAN 26 REC'D

REVISED

3-00-012-B