


12.11
 3.54
 8.57

3-00-053-A.
 SEE 2-00-051-B

5499

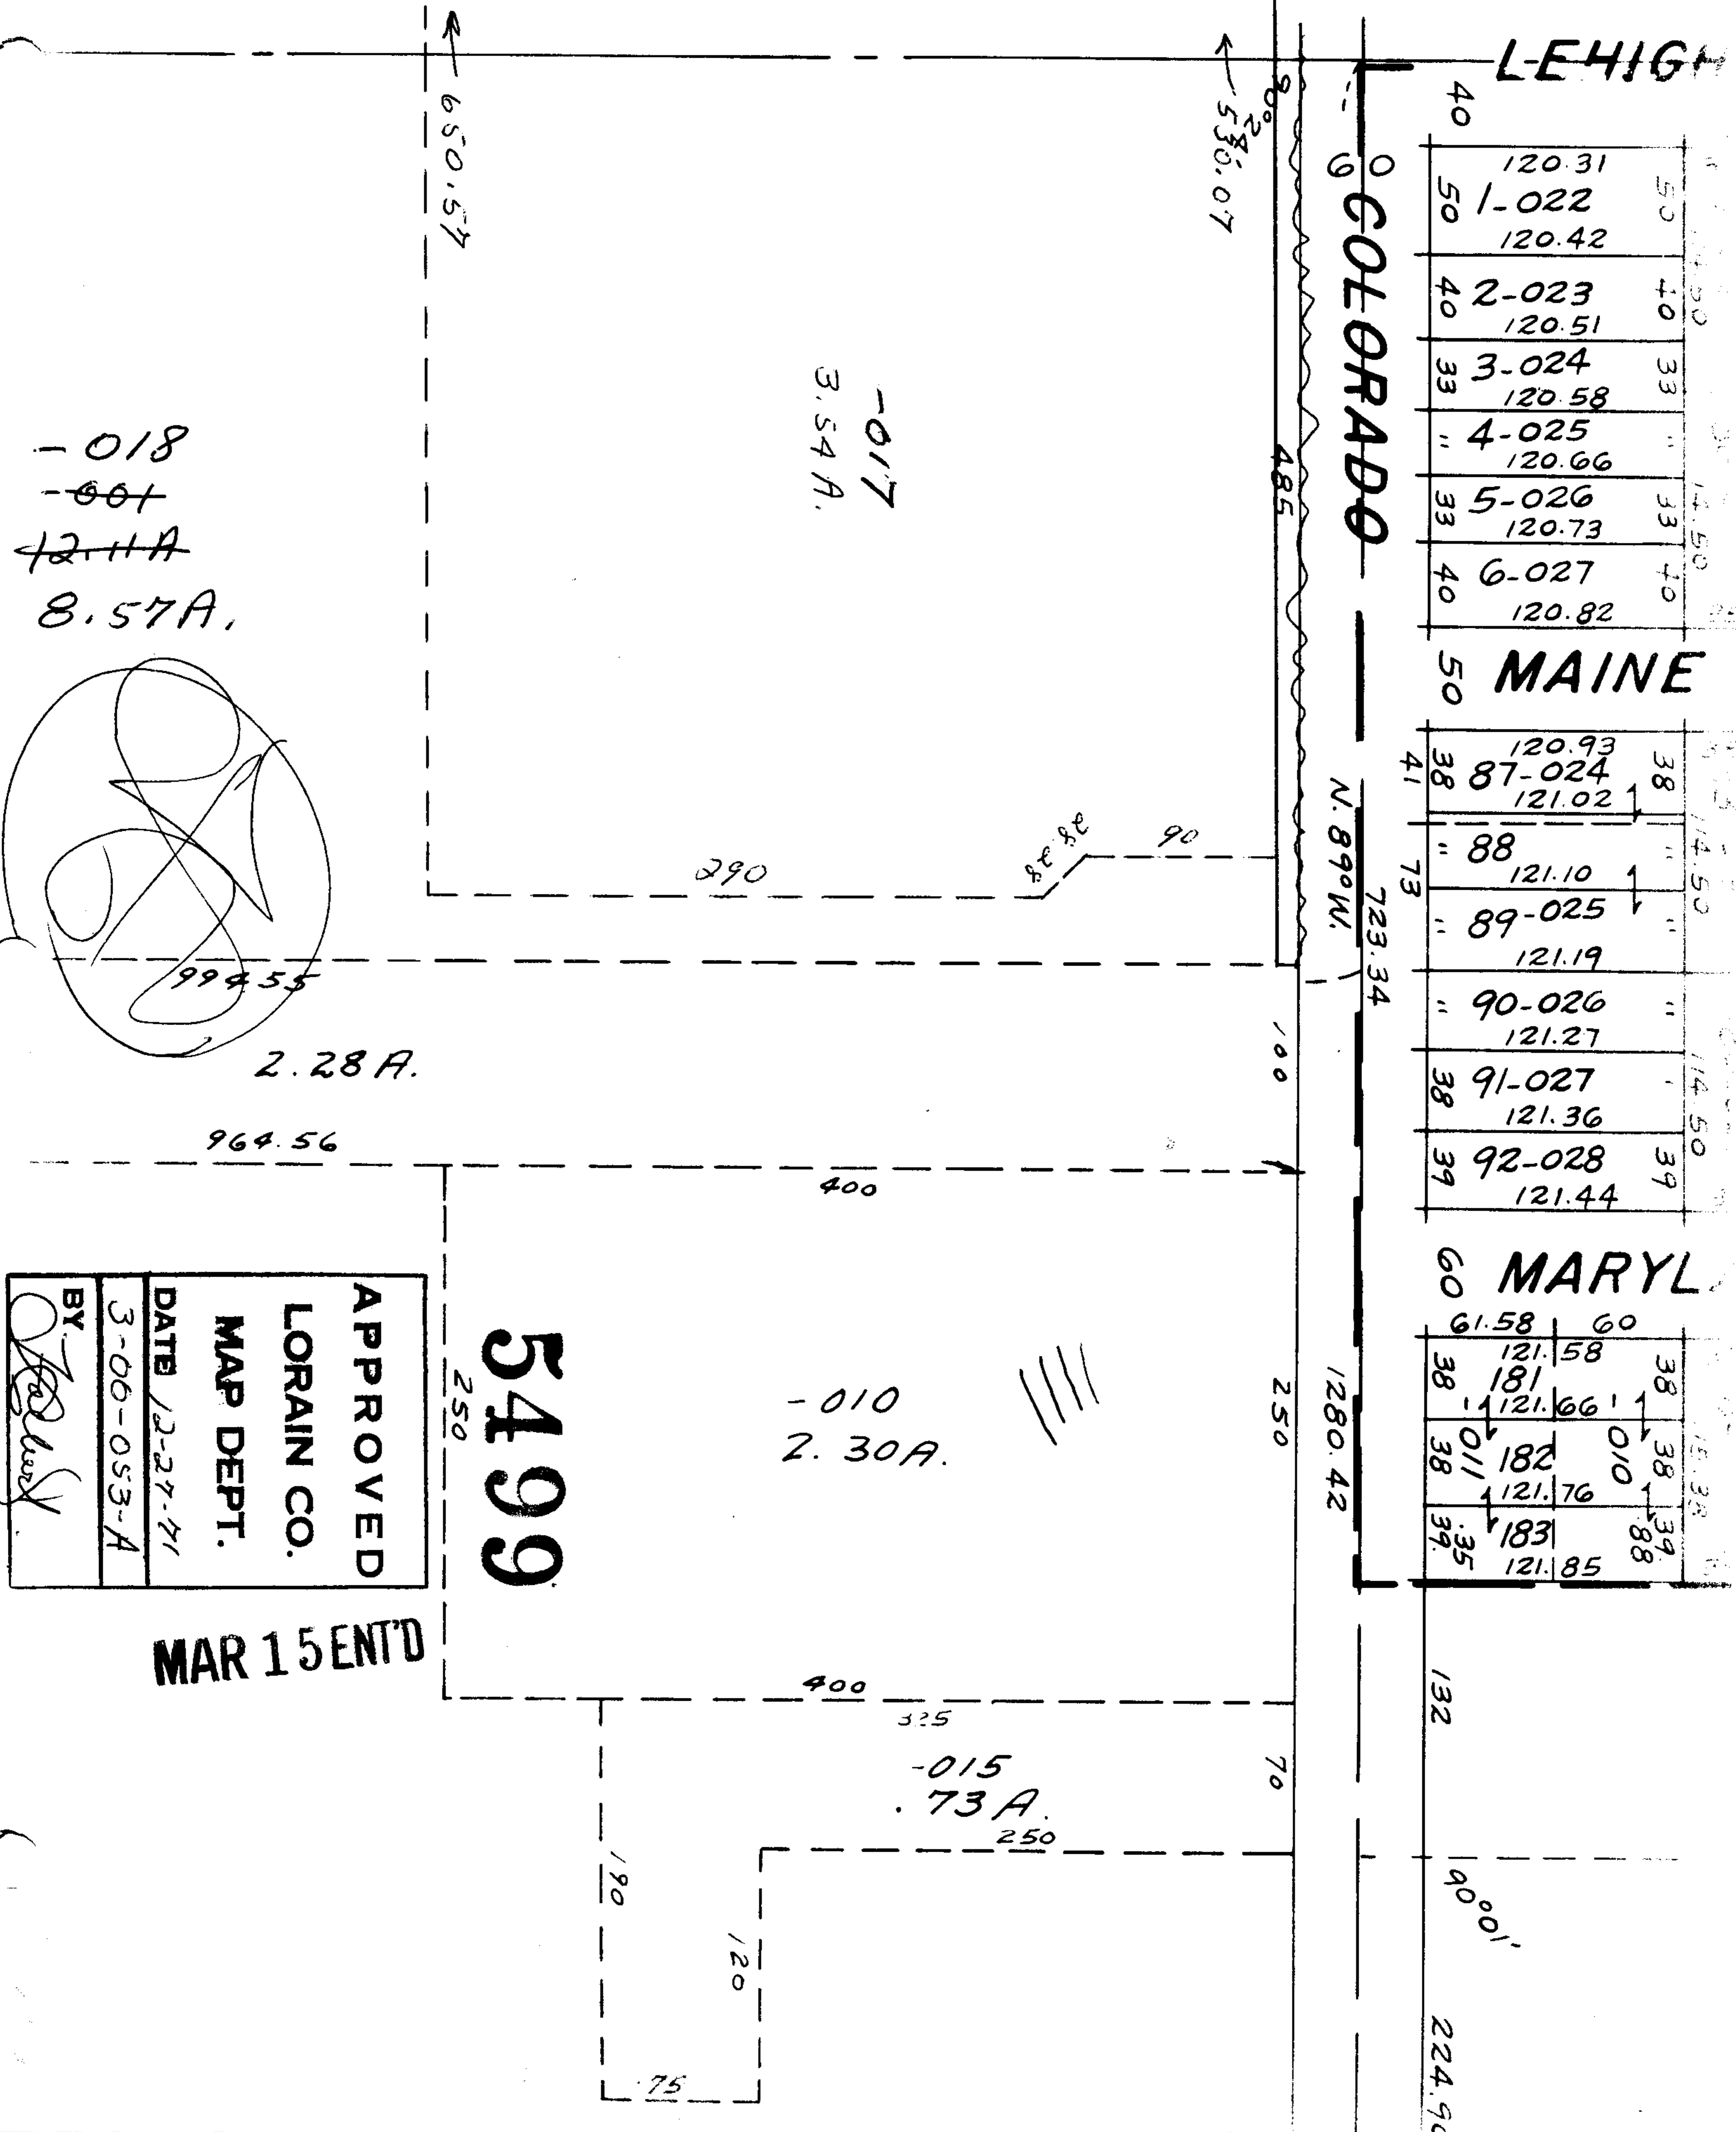

LEHIGH	
40	120.31
50	1-022
	120.42
40	2-023
	120.51
33	3-024
	120.58
"	4-025
	120.66
33	5-026
	120.73
40	6-027
	120.82
MAINE	
50	120.93
38	87-024
	121.02
"	88
	121.10
"	89-025
	121.19
"	90-026
	121.27
38	91-027
	121.36
39	92-028
	121.44
MARYL	
60	61.58
38	121.58
	181
	121.66
38	182
	121.76
39	183
	121.85

APPROVED
 LORAIN CO.
 MAP DEPT.
 DATE 12-27-71
 3-00-053-A
 BY [Signature]

MAR 15 ENT'D

5499

-010
 2.30A.

-015
 73A.

-018
 -001
 12-11A
 8.57A.

-017
 3.54A.