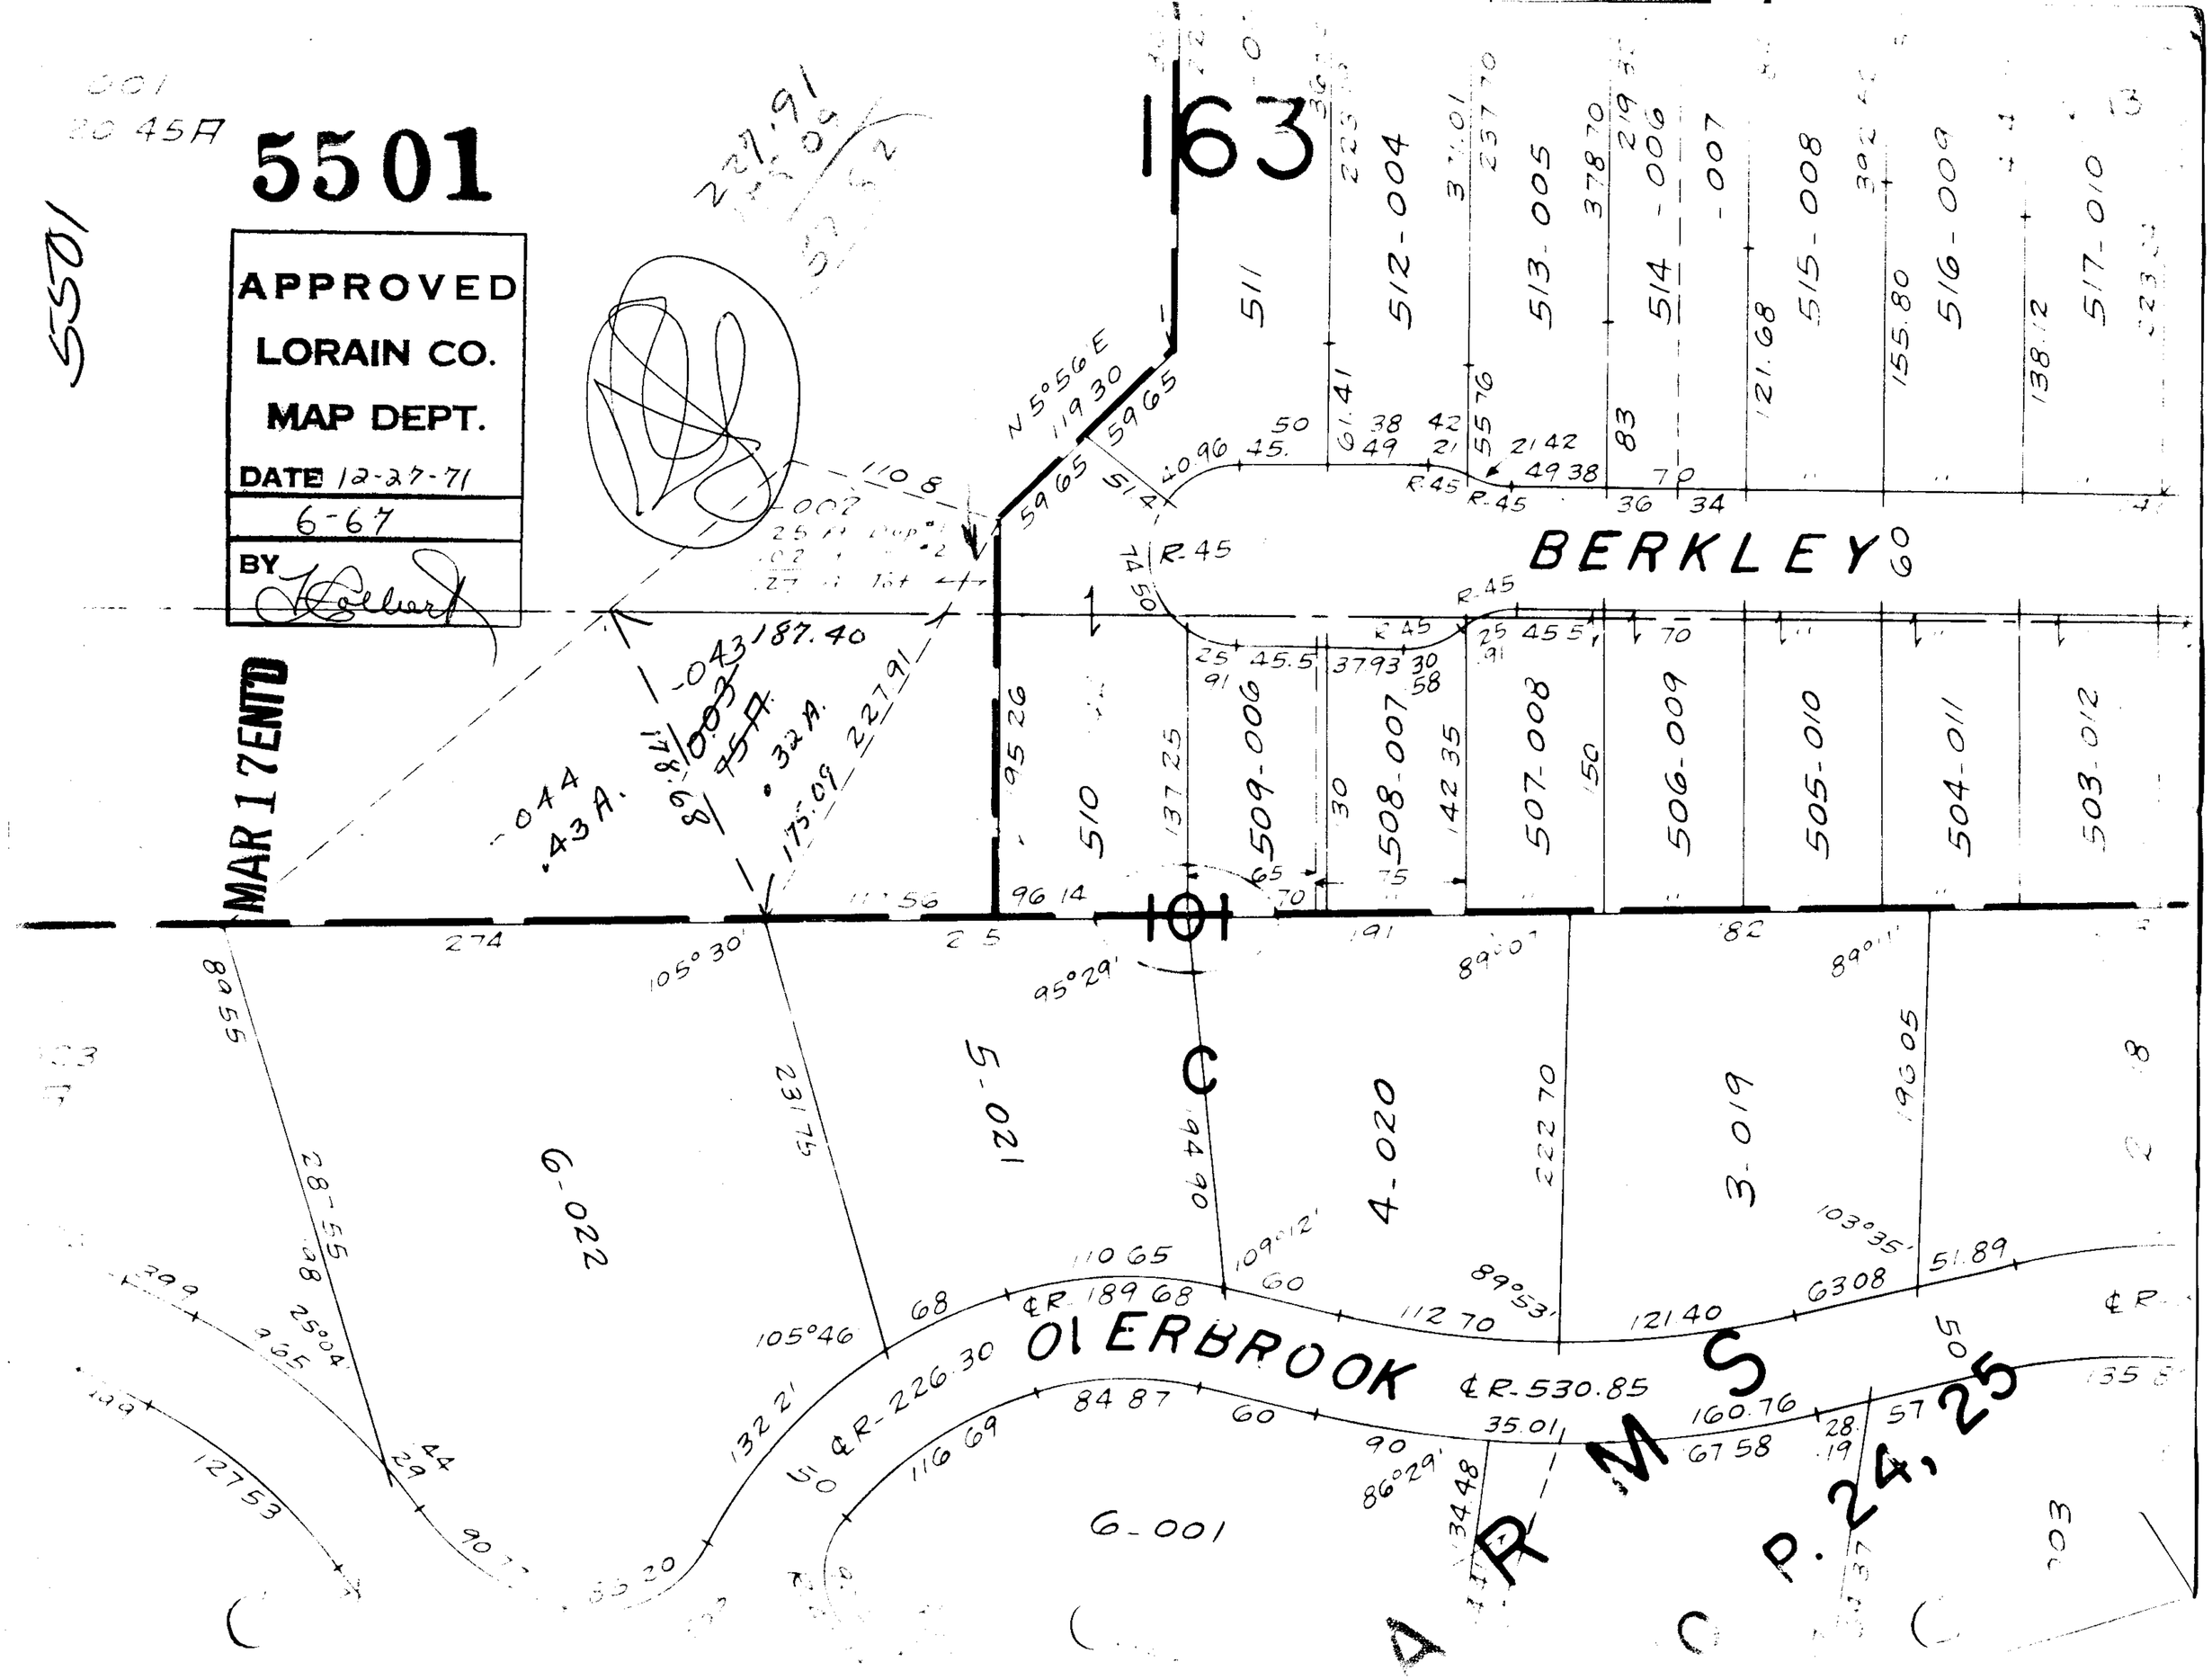
5501
APPROVED
LORAIN CO.
MAP DEPT.
DATE 12-27-71
6-67
BY
MAR 17 ENTD
163
BERKLEY
OLERBROOK
ARMS
P. 24, 25
511
512-004
513-005
514-006
515-008
516-009
517-010
510
509-006
508-007
507-008
506-009
505-010
504-011
503-012
6-022
5-021
4-020
3-019
6-001
N 5°56' E
119.30
59.65
105°30'
95°29'
105°46'
89°53'
103°35'
86°29'
℄R-226.30
℄R-189.68
℄R-530.85
R-45