
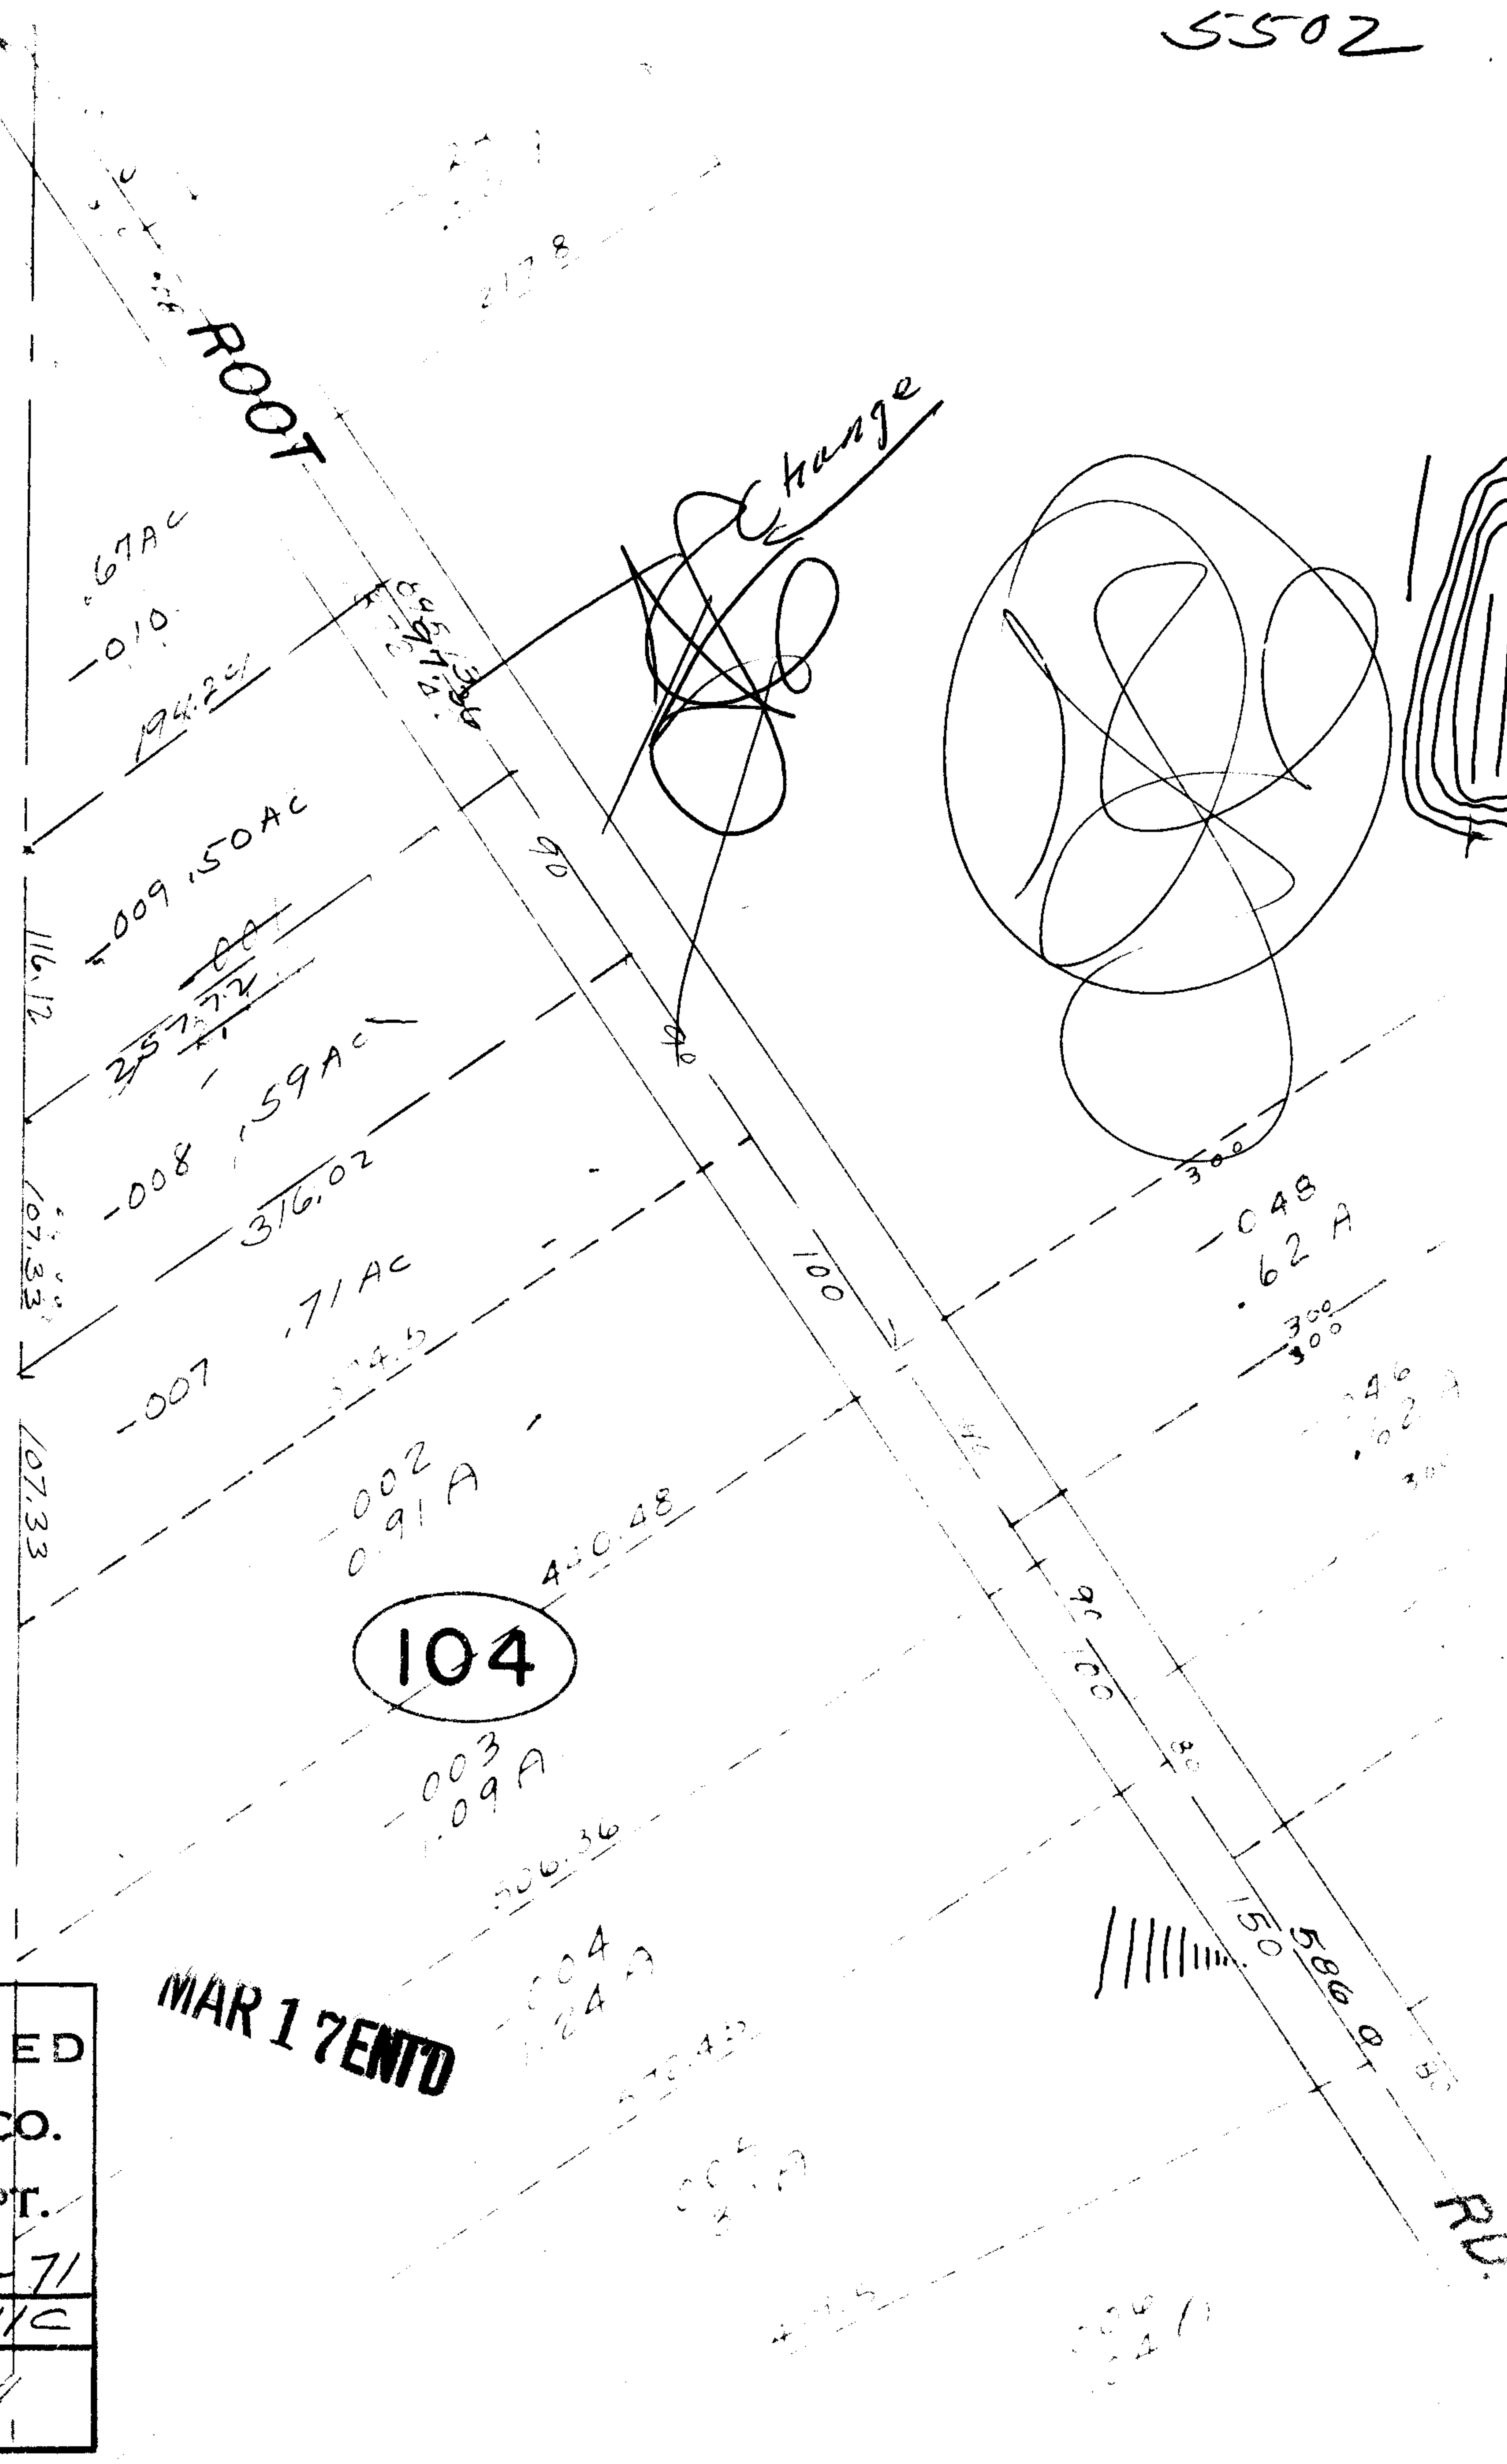


5502

ROOT

Change

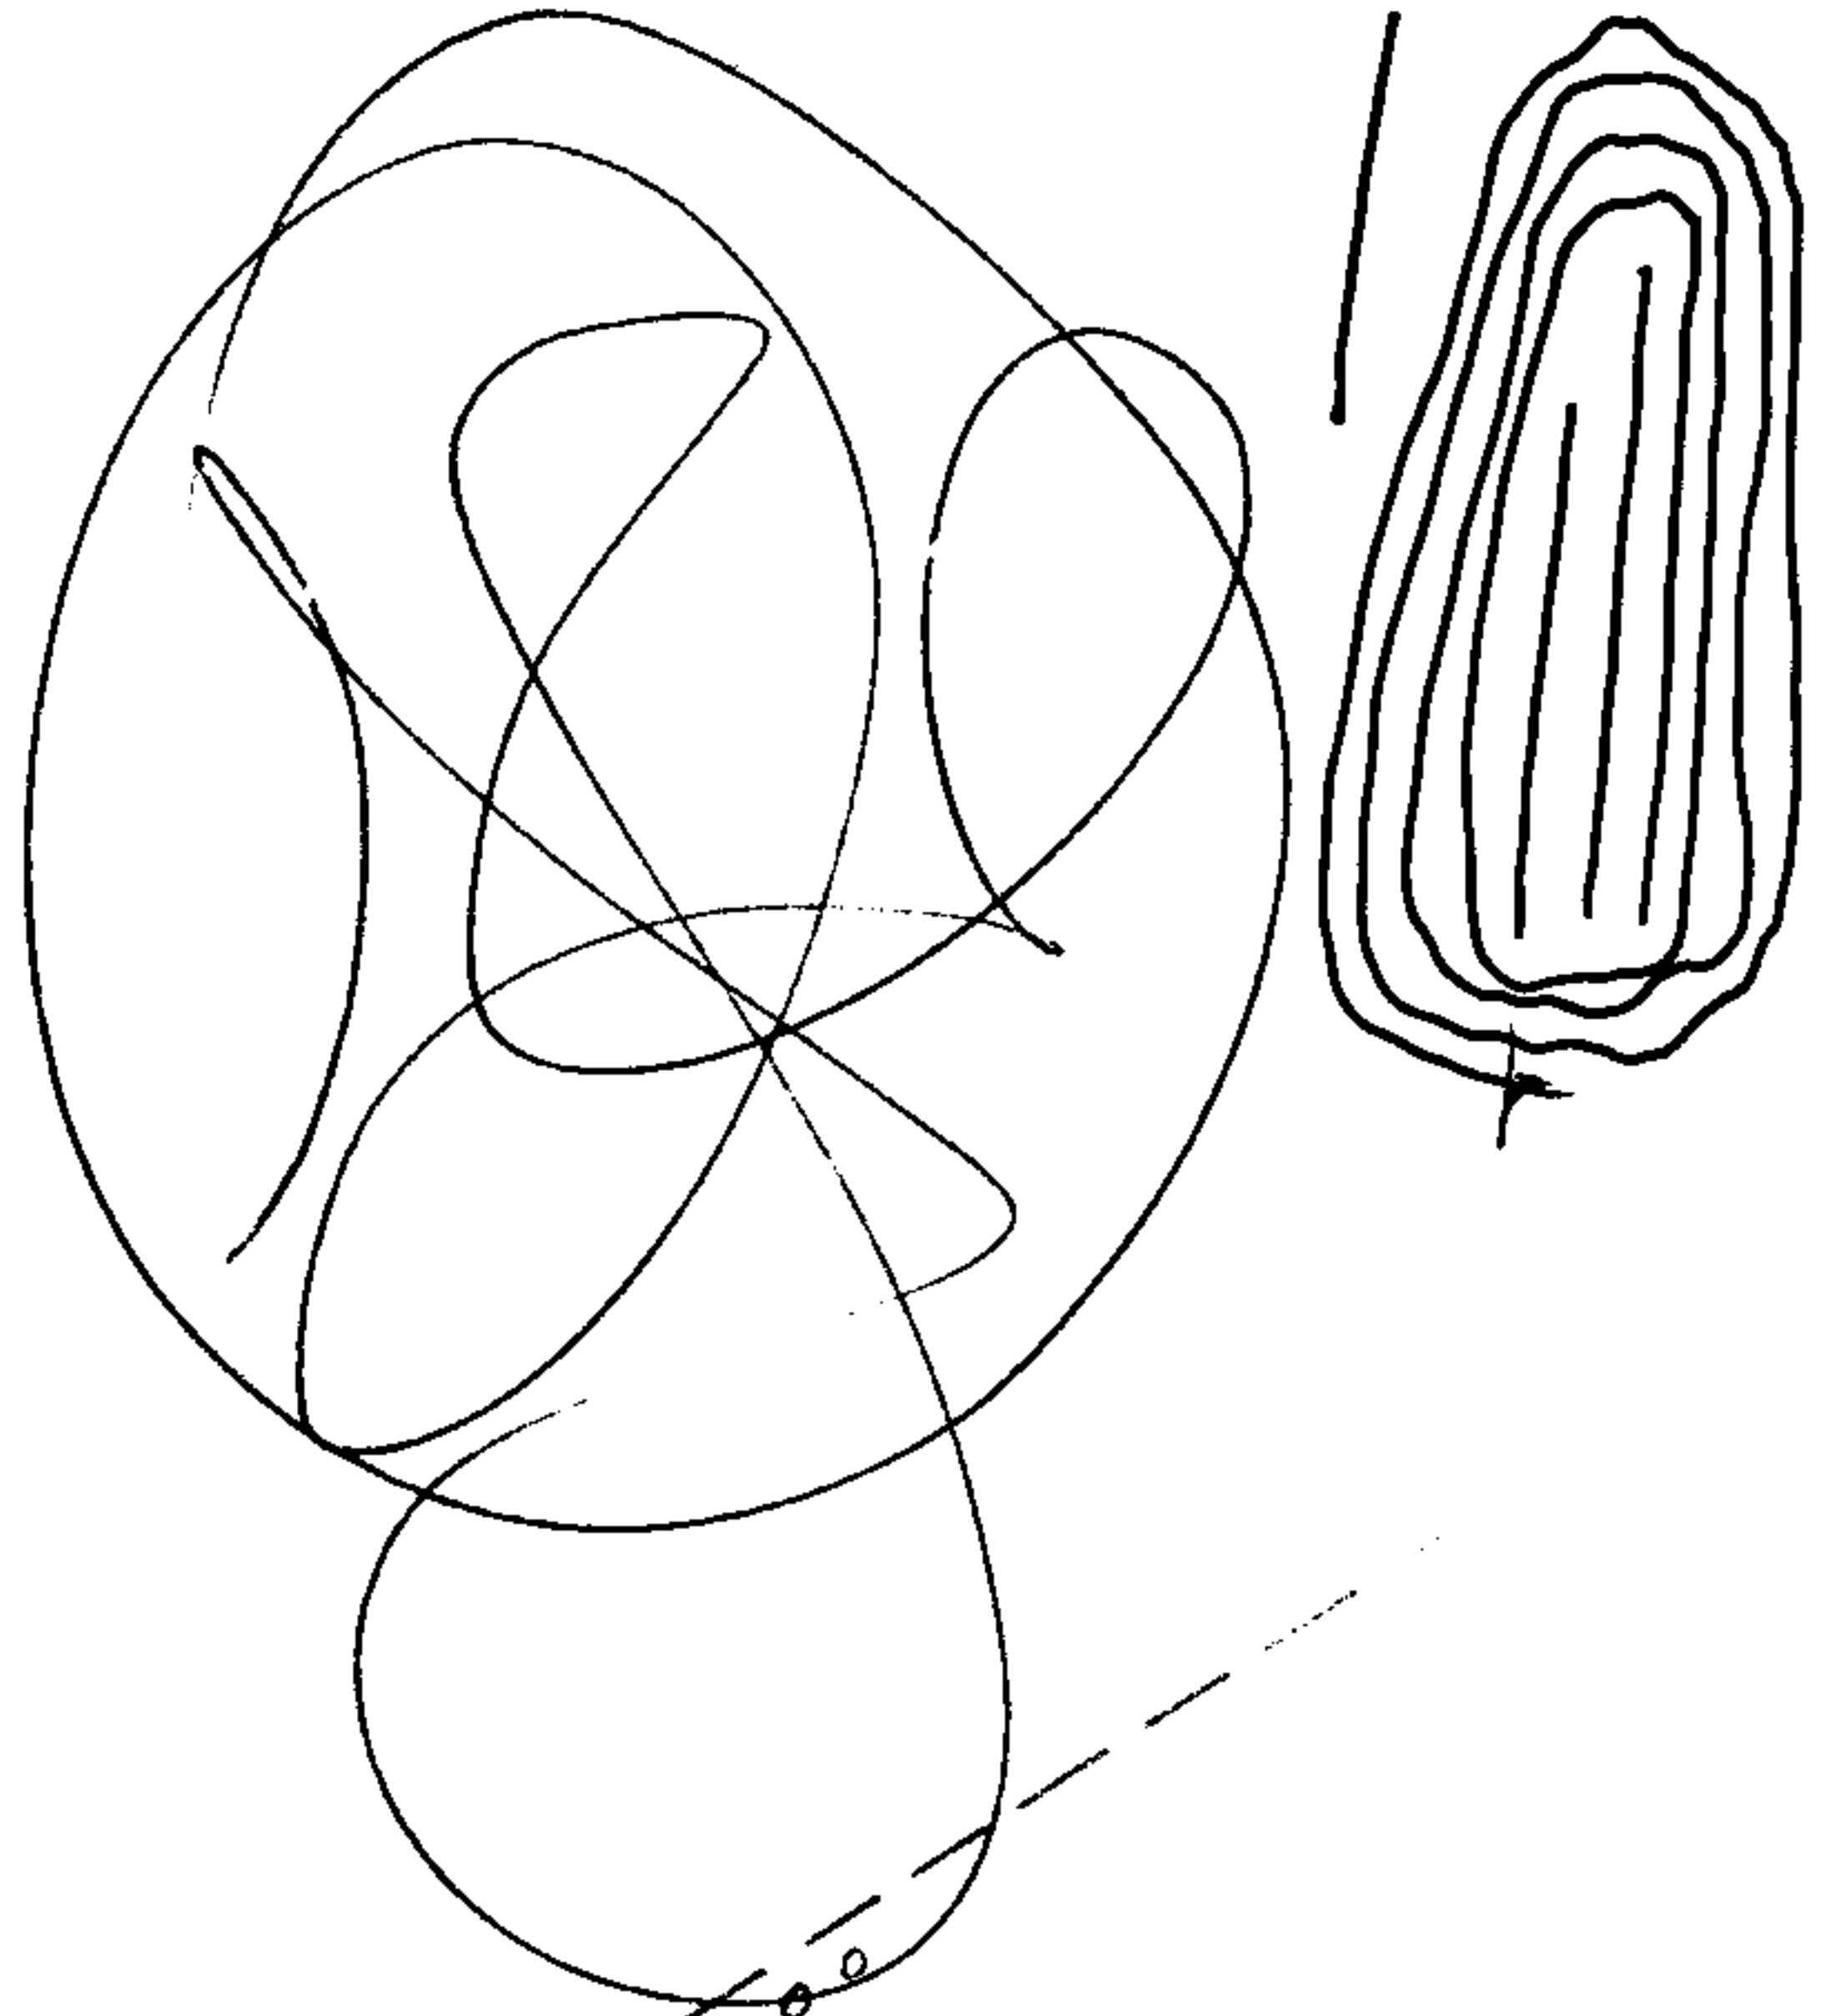

104

MAR 17 1971

5502

APPROVED
LORAIN CO.
MAP DEPT.
DATE 12-27-71
07-00-011C
BY L.W. Hall