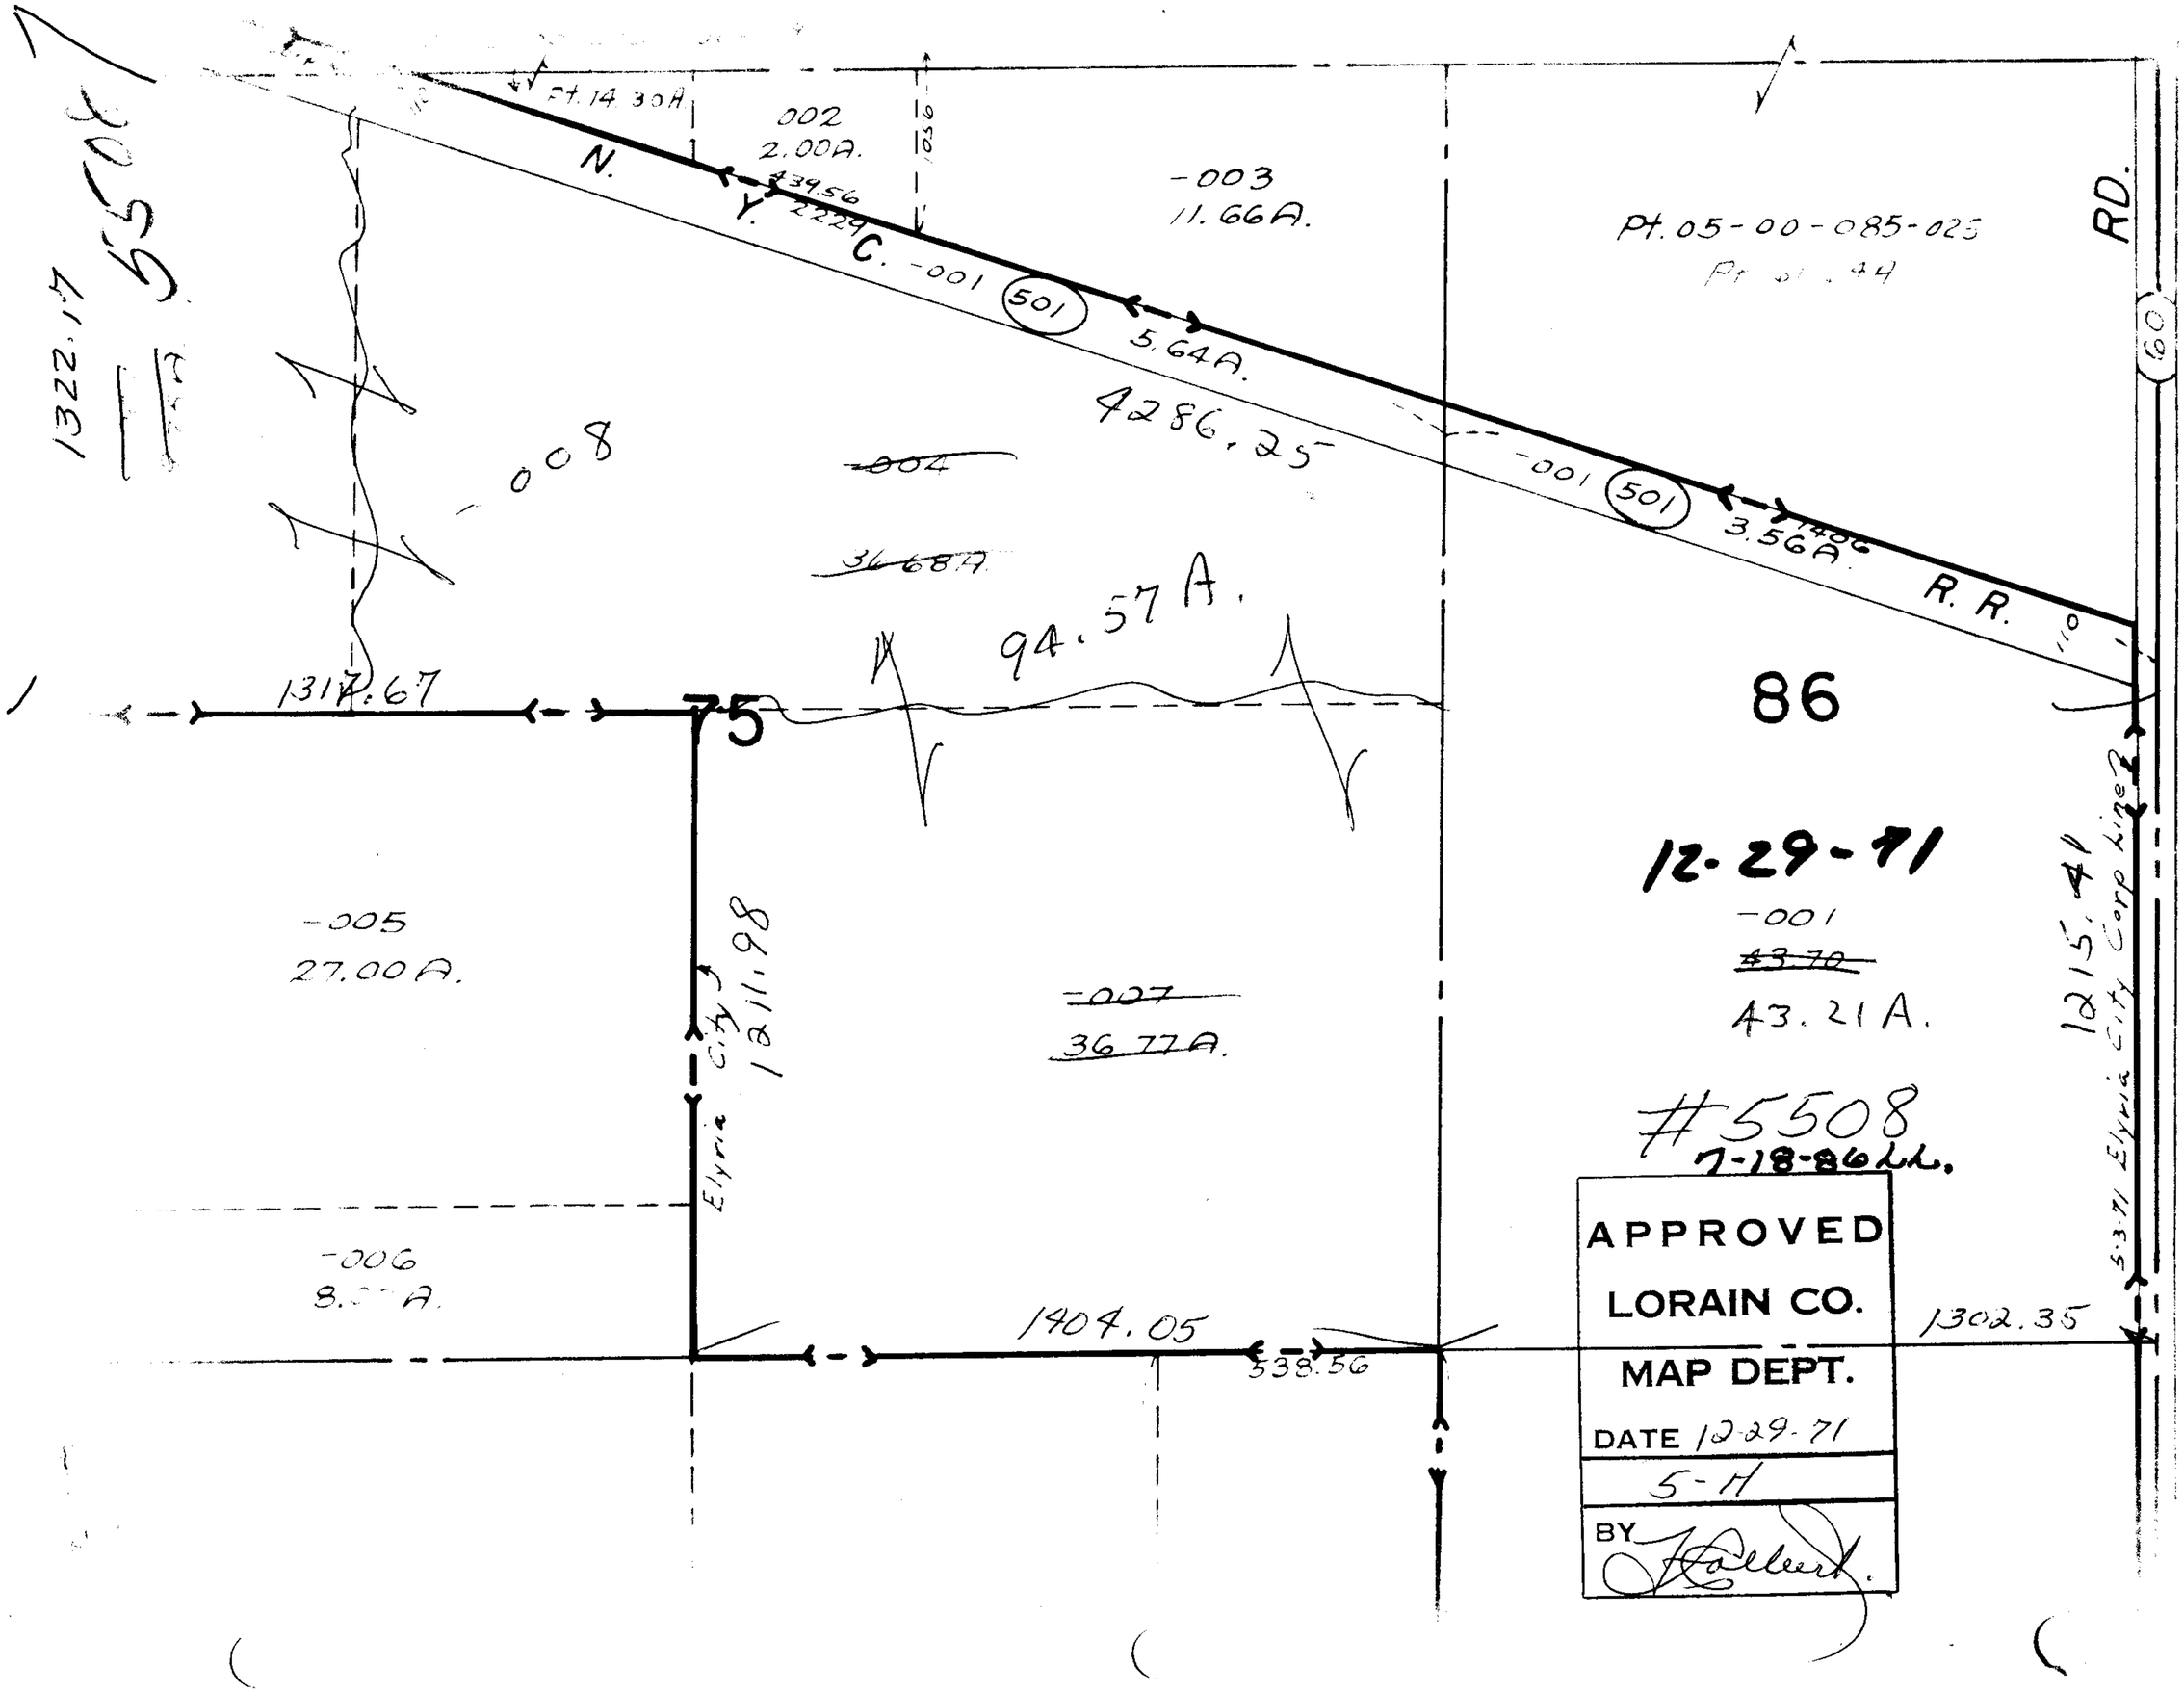

1322.17
5508
Pt. 14.30A.
002
2.00A.
439.56
2229
N.
Y.
C.
-001
501
5.64A.
4286.25
-003
11.66A.
Pt. 05-00-085-025
RD.
60
-001
501
3.56A.
R. R.
-008
~~-004~~
~~36.68A.~~
94.57 A.
1317.67
75
86
12-29-71
-001
~~43.70~~
43.21 A.
1215.41
5-3-71 Elyria City Corp Line
-005
27.00 A.
Elyria City
1211.98
~~-007~~
~~36.77A.~~
#5508
7-18-86 LL.
-006
8.[illegible] A.
1404.05
538.56
1302.35
APPROVED
LORAIN CO.
MAP DEPT.
DATE 12-29-71
5-H
BY