


MAP

5510

MAR 17 1986

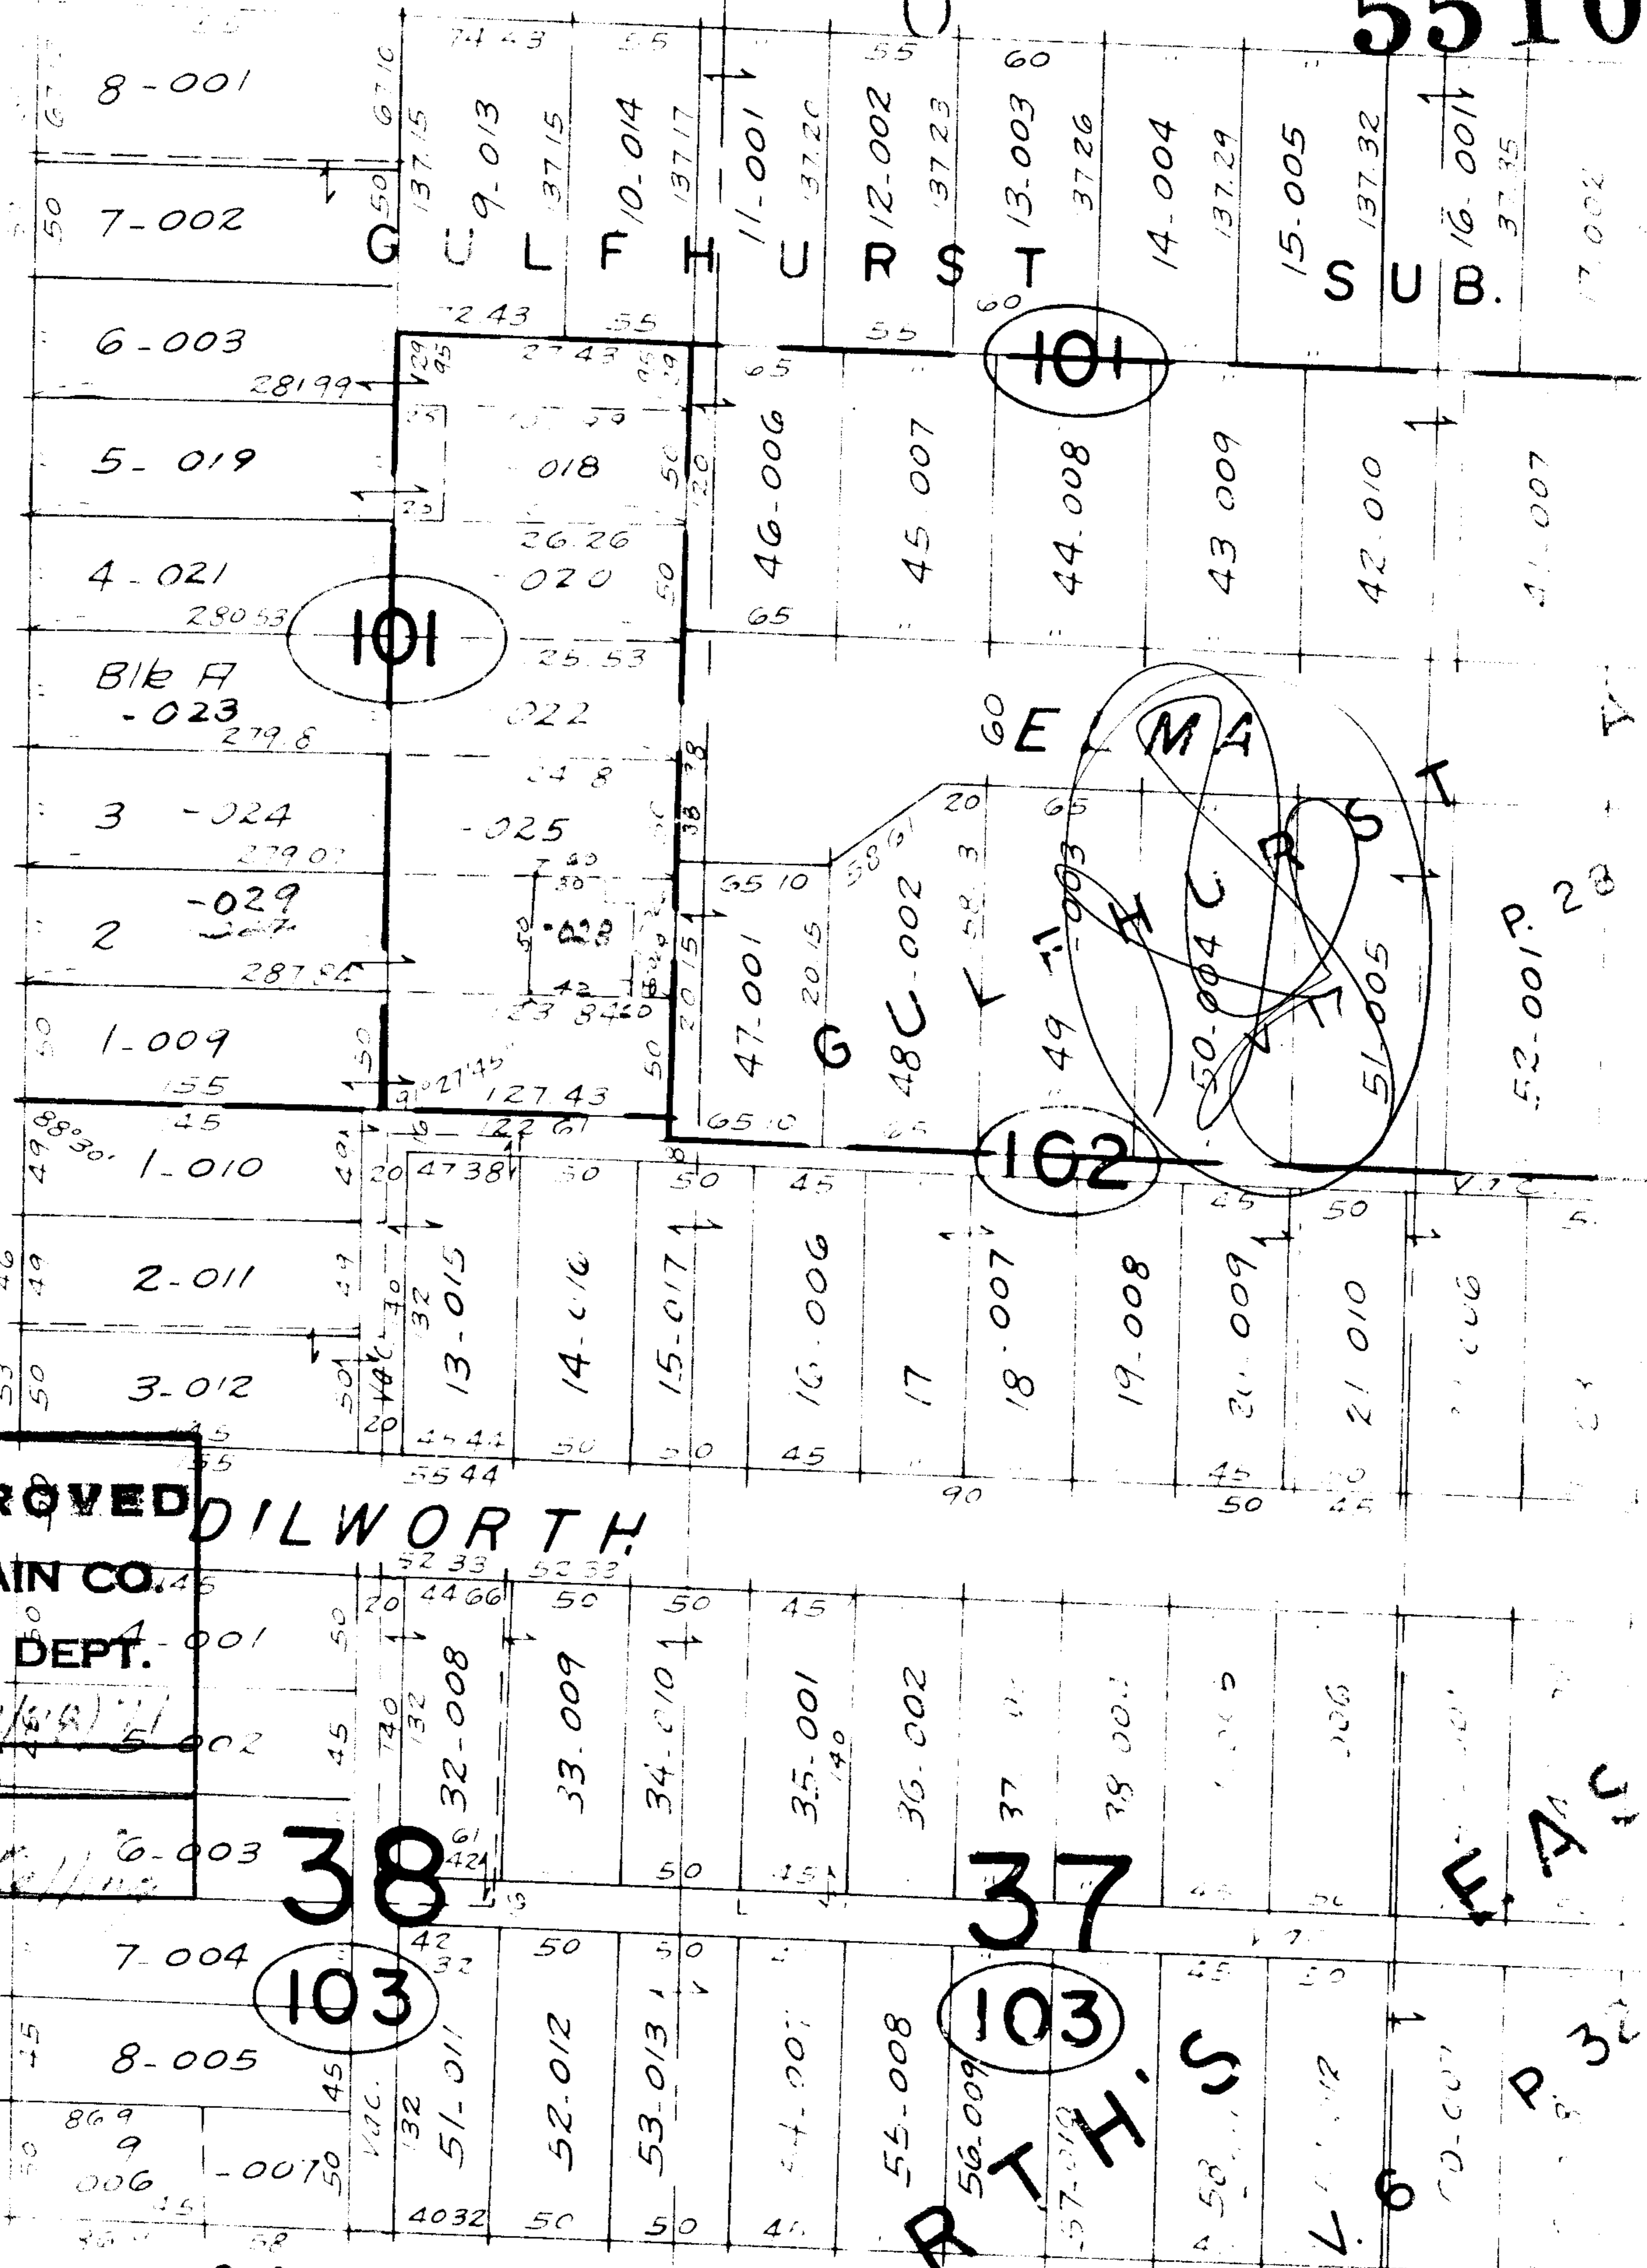

APPROVED
LORAIN CO.
MAP DEPT.
 DATE 12/8/85
 6-86
 BY R. V. [Signature]

DILWORTH

38

37

103

103

CAROLINE

W O R T H

E. M. A. H. C. P. S. T.